

Township 26S Range 9W Sec. 2 County DOUGLAS

State OR Date 7/30/92 No. \_\_\_\_\_

AUG 3 1992

COUNTY SURVEYOR  
DOUGLAS COUNTY, OREGON

Corner Designation

S3 | S2  
S10 | S11

- \_\_\_\_\_ Condition Report Only
- \_\_\_\_\_ Not Found
- Renewed
- \_\_\_\_\_ Unrecorded
- \_\_\_\_\_ Surveyed In
- \_\_\_\_\_ Referenced Out

Previous Renewals # 10

Monument(s) Found: (Condition and Source)

A 1" O.D. IRON PIPE PROTRUDING  
7" ABOVE GROUND (SET BY  
WEYERHAEUSER CO.)

N/A

Accessories Found:

BT FROM REN #10

8" NOW 12" DIA 3FT HIGH HEMLOCK STUMP, WITH A FULLY HEALED SINGLE BLAZE, BEARS N46°W, 6.1 FT (REC N37°W 6.1 FT)

24" NOW 18" DIA 3FT HIGH MADRONE STUMP WITH A PREVIOUSLY OPENED ROTTED BLAZE, BEARS N66°E, 5.5 FT (REC N76°E 5.5 FT)

18" NOW 18" DIA 2FT HIGH O. FIR STUMP, ROTTED SHOWS OLD AXE MARKS AND "W" NAIL LAYING ALONG STUMP, BEARS S13°E 26.1 FT (REC S13°E 25.0 FT)

SW BT FROM REN #10 IS GONE

#284

RENEWAL

Monument Set (Procedure and Description)

Monument Detail

NONE


N/A

New Accessories

18" DIA. 2 FT HIGH D. FIR STUMP WITH BOATS SPIKE SET THROUGH  
BT TAG NEAR CENTER OF STUMP, BS BEARS S50°E 26.7 FT

Sketch of Monument, Accessories, and General Area

CLEAR CUT

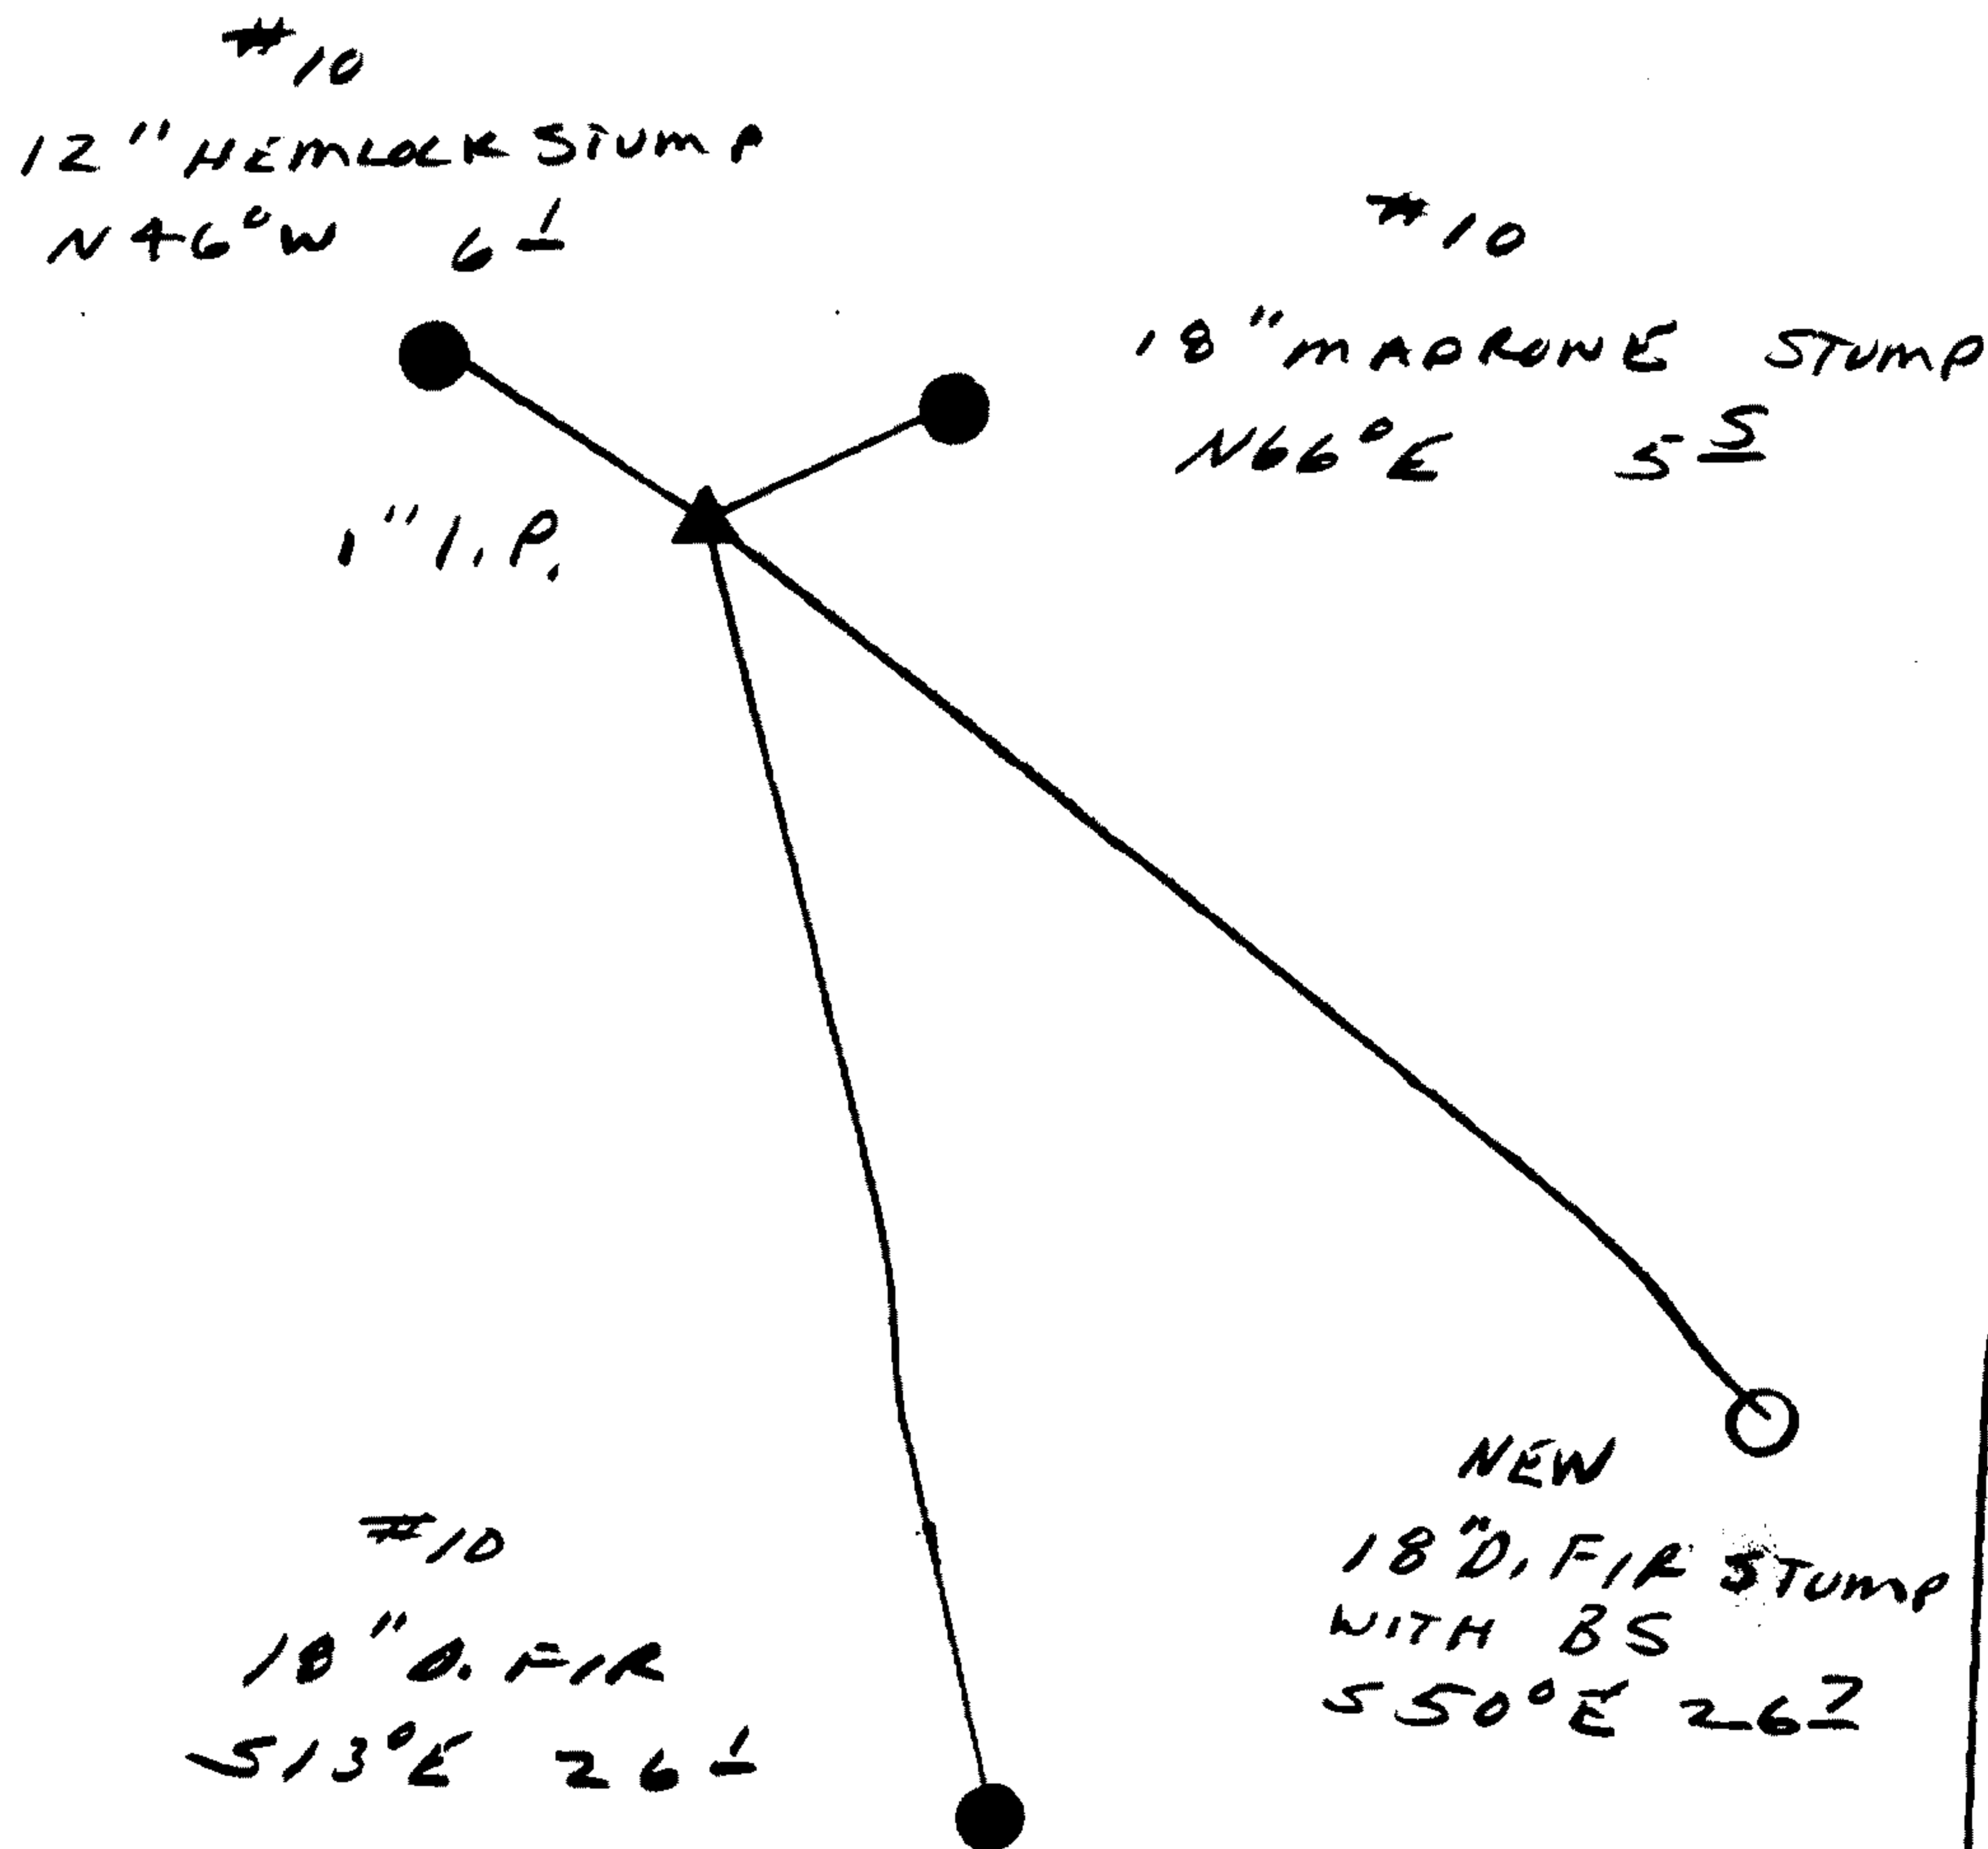


Location & Comments

CORNER IS APPROX 40 FT  
NORTH OF A GRAVEL ROAD  
AND 10' EAST OF A CAT ROAD  
IN A CLEAR CUT.

Comp. Declin. 18°E  
Agency DCSO  
Party Chief RANDALL W SMITH  
Notekeeper Randall W Smith  
Witnesses STEPHEN J FLAUS

Address

Surveyor's Seal

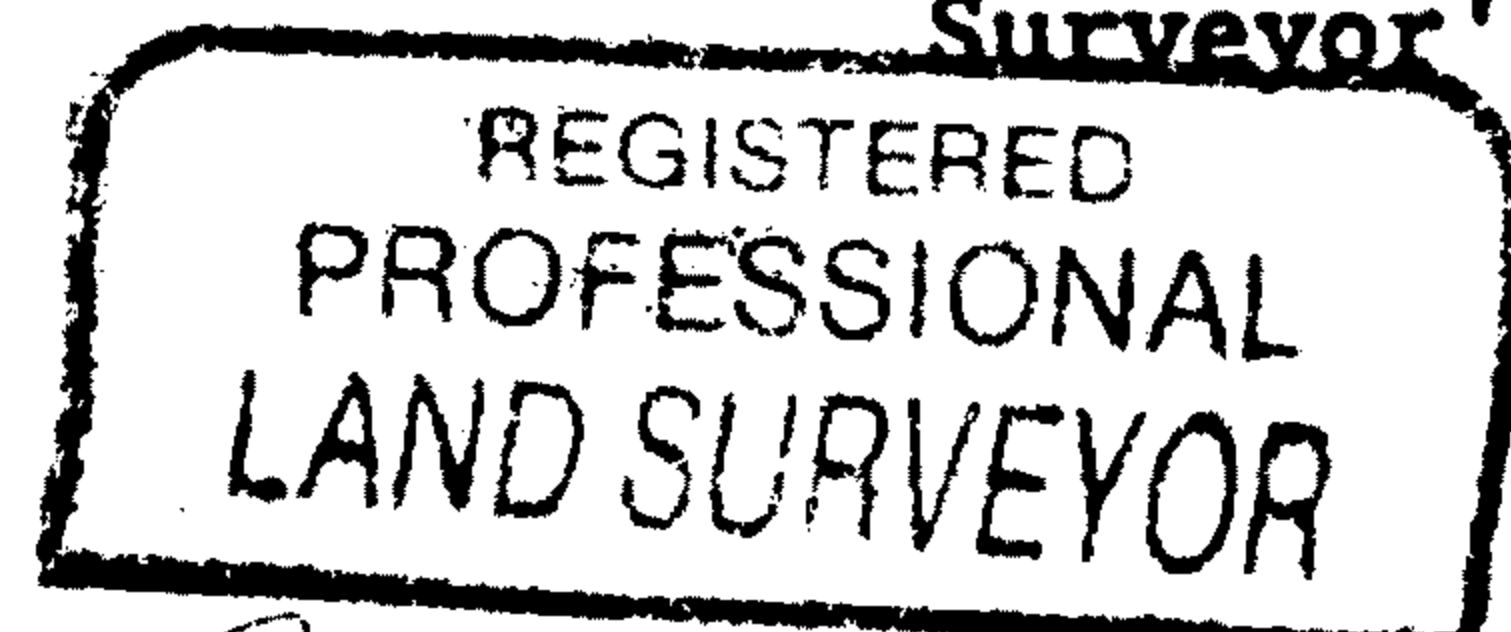

*Randall W Smith*

