

GOVERNMENT CORNER RESTORATION FORM

FILED

Township 24S Range 8W Sec. 4 County DOUGLAS

AUG 5 1992

State OR Date 8/3/92 No. _____

Corner Designation _____

COUNTY SURVEYOR
DOUGLAS COUNTY, ORE.

$\frac{1}{4} \frac{54}{39}$

- _____ Condition Report Only
- _____ Not Found
- Renewed
- _____ Unrecorded
- _____ Surveyed In
- _____ Referenced Out

Previous Renewals #40 #73

MONUMENT DETAIL

Monument(s) Found: (Condition and Source)

1 1/2" IRON PIPE WITH A 1 3/4"
SCREW ON PIPE PLUG BRASS CAP,
PROTRUDES 2" ABOVE GROUND. (REN #73)
EDGE OF STONE VISIBLE ALONG
WEST EDGE OF I.P. MOST OF
STONE UNDER A LOG WE DID NOT
DISTURB (ORIG STONE)

N/A

Accessories Found:

20" NOW 22" DIA 10' HIGH ROTTED FIR SNAG WITH A PREVIOUSLY
OPENED BLAZE, NO SCRIBING VISIBLE BEARS N62°E, 22.0 FT
(REC N62°E 21.1 FT), ORIG BT

16" NOW 14" DIA 9' HIGH ROTTED FIR SNAG WITH A PREVIOUSLY
OPENED BLAZE, NO SCRIBING VISIBLE BEARS N81°E, 18.5'
(REC N86°E, 18.5') ORIG BT

16" NOW 18" DIA 6' HIGH D. FIR STUMP WITH A HEALED
NOTCH NEAR BOTTOM OF TRUNK, BEARS S78°W, 17.0 FT TO CUT STUMP
(REC S78°W 16.1 FT TO NAIL) REN 73
NE BT FROM REN #73 IS GONE

#108 +

C.S. File No. 64/31-3 c

RENEWAL

Monument Set (Procedure and Description)

Monument Detail

NONE

N/A

New Accessories


11" D. FIR DOUBLE BLAZED AND SCRIBED "Y4S4CS BT"
 BEARS N 78 1/2° E 36.9 FT.

4" D. FIR DOUBLE BLAZED AND SCRIBED "X BT", TREE IS A
 PISTOL BUTT, BEARING ~~AND~~ BEARS N 49° E 15.1 FT TO CENTER OF TRUNK

7" PISTOL BUTT D. FIR DOUBLE BLAZED AND SCRIBED "Y4S9CS BT"
 BEARS S 40° W 28.0 FT TO CENTER OF ROOT CROWN

Sketch of Monument, Accessories, and General Area

Location & Comments

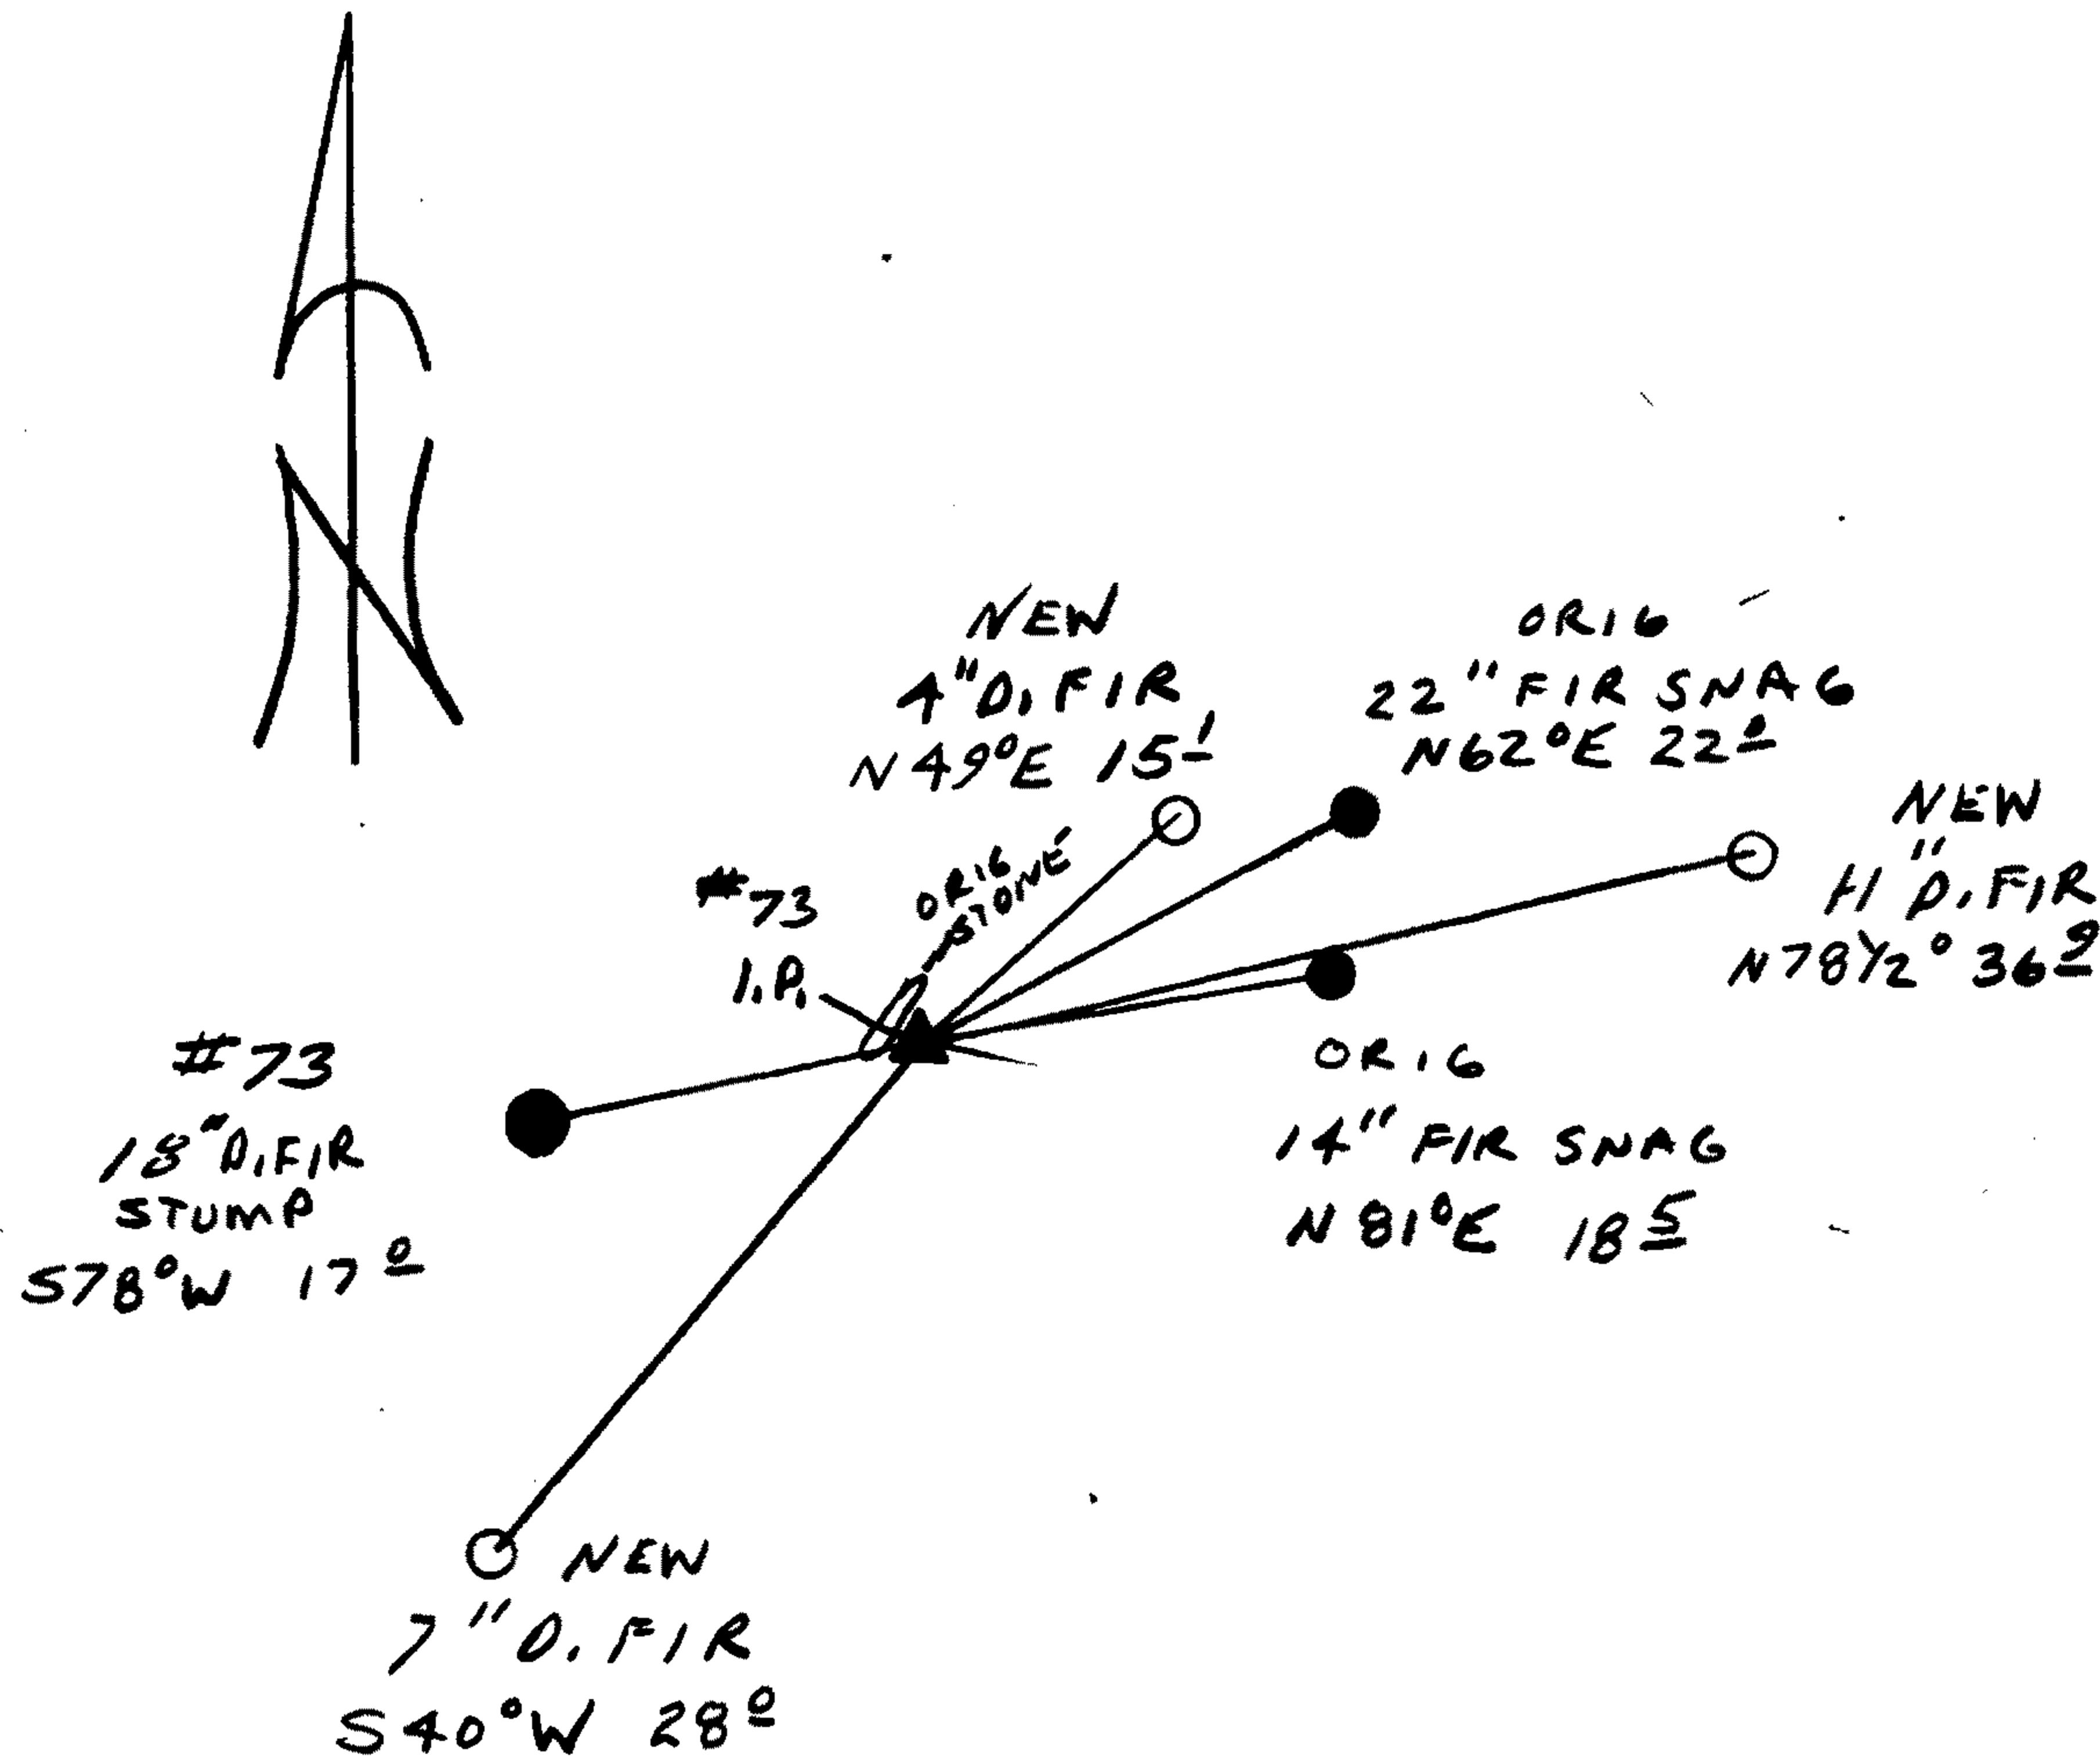

Comp. Declin. 18° E
 Agency DLCSO
 Party Chief RANDALL W SMITH
 Notekeeper Randall W Smith
 Witnesses STEPHEN J FLAUSK

Address

REGISTERED **Surveyor's Seal**
 PROFESSIONAL
 LAND SURVEYOR

Randall W Smith

OREGON
 JULY 25, 1990
 RANDALL W. SMITH
 2469