

GOVERNMENT CORNER RESTORATION FORM

FILED

Township 20S Range 12W Sec. 27 County DOUGLAS

State OR Date 8/6/92 No. _____

AUG 12 1992

Corner Designation

COUNTY SURVEYOR
DOUGLAS COUNTY, ORE

S28 | S27
S33 | S34

- Condition Report Only
- Not Found
- Renewed
- Unrecorded
- Surveyed In
- Referenced Out

MONUMENT DETAIL

Previous Renewals #71

Monument(s) Found: (Condition and Source)

NONE FD

N/A

Accessories Found:

48" NOW 42" DIA 6 FT HIGH SPRUCE STUMP WITH SCRIBING VISIBLE
ON A PARTIALLY HEALED BLAZE "S34 T20S R12W"
BEARS S11°E 35.0 FT. HORIZONTAL C (AS PER RECORD)

NO OTHER ORIG BTS FD

BT FROM REN #71 NOT FD

AREA RECENTLY LOGGED CORNER IN SLIDE AREA

RENEWAL

Monument Set (Procedure and Description)

A 2 3/8" DIA BRASS ON A 1/4" O.D. X 31" LONG IRON PIPE, IS SET AT THE BRG & DISTANCE FROM REMAINING ORIG. BT. BC/IP PROTRUDES 1" ABOVE A 2 FT DIA MOUND OF SAND STONE.


Monument Detail

DOUGLAS COUNTY SURVEYORS
T 20 S
S 28 | S 27 R
S 33 | S 34 Z
W
1992
OFFICE

New Accessories

40" DIA 4' HIGH SPRUCE STUMP, BOAT SPIKE STAMPED "B01" IS SET THROUGH BT TAG ON TOP NEAR CENTER, B.S. BEARS N 71° W, 91.2 FT
31" DIA 4' HIGH SPRUCE STUMP, BOAT SPIKE STAMPED "B02" IS SET THROUGH BT TAG ON TOP NEAR CENTER, B.S. BEARS S 81 1/2° W, 84.4 FT
CENTER PYLON WHERE BOATS CROSS UNDER RAIL ROAD TRESSEL OVER FIVE MILE ARM OF TAKKENITCH LAKE, BEARS N 5° W

Sketch of Monument, Accessories, and General Area

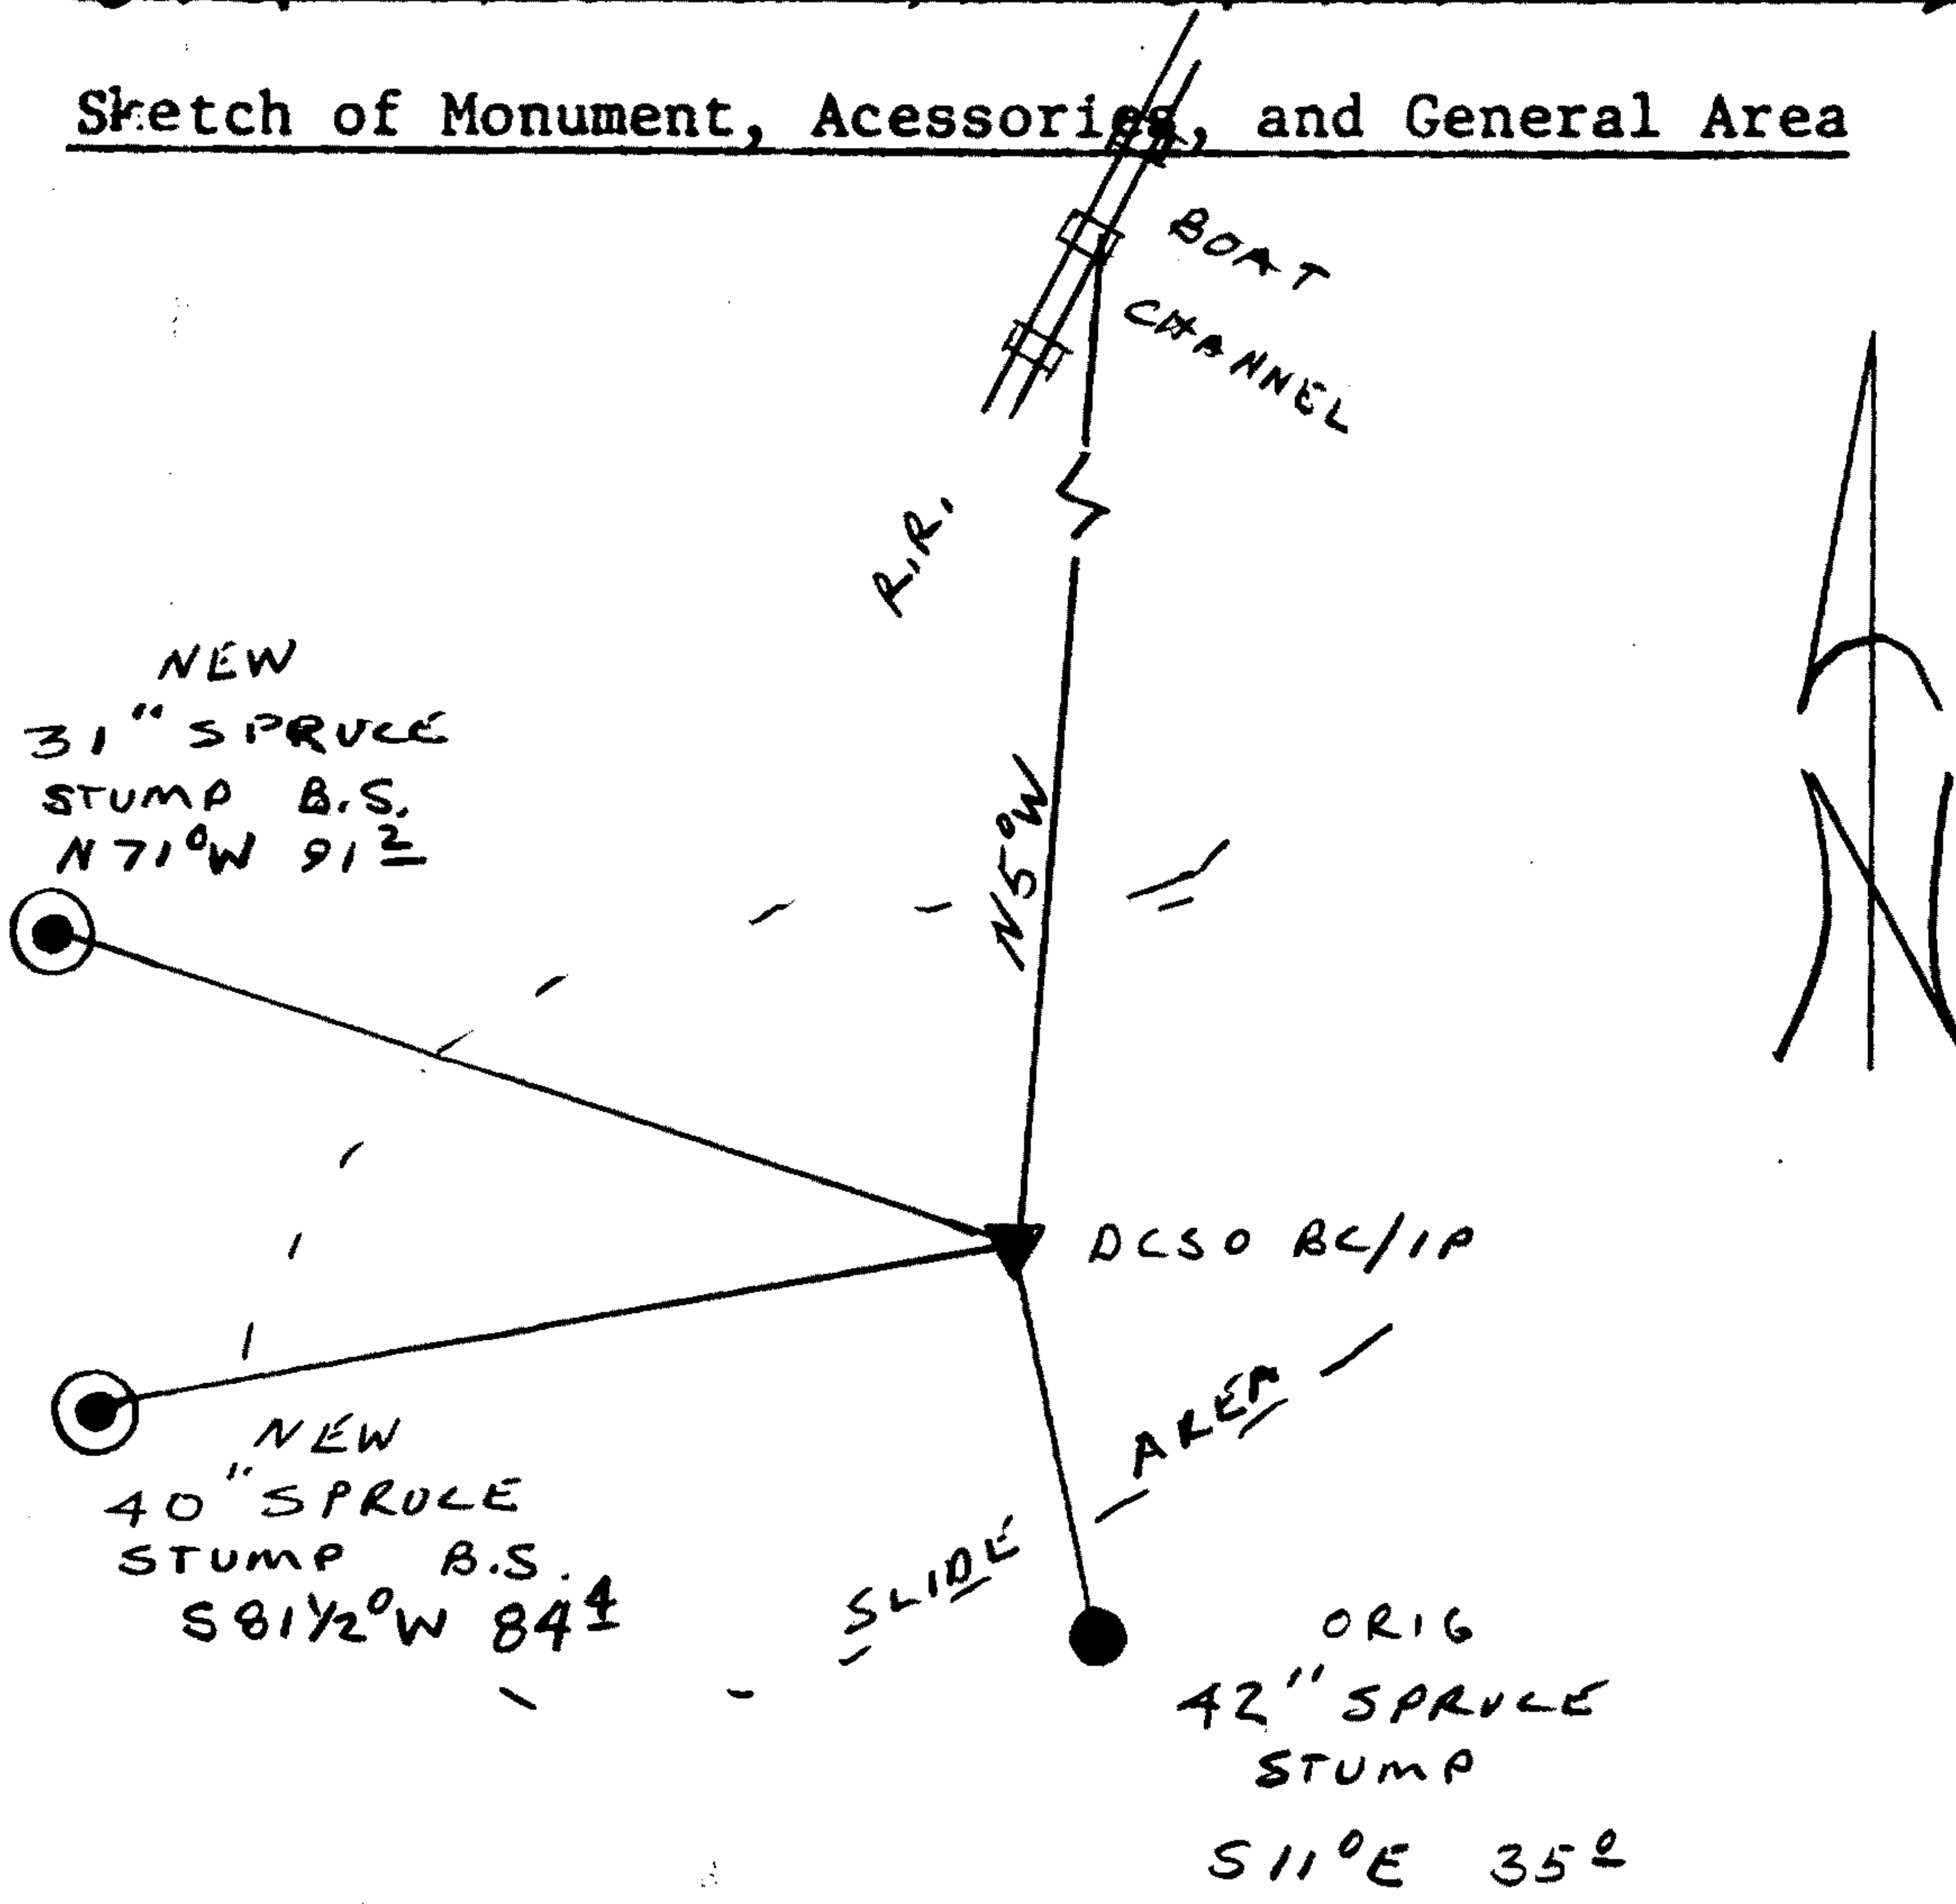

Location & Comments

Comp. Declin. 17 3/4° E
Agency DCSO
Party Chief RANDALL W. SMITH
Notekeeper *Randall W. Smith*
Witnesses STEPHEN J. FLAUSE

Address

REGISTERED **Surveyor's Seal**
PROFESSIONAL
LAND SURVEYOR
Randall W. Smith
OREGON
JULY 25, 1890
RANDALL W. SMITH
2489