

Township 31S Range 9W Sec. 34 County DOUGLAS

State OR Date 10/1/92 No. _____

OCT 30 1992

Corner Designation

1/4 S34/S35

COUNTY SURVEYOR
DOUGLAS COUNTY, ORE

- Condition Report Only
- Not Found
- Renewed
- Unrecorded
- Surveyed In
- Referenced Out

Previous Renewals

#77

Monument(s) Found: (Condition and Source)

2 1/2" DCSSO BRASS CAP ON A
1 1/2" OLD IRON PIPE, PROTRUDING
14" ABOVE GROUND (REN #77)

COUNTY SURVEYORS OFFICE
T 31S R 9W

1/4 S34/S35

1967

Accessories Found:

9" NOW 30" DIA. D. FIR WITH A FULLY HEALED DOUBLE
BLAZE, BEARS N 65° E, 15.8 FT (REC N 70° E, 15.8 FT)
ORIG BT

5" NOW 10" DIA 2 FT HIGH BROKEN AND ROTTED CHINQUAPIN
STUMP, ROTTED BLAZES, NO SCRIBING FD, BEARS N 70° W,
10.4 FT (REC N 70° W, 9.9 FT DIS. POSSIBLE BLAZE
MEASUREMENT (ORIG BT)

15" NOW 23" DIA D. FIR WITH A FULLY HEALED DOUBLE
BLAZE, BEARS N 75° W, 16.0 FT (REC N 76° W, 16.0 FT)
(REN #77)

1774

Monument Set (Procedure and Description)

Monument Detail

NONE


N/A

New Accessories

6" D. FIR DOUBLE BLAZED AND SCRIBED "Y4S35CS BT"
BEARS N 5 1/2° E, 11.0 FT

9" CHINQUAPIN DOUBLE BLAZED AND SCRIBE "Y4S34CS BT"
BEARS S 77° W, 9.0 FT

Sketch of Monument, Accessories, and General Area

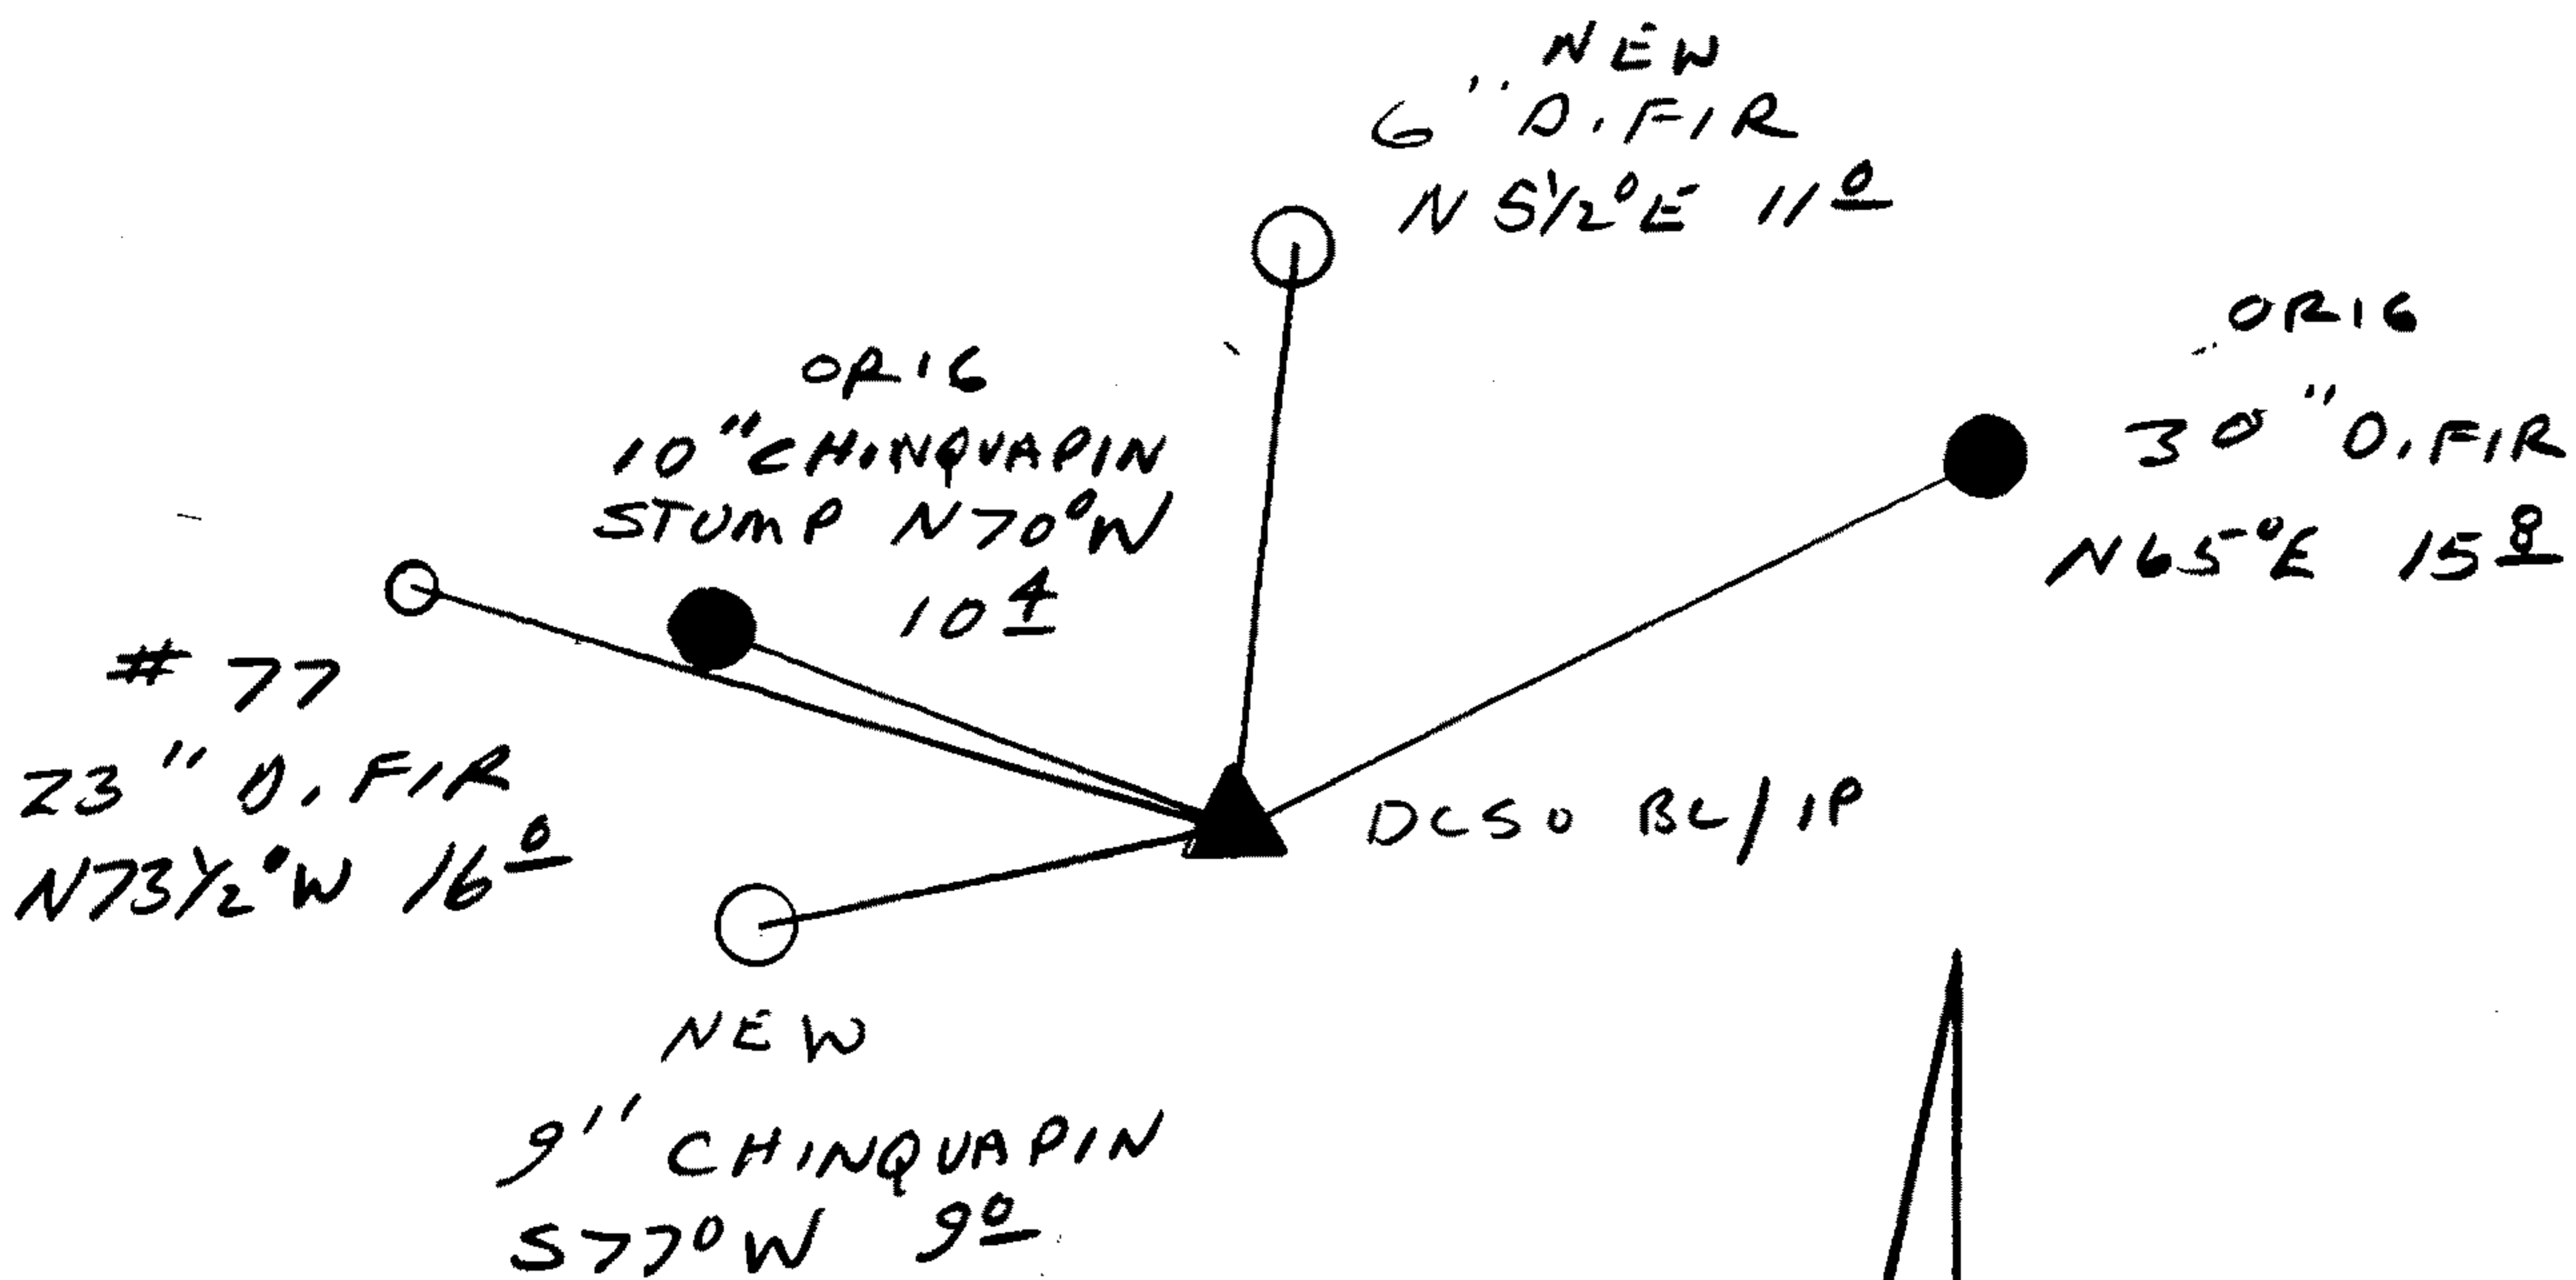

Location & Comments

Comp. Declin. 18° E
 Agency DCSO
 Party Chief RANDALL W SMITH
 Notekeeper Randall W Smith
 Witnesses STEPHEN J FLAHERTY

Address

Surveyor's Seal

REGISTERED
PROFESSIONAL
LAND SURVEYOR

Randall W Smith

OREGON
JULY 25, 1990
RANDALL W. SMITH
2469