

RENEWAL

Monument Set (Procedure and Description)

Monument Detail

A MOUND OF STONE IS ADDED
 AROUND BASE OF DC50 BC/IP,
 BC PROTRUDES 3" ABOVE 3 FT X
 2 FT BY 15" DEEP MOUND OF STONE


N/A

New Accessories

NONE

Sketch of Monument, Accessories, and General Area

Location & Comments

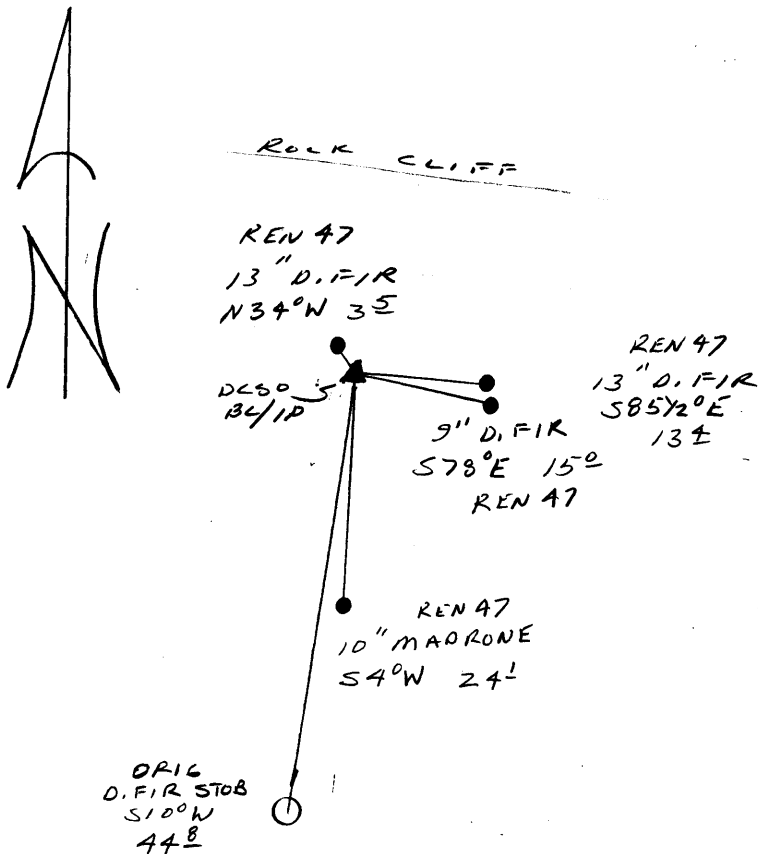

Comp. Declin. 18° E
 Agency DC50
 Party Chief RANDALL W. SMITH
 Notekeeper Randall W. Smith
 Witnesses STEPHEN J. FLAUSÉ

Address _____

REGISTERED **Surveyor** Seal
 PROFESSIONAL
 LAND SURVEYOR

Randall W. Smith

OREGON
 JULY 25, 1990
 RANDALL W. SMITH
 2489

EXPIRES 12-31-94