

GOVERNMENT CORNER RESTORATION FORM

FILED

Township 32S Range 8W Sec. 7 County DOUGLAS

State OREGON Date 12/13/92 No. _____

DEC 31 1992

Corner Designation

COUNTY SURVEYOR
DOUGLAS COUNTY, ORE.

| S7
| S18

- Condition Report Only
- Not Found
- Renewed
- Unrecorded
- Surveyed In
- Referenced Out

Previous Renewals 1917 RESURVEY, #37 #41 T32-9

MONUMENT DETAIL

Monument(s) Found: (Condition and Source)

NO EVIDENCE OF ORIGINAL BASALT STONE OR BRASS CAP MONUMENT OF 1917 RESURVEY FOUND.

Accessories Found:

NO EVIDENCE OF ORIGINAL BEARING TREES FOUND.

FROM 1917 RESURVEY A FIR, 30 INS. DIAM. NOW A FALLEN AND OUT OF POSITION 39 INCH DBH. DOUGLAS FIR (WITH POSSIBLE HEALED BLAZE) THE ROOT HOLE OF WHICH BEARS S 92° E, 37 1/2 FEET DISTANT (AS PER RECORD).

FROM RENEWAL #37 A 36" D. FIR NOW A 42 INCH D.B.H. DOUGLAS FIR WITH A DOUBLE BLAZE (UPPER BLAZE IS FULLY HEALED, LOWER BLAZE IS PARTIALLY HEALED AND SHOWS ILLEGIBLE SCRIBING) BEAR N 70 1/2° E, 57 3/4 FEET DISTANT (AS PER RECORD).

#123 T32-8
#75 T32-9

C.S. File No. 64/35-5C

RENEWAL

Monument Set (Procedure and Description)

Monument Detail

MONUMENT IS SET AT POSITION DETERMINED FROM FOUND 1917 RESURVEY BEARING TREE ROOT HOLE AND RENEWAL # 37 BEARING TREE (PREVIOUSLY DESCRIBED). MONUMENT IS A 2 3/8 INCH DIAMETER BRASS CAP (MARKED AS AT RIGHT) ON A 1 1/4 INCH O.D. 32 INCH LONG IRON PIPE SET PROTRUDING 4 INCHES ABOVE GROUND.

DOUGLAS COUNTY SURVEYORS OFFICE
T325

R	57	R
9	518	8
W		W

1992

New Accessories


A 6 INCH D.B.H. TAN OAK SCRIBED "X BT" ON A DOUBLE BLAZE, BEARS N22 1/2° E, 40 1/2 FEET DISTANT.

A 6" D.B.H. DOUGLAS FIR SCRIBED "T325 R9W57CS BT" ON A DOUBLE BLAZE, BEARS N39 1/2° E, 68 3/4 FEET DISTANT.

A 5 INCH D.B.H. DOUGLAS FIR SCRIBED "X BT" ON A DOUBLE BLAZE. THIS IS A PISTOL BUTT FIR OF WHICH THE BASE OF THE VERTICAL PORTION OF THE TRUNK BEARS S52° E, 28 1/2 FEET DISTANT.

Sketch of Monument, Accessories, and General Area

Location & Comments

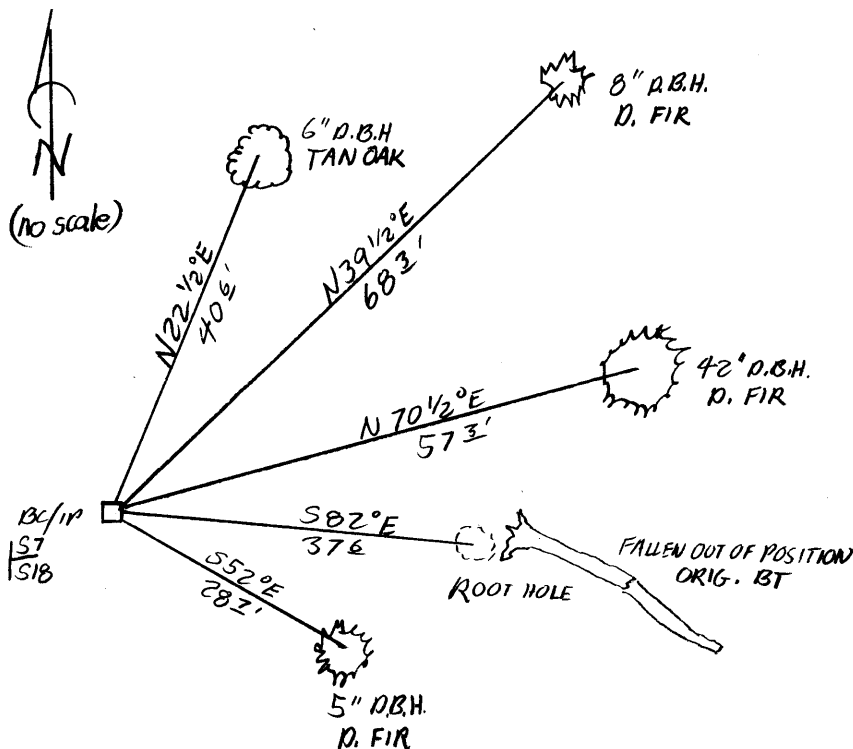

THIS CORNER LIES IN BOTTOM OF A STEEP RAVINE 800 FEET SOUTH OF A JEEP ROAD AND 1000 FEET WEST OF BLM ROAD 32-9-14.4.

Comp. Declin. 17 3/4°
Agency DCSO
Party Chief STEPHEN JOHN FLAUSE
Notekeeper Stephen John Flause
Witnesses JOHN PIKE

Address

Surveyor's Seal
REGISTERED
PROFESSIONAL
LAND SURVEYOR

Randall W. Smith

OREGON
JULY 25, 1960
RANDALL W. SMITH
2139

EXPIRES 12-31-92