

GOVERNMENT CORNER RESTORATION FORM

FILED

Township 22S Range 11 W Sec. 3 County DOUGLAS

State OR Date 2-24-93 No. \_\_\_\_\_

MAR 17 1993

Corner Designation

W/4 S3 ONLY

COUNTY SURVEYOR  
DOUGLAS COUNTY, ORE.

- Condition Report Only
- Not Found
- Renewed
- Unrecorded
- Surveyed In
- Referenced Out

Previous Renewals ~~#109~~ <sup>#62</sup>, 1987 BLM UNRECORDED

MONUMENT DETAIL

Monument(s) Found: (Condition and Source)

A STRONG METAL READING IN HOLE IS FOUND S83°W 3.0 FT FROM WOODEN POST WITH NAIL. WITH SHOVEL, TOP OF CAP IS FOUND IN HOLE 2.5 FT BELOW GRD. (HOLE FULL OF WATER).

NOT VISIBLE

Accessories Found:

NO POST FROM REN #62 FOUND

7" NOW 10" DIA. ALDER BARK SCRIBED "X BT" BEAR N73 3/4° E, 231.8 FT (AGREES WITH BLM) BLM

10" NOW 12" DIA. ALDER WITH A FULLY HEALED SINGLE BLAZE BEARS S39°E, 162.7 FT. (AGREES WITH BLM) BLM

BE/1P W.C. 1/4 S4 BEARS S0 3/4° W, 116.7 FT

# 177 X

RENEWAL

Monument Set (Procedure and Description)

NONE


Monument Detail

N/A

New Accessories

POWER POLE BEARS N 13 1/4° W, 182.9 FT.

Sketch of Monument, Accessories, and General Area

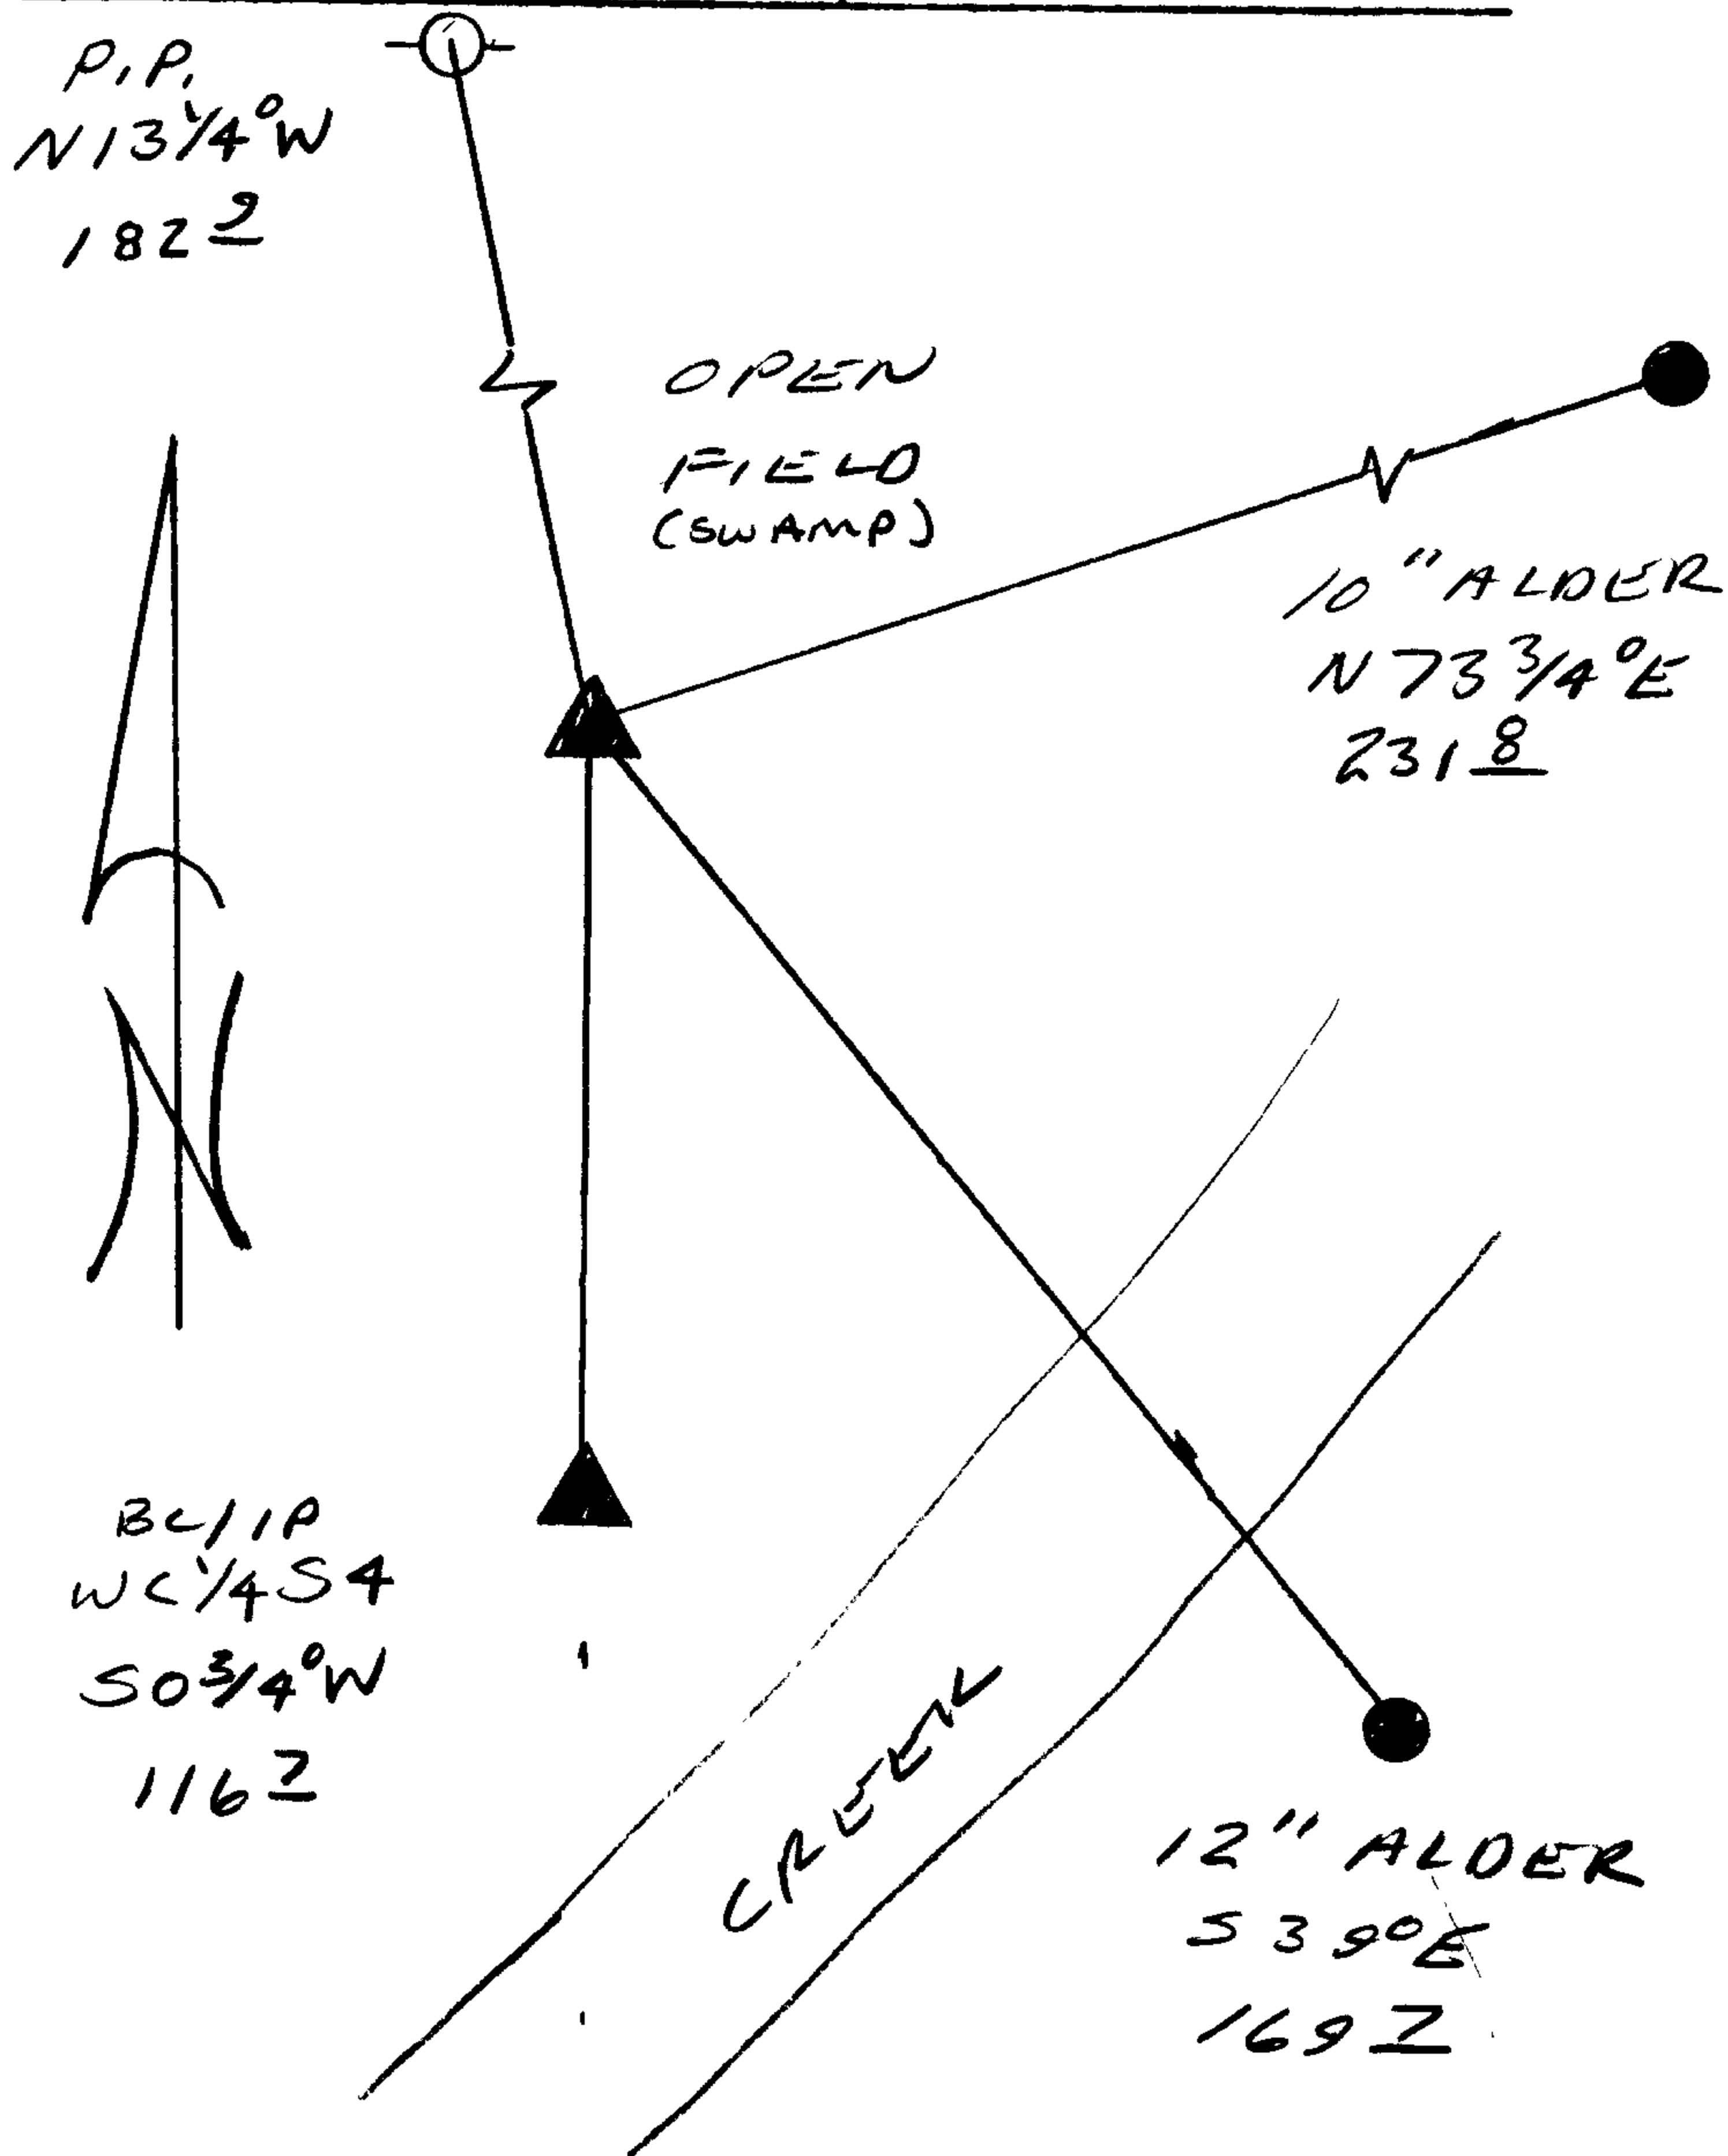

Location & Comments

Comp. Declin. 18° E  
 Agency DCSO  
 Party Chief RANDALL W SMITH  
 Notekeeper Randall W Smith  
 Witnesses STEPHEN J FLAUSE

Address

**Surveyor's Seal**

REGISTERED  
PROFESSIONAL  
LAND SURVEYOR

*Randall W Smith*  
EXPIRES 12-31-94

OREGON  
JULY 25, 1993  
RANDALL W. SMITH  
2463