

Township 27S Range 5W Sec. 6 County DOUGLAS

State OR Date 3-18-93 No. _____

APR 26 1993

Corner Designation

COUNTY SURVEYOR
DOUGLAS COUNTY, ORE

Condition Report Only

Not Found

Renewed

Unrecorded

Surveyed In

Referenced Out

MONUMENT DETAIL

DLC
49

Previous Renewals DATED 1938 AND 1963

Monument(s) Found: (Condition and Source)

1/2" I.D. IRON PIPE, PROTRUDING
2" ABOVE GROUND. (1938 BOYER
RENEWAL)

N/A

Accessories Found:

15" NOW 14" DIA 172 FT HIGH ROTTED OAK STUMP NO BLAZES
OR SCRIBING VISIBLE, BEARS S84°E, 11.3 FT (AGREES
WITH REC) 1938 BOYER RENEWAL

8" W. OAK NOW DEPRESSION BEARS S27°W 30.0 FT
(AGREES WITH REC) 1938 BOYER RENEWAL

9" DIA. NOW 14" W. OAK WITH A FULLY HEALED DOUBLE BLAZE,
BEARS S22°E 58.0 FT (AGREES WITH REC) 1963 BYRON
RENEWAL

9" NOW 14" W. OAK WITH A FULLY HEALED DOUBLE BLAZE,
BEARS N49°E, 101.0 FT (AGREES WITH REC) 1963 BYRON
RENEWAL

BT NOT RECORDED IN 1963 BYRON RENEWAL, IN CS FILE
53/38 BT LINKED OUT WITH NOTE TO BE CUT.
24" DIA NOW 49" W. OAK WITH A FULLY HEALED DOUBLE
BLAZE BEARS N62°E, 78.7 FT (REC CS 53/38 N61°E,
78.7 FT) 1963 BYRON RENEWAL

RENEWAL

Monument Set (Procedure and Description)

UNABLE TO SET BC/IP, WATER
FO TOP AT GROUND LEVEL. WILL
SET BC/IP AT A LATER DATE


Monument Detail

N/A

New Accessories

3/4" I.R. BEARS S75°E, 200.33 FT (I.R. AT FENCE
CORNER OF N-S AND W RUNNING FENCE LINES

Sketch of Monument, Accessories, and General Area

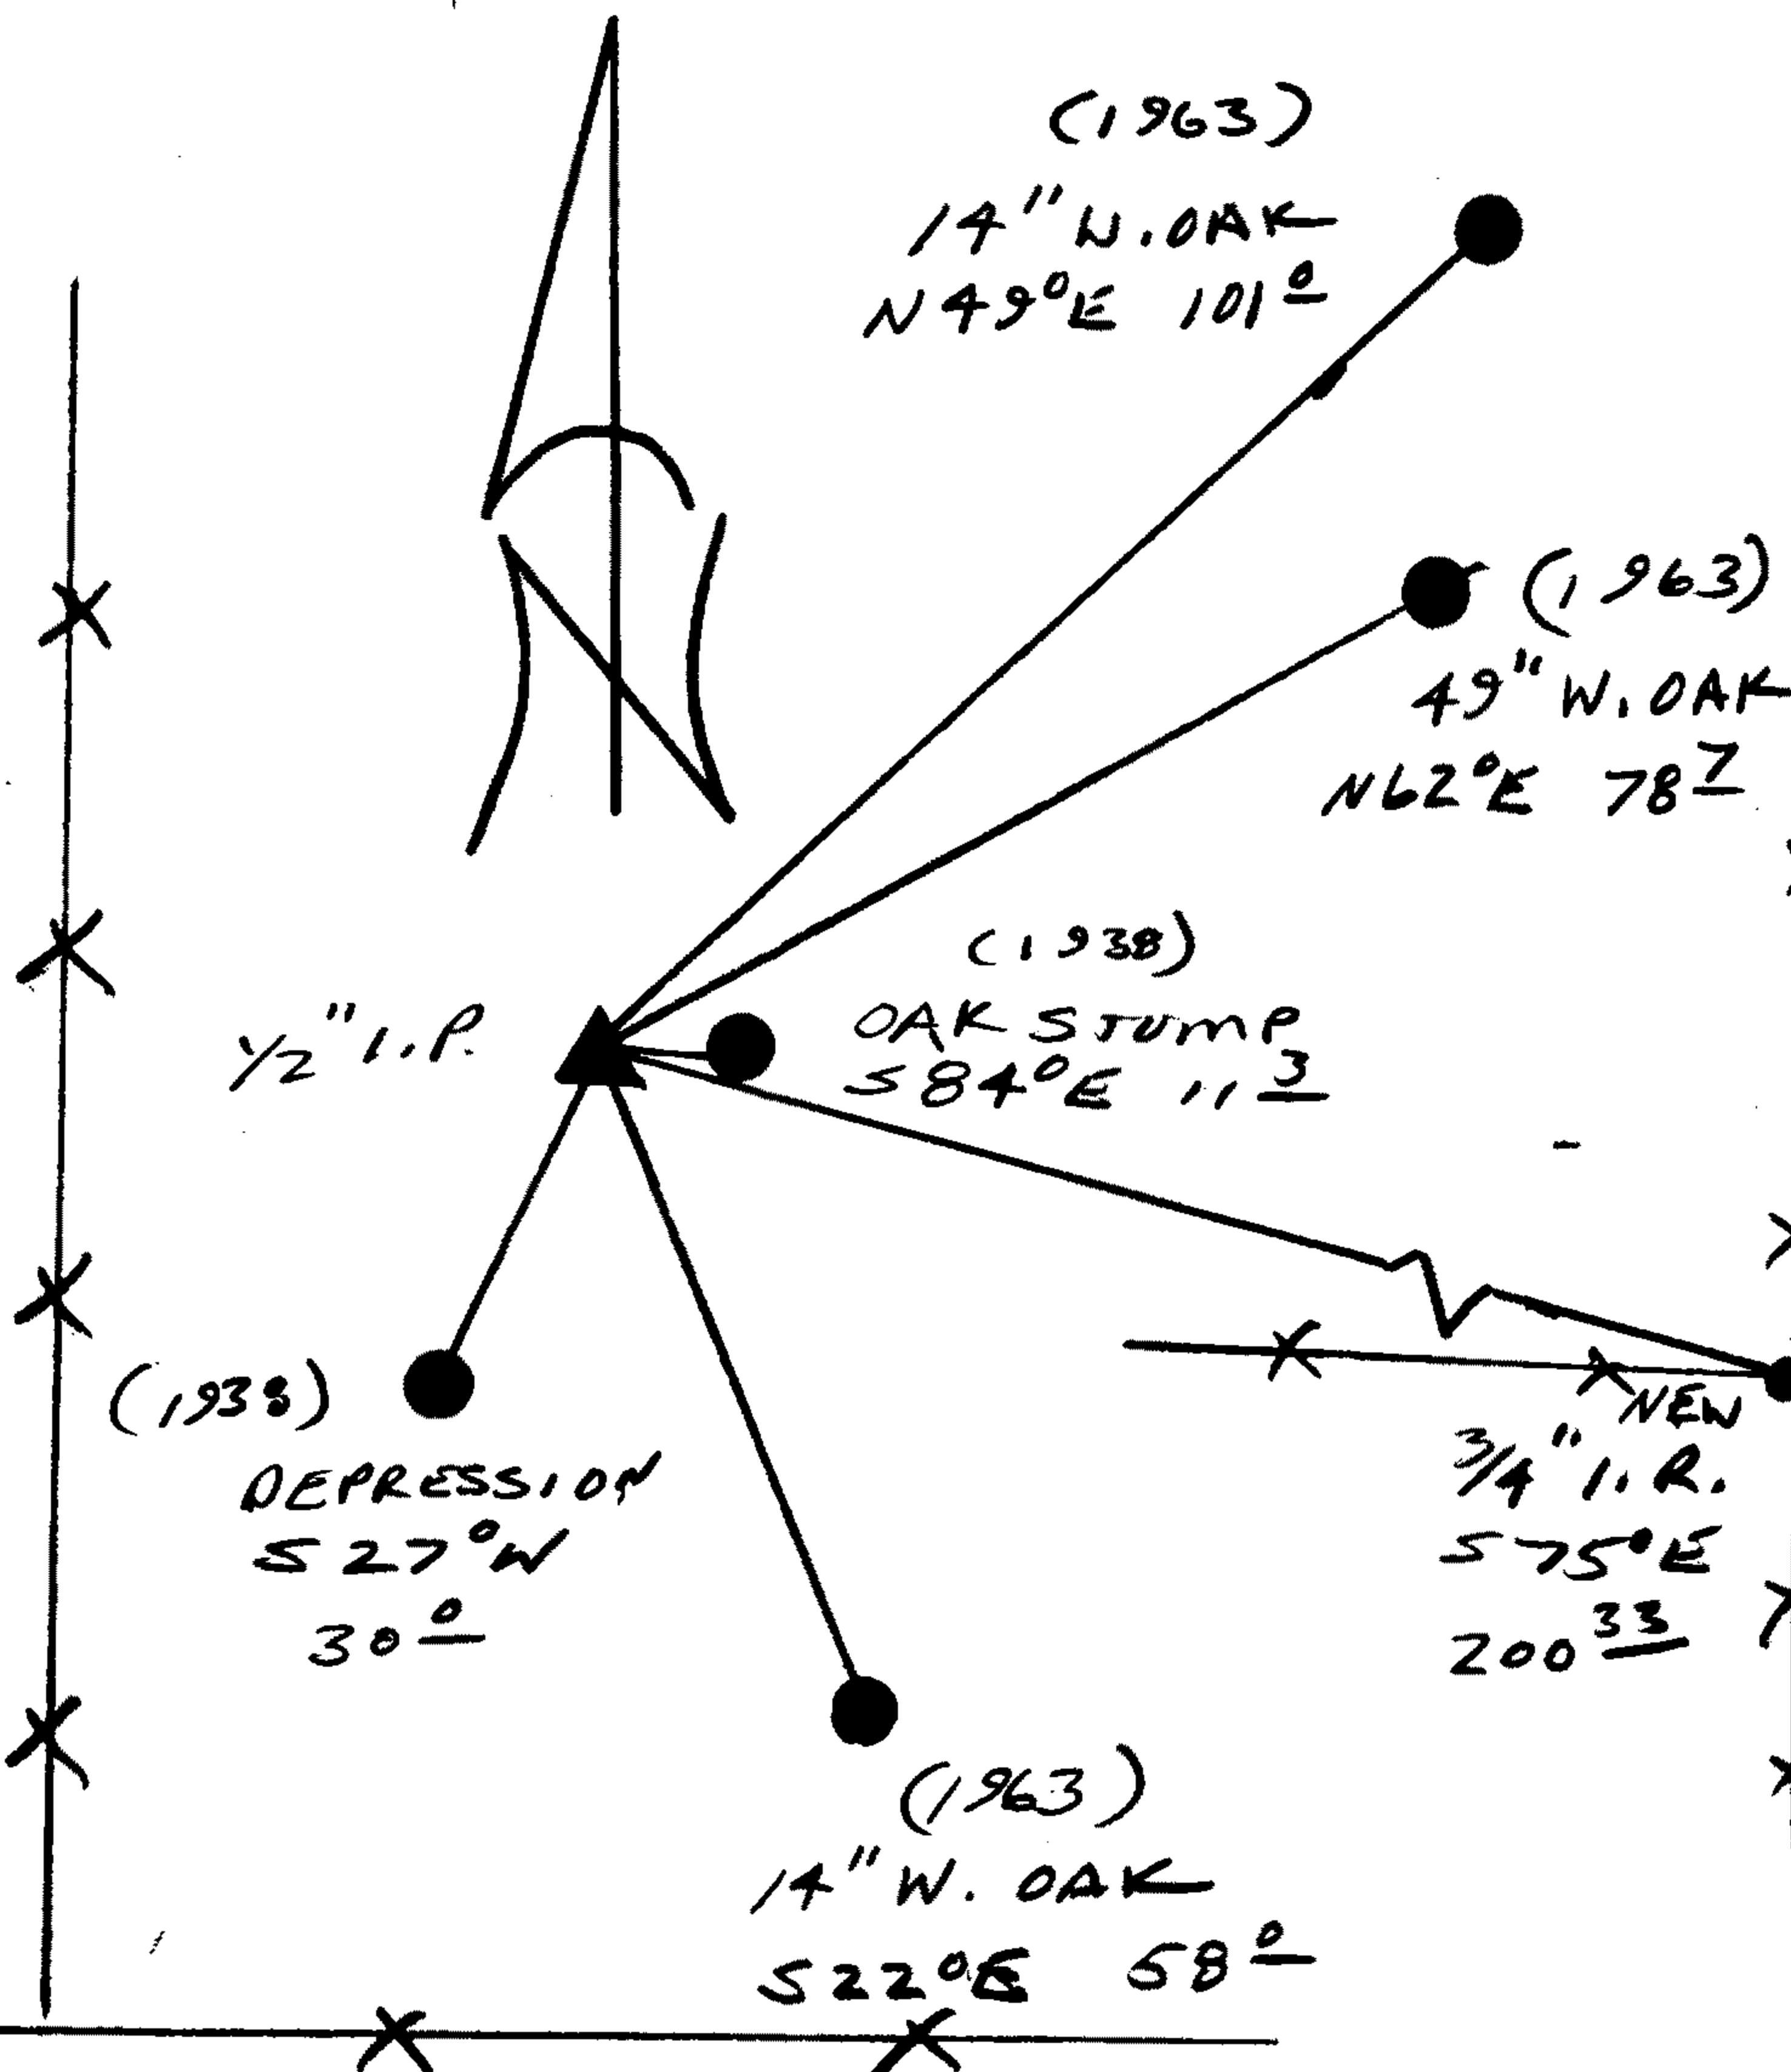

Location & Comments

Comp. Declin. 18°E
Agency DCSO
Party Chief RANDALL W SMITH
Notekeeper Randall W Smith
Witnesses _____

Address _____

Surveyor's Seal

REGISTERED
PROFESSIONAL
LAND SURVEYOR

Randall W Smith
EXPIRES 12-31-94

OREGON
JULY 25, 1990
RANDALL W. SMITH
2469