

GOVERNMENT CORNER RESTORATION FORM

Township 27S Range 5W Sec. 6 County DOUGLAS

APR 22 1993

State OR Date 3-18-93

No. \_\_\_\_\_ COUNTY SURVEYOR  
DOUGLAS COUNTY, OR

Corner Designation

1/4  
S1 | S6

- \_\_\_\_\_ Condition Report Only
- \_\_\_\_\_ Not Found
- Renewed
- \_\_\_\_\_ Unrecorded
- \_\_\_\_\_ Surveyed In
- \_\_\_\_\_ Referenced Out

Previous Renewals DATED 1934 + 1958

Monument(s) Found: (Condition and Source)

1" O.D. GUN BARREL PROTRUDING  
3" ABOVE GROUND (1934 BBI  
REN)

MONUMENT DETAIL

N/A

Accessories Found:

20" NOW 22" DIA W. OAK WITH A FULLY HEALED  
BLAZE BEARS S 83 1/4° W, 72.7 FT (AGREES  
WITH REC) (1934 BBI REN)

6" NOW 9" DIA MADRONE WITH A FULLY HEALED  
BLAZE BEARS N 60° E, 29.7 FT (AGREES WITH REC)  
(1958 J. BYRON REN)

RENEWAL

Monument Set (Procedure and Description)

2 3/8" BRASS CAP ON A 1 3/8" O.D X 32" LONG IRON PIPE IS SET AT REFERENCED POSITION OF GUN BARREL, PROTRUDES 6" ABOVE GROUND. 1" O.D X 24" LONG GUN BARREL IS SET ALONG NORTH EDGE OF BC/IP PROTRUDING 2" ABOVE GROUND.

Monument Detail

DOUGLAS COUNTY SURVEYORS

T 27 S

R 1/4 | S 6 R  
6 S 1 | S 6 5  
W W


1993 OFFICE

New Accessories

9" MADRONE DOUBLE BLAZED AND SCRIBED "Y4S1CS BT" BEARS S 30° W, 9.4 FT

9" B. OAK DOUBLE BLAZED AND SCRIBED "Y4S6CS BT" BEARS S 66° E, 33.3 FT

Sketch of Monument, Accessories, and General Area

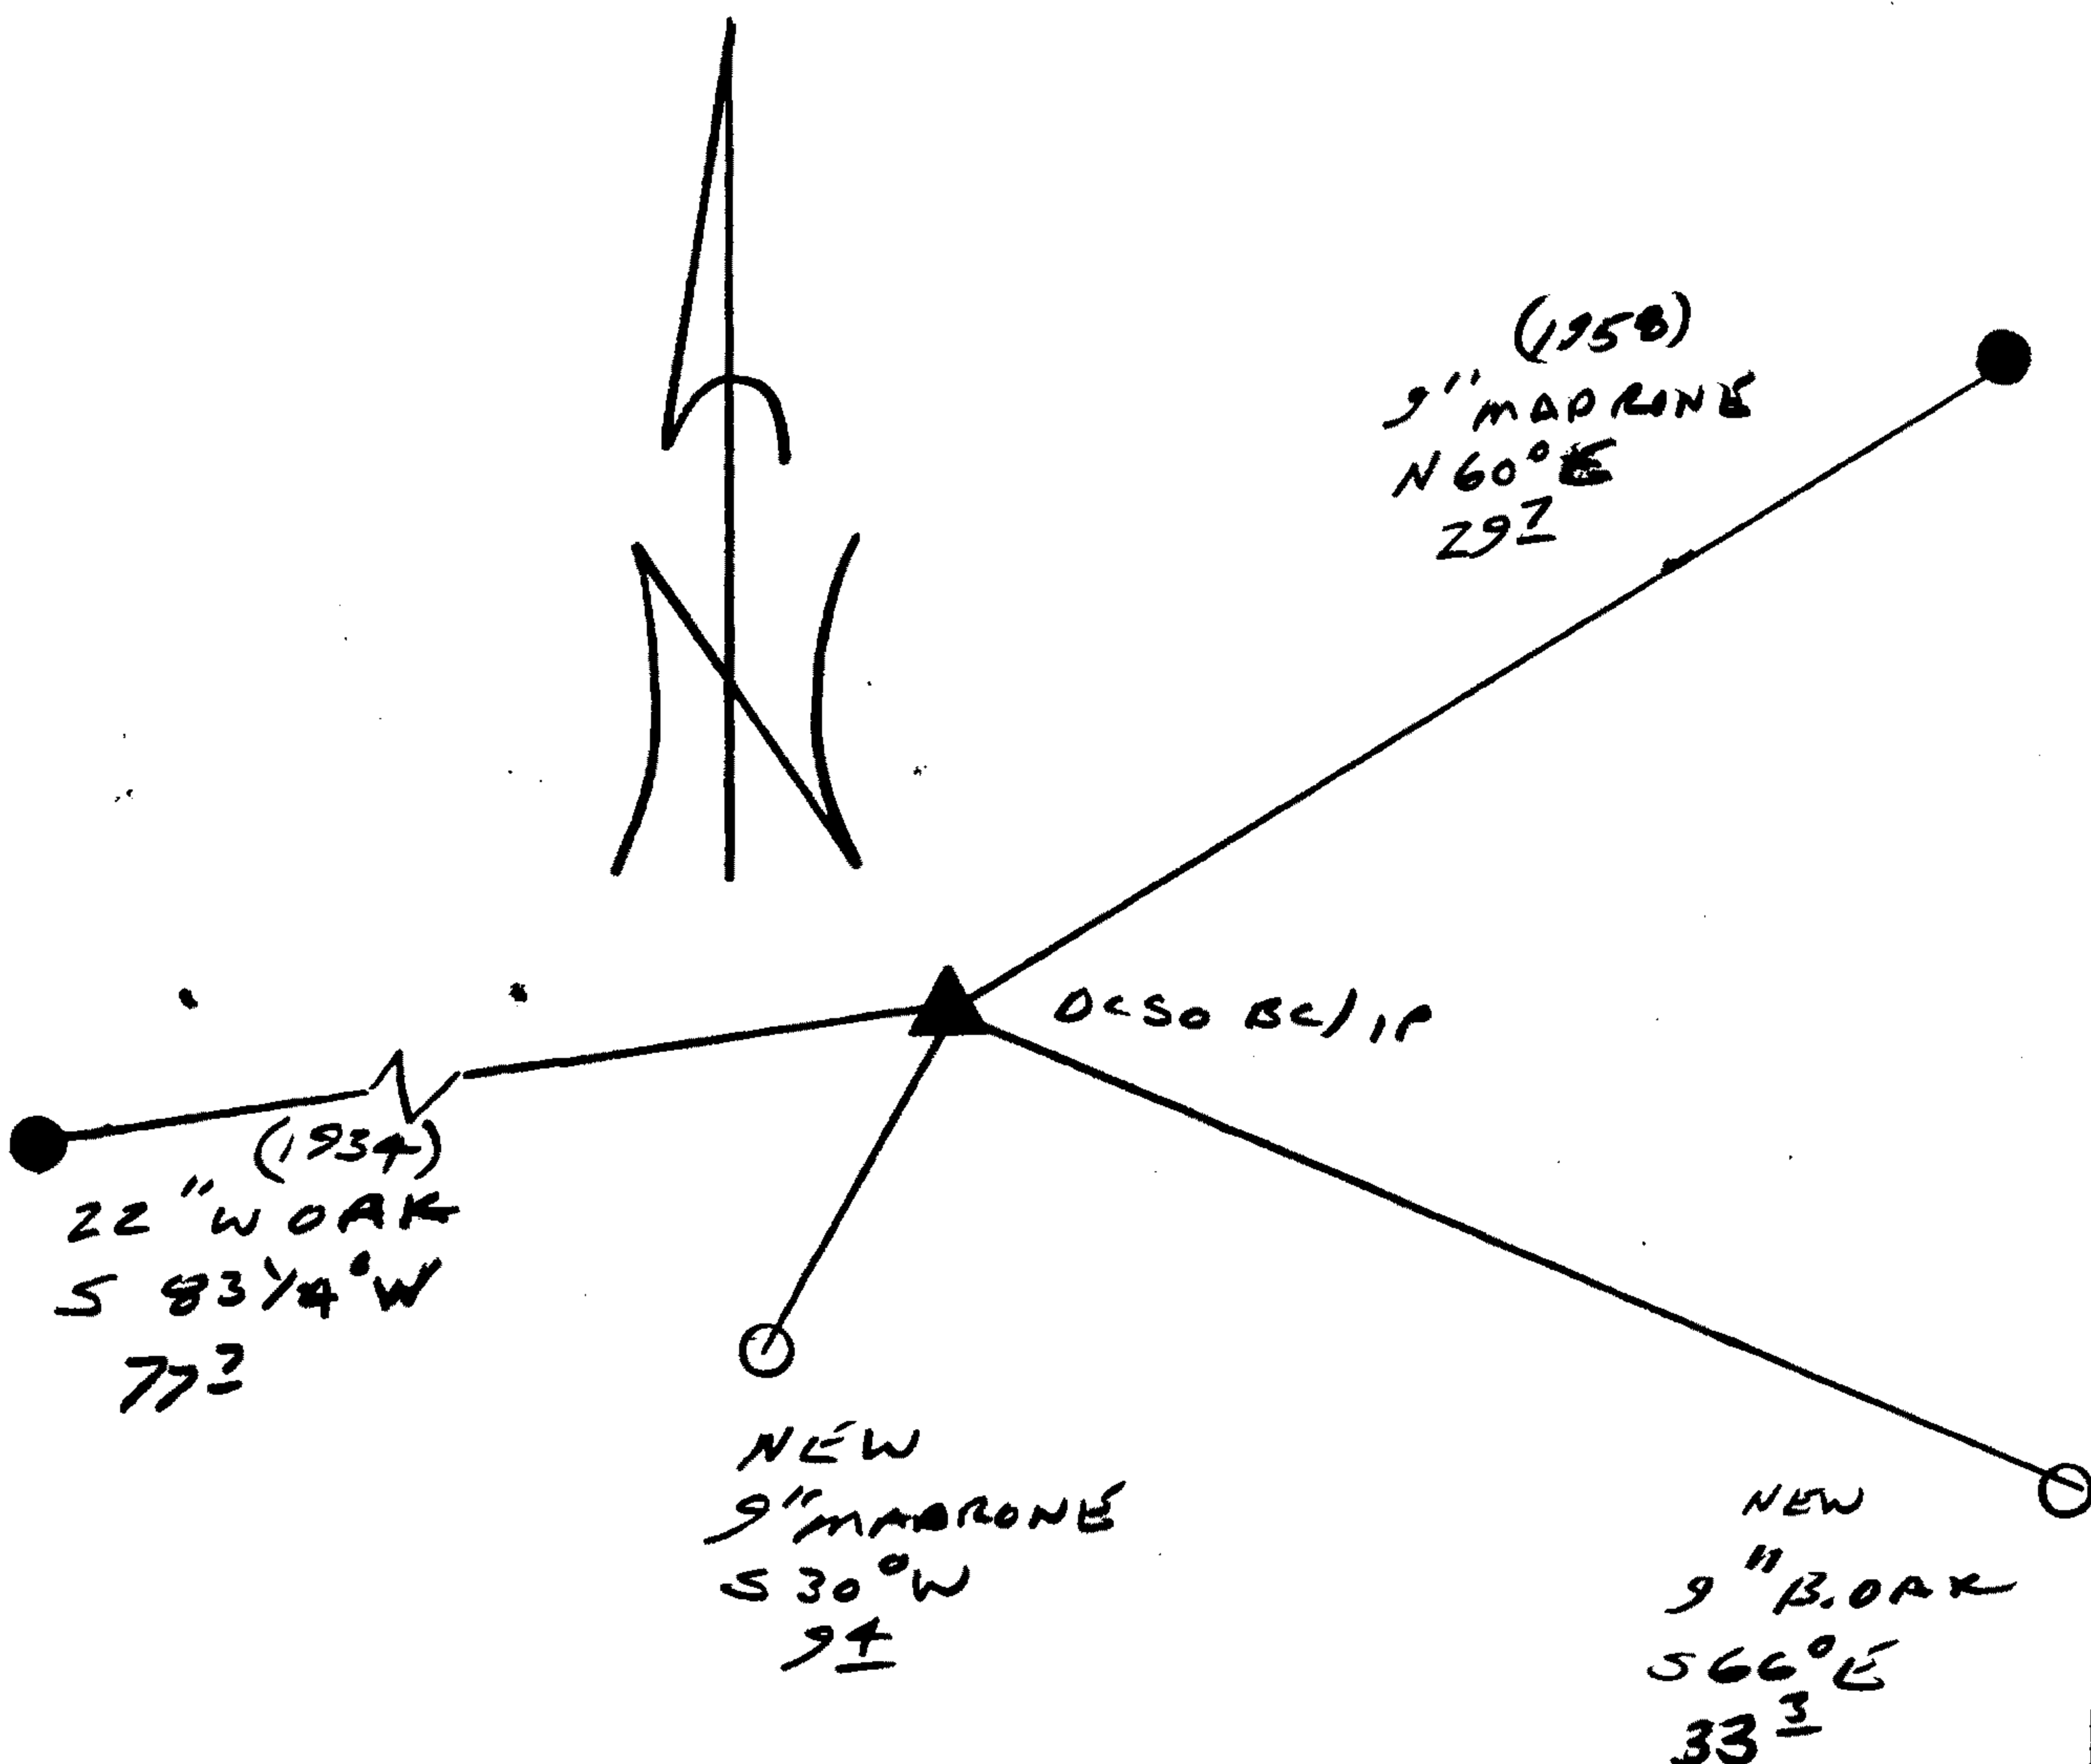

Location & Comments

Comp. Declin. 18° E  
Agency DCSO  
Party Chief RANDALL W. SMITH  
Notekeeper Randall W. Smith  
Witnesses STEPHEN J. FLAUSK

Address

Surveyor's Seal

