

GOVERNMENT CORNER RESTORATION FORM

FILED *JP*

Township 27S Range 5W Sec. 9 County DOUGLAS

State OR Date 3-22-93 No. _____ APR 22 1993

Corner Designation

$\frac{1}{4}$ S 9 | S 10

COUNTY SURVEYOR

DOUGLAS COUNTY, ORE.
Condition Report Only

- Not Found
- Renewed
- Unrecorded
- Surveyed In
- Referenced Out

MONUMENT DETAIL

Previous Renewals 1967 REN.

Monument(s) Found: (Condition and Source)

A 2 1/2" DIA BRASS CAP ON AN
1 1/2" O.D. IRON PIPE, PROTRUDING
13" ABOVE GROUND (1967 BAUGHMAN REN)

T27S R5W

1/4

9/10

1967 LS536

Accessories Found:

12" NOW 14" DIA MADRONE WITH A PARTIALLY HEALED
SINGLE BLAZE, ILLEGIBLE SCRIBE MARKS
VISIBLE, BEARS S 1/2° W, 19.3 FT (REC. S 4° W, 18 FT
BRG HITS CNT OF TRUNK, BLAZE HIGH) 1967 BAUGHMAN REN

6" NOW 8" DIA B.OAK WITH A FULLY HEALED SINGLE
BLAZE, BEARS N 76° W, 17.6 FT (AGREES WITH REC)
1967 BAUGHMAN REN

Monument Set (Procedure and Description)

Monument Detail

NONE

N/A

New Accessories


8" DIA D. FIR DOUBLE BLAZED AND SCRIBED "1/4 S 10 CS BT"
BEARS N 8 1/2° E, 12.4 FT

23" DIA. PINE DOUBLE BLAZED AND SCRIBED "1/4 S 9 CS BT"
BEARS S 84° W, 23.0 FT

Sketch of Monument, Accessories, and General Area

Location & Comments

CORNER IS 15' SOUTH
OF AN E-W RUNNING
FENCE.

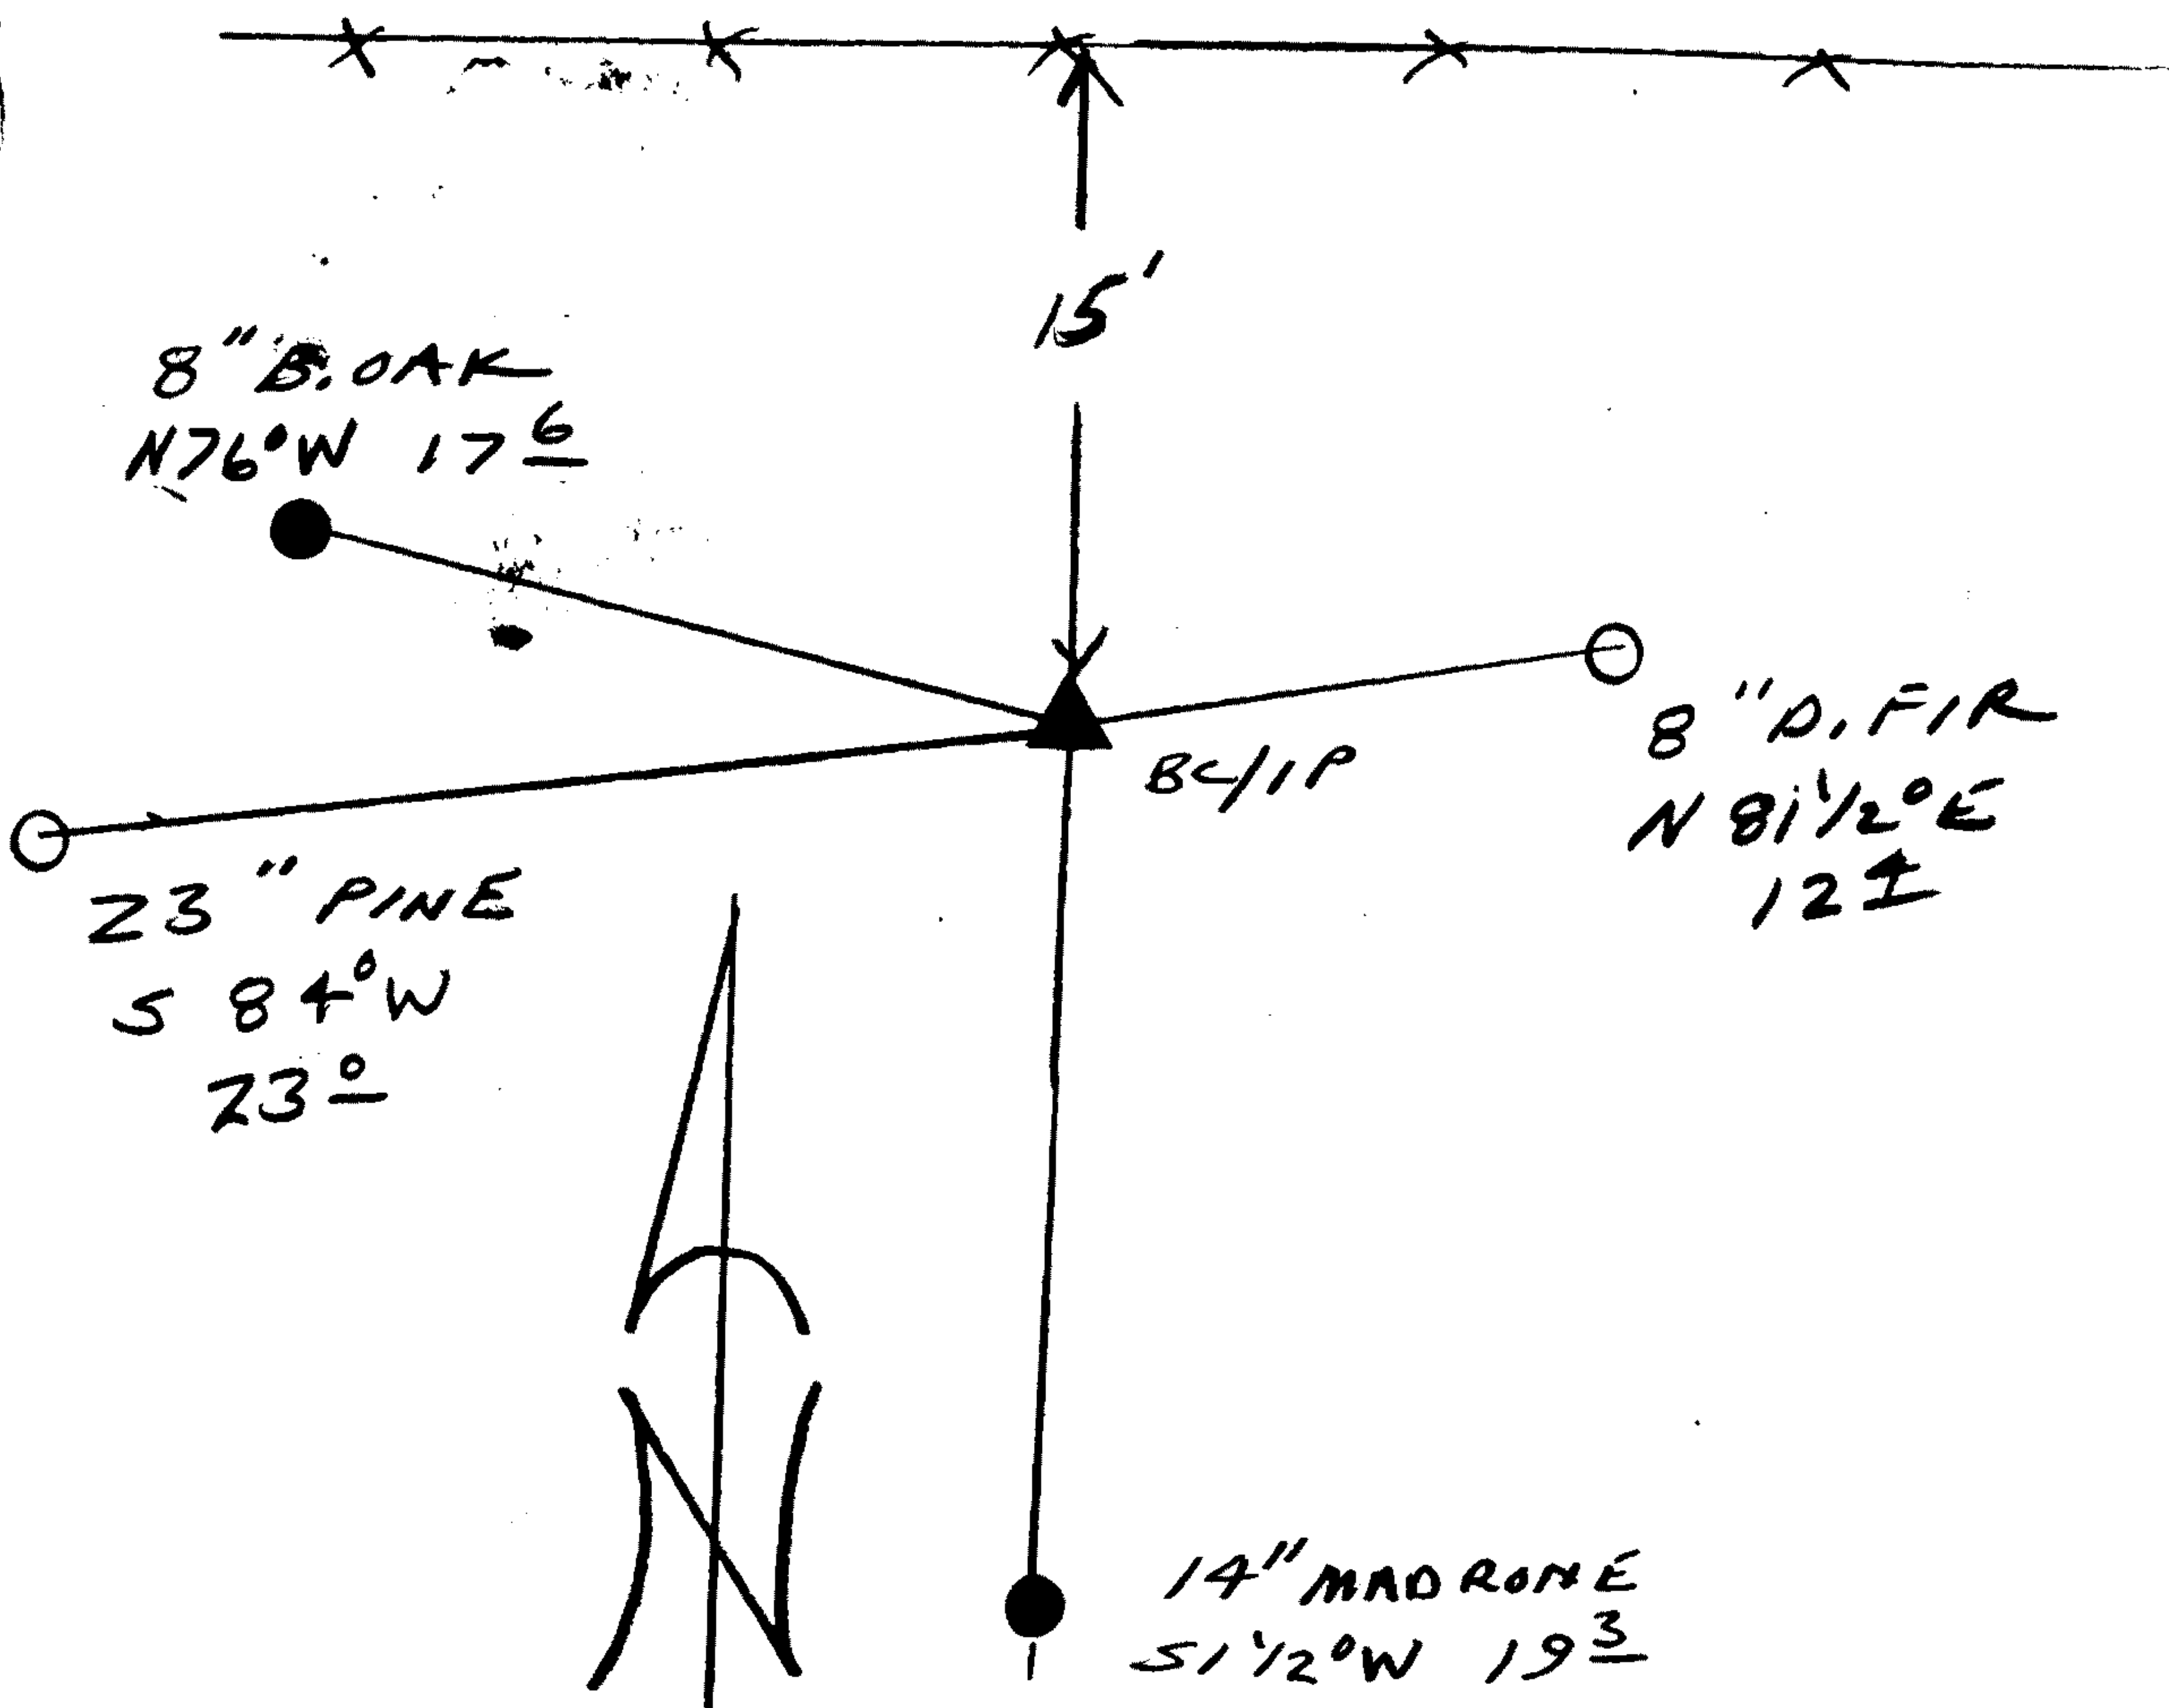

Comp. Declin. 18° E
Agency DCSO
Party Chief RANDALL W. SMITH
Notekeeper Randall W. Smith
Witnesses STEPHEN J. FLAUSÉ

Address

REGISTERED Surveyor's Seal
PROFESSIONAL
LAND SURVEYOR

Randall W. Smith
EXPIRES 12-31-94

OREGON
JULY 25, 1990
RANDALL W. SMITH
2469