

GOVERNMENT CORNER RESTORATION FORM

Township 32S Range 8W Sec. 29 County DOUGLAS

APR 13 1993

State OR Date 4-1-93

No. \_\_\_\_\_

COUNTY SURVEYOR  
DOUGLAS COUNTY, ORE

Corner Designation

$\frac{1}{4} \frac{S29}{S32}$

- Condition Report Only
- Not Found
- Renewed
- Unrecorded
- Surveyed In
- Referenced Out

Previous Renewals #102

Monument(s) Found: (Condition and Source)

1 1/2" DIA. BRASS CAP ON A 1 1/2" O.D. IRON PIPE, PROTRUDING 12" ABOVE GROUND (REN #102)

FD BROKEN STONE AROUND BASE OF BRASS CAP / IRON PIPE, LARGEST STONE MEASURES 8" X 8" X 5" NO MARKS FOUND. (ORIG STONE).

MONUMENT DETAIL

COUNTY SURVEYORS OFFICE

T 32S R 8W

$\frac{1}{4} \frac{S29}{S32}$

1968

Accessories Found:

15" NOW 24" DIA. 4 1/2 FT HIGH DOUBLE TRUNKED D.FIR STUMP WITH A PARTIALLY HEALED SINGLE BLAZE "1/4 S32 CS BT" ON EASTERLY TRUNK, ROOT CROWN BEARS S 63° E, 13.2 FT (AGREES WITH REC.) ORIG. BT

14" NOW 21" DIA 3 1/2 FT HIGH D.FIR STUMP WITH A PARTIALLY HEALED DOUBLE BLAZE "1/4 S29 CS BT" BEARS N 57° W, 13.9 FT (REC N 54° W, 14.5 FT) ORIG. BT.

NO BARK SCRIBING FOUND ON BT'S MARKS POSSIBLY REMOVED WHEN RESCRIBED IN REN #102

Monument Set (Procedure and Description)

Monument Detail

NONE

N/A


New Accessories

4" D. FIR DOUBLE BLAZED AND SCRIBED "X BT" BEARS S6°E, 27.8 FT.

10" D. FIR DOUBLE BLAZED AND SCRIBED "1/4 S 29 CS BT" BEARS N 44 1/2° E 51.9 FT.

Sketch of Monument, Accessories, and General Area

Location & Comments

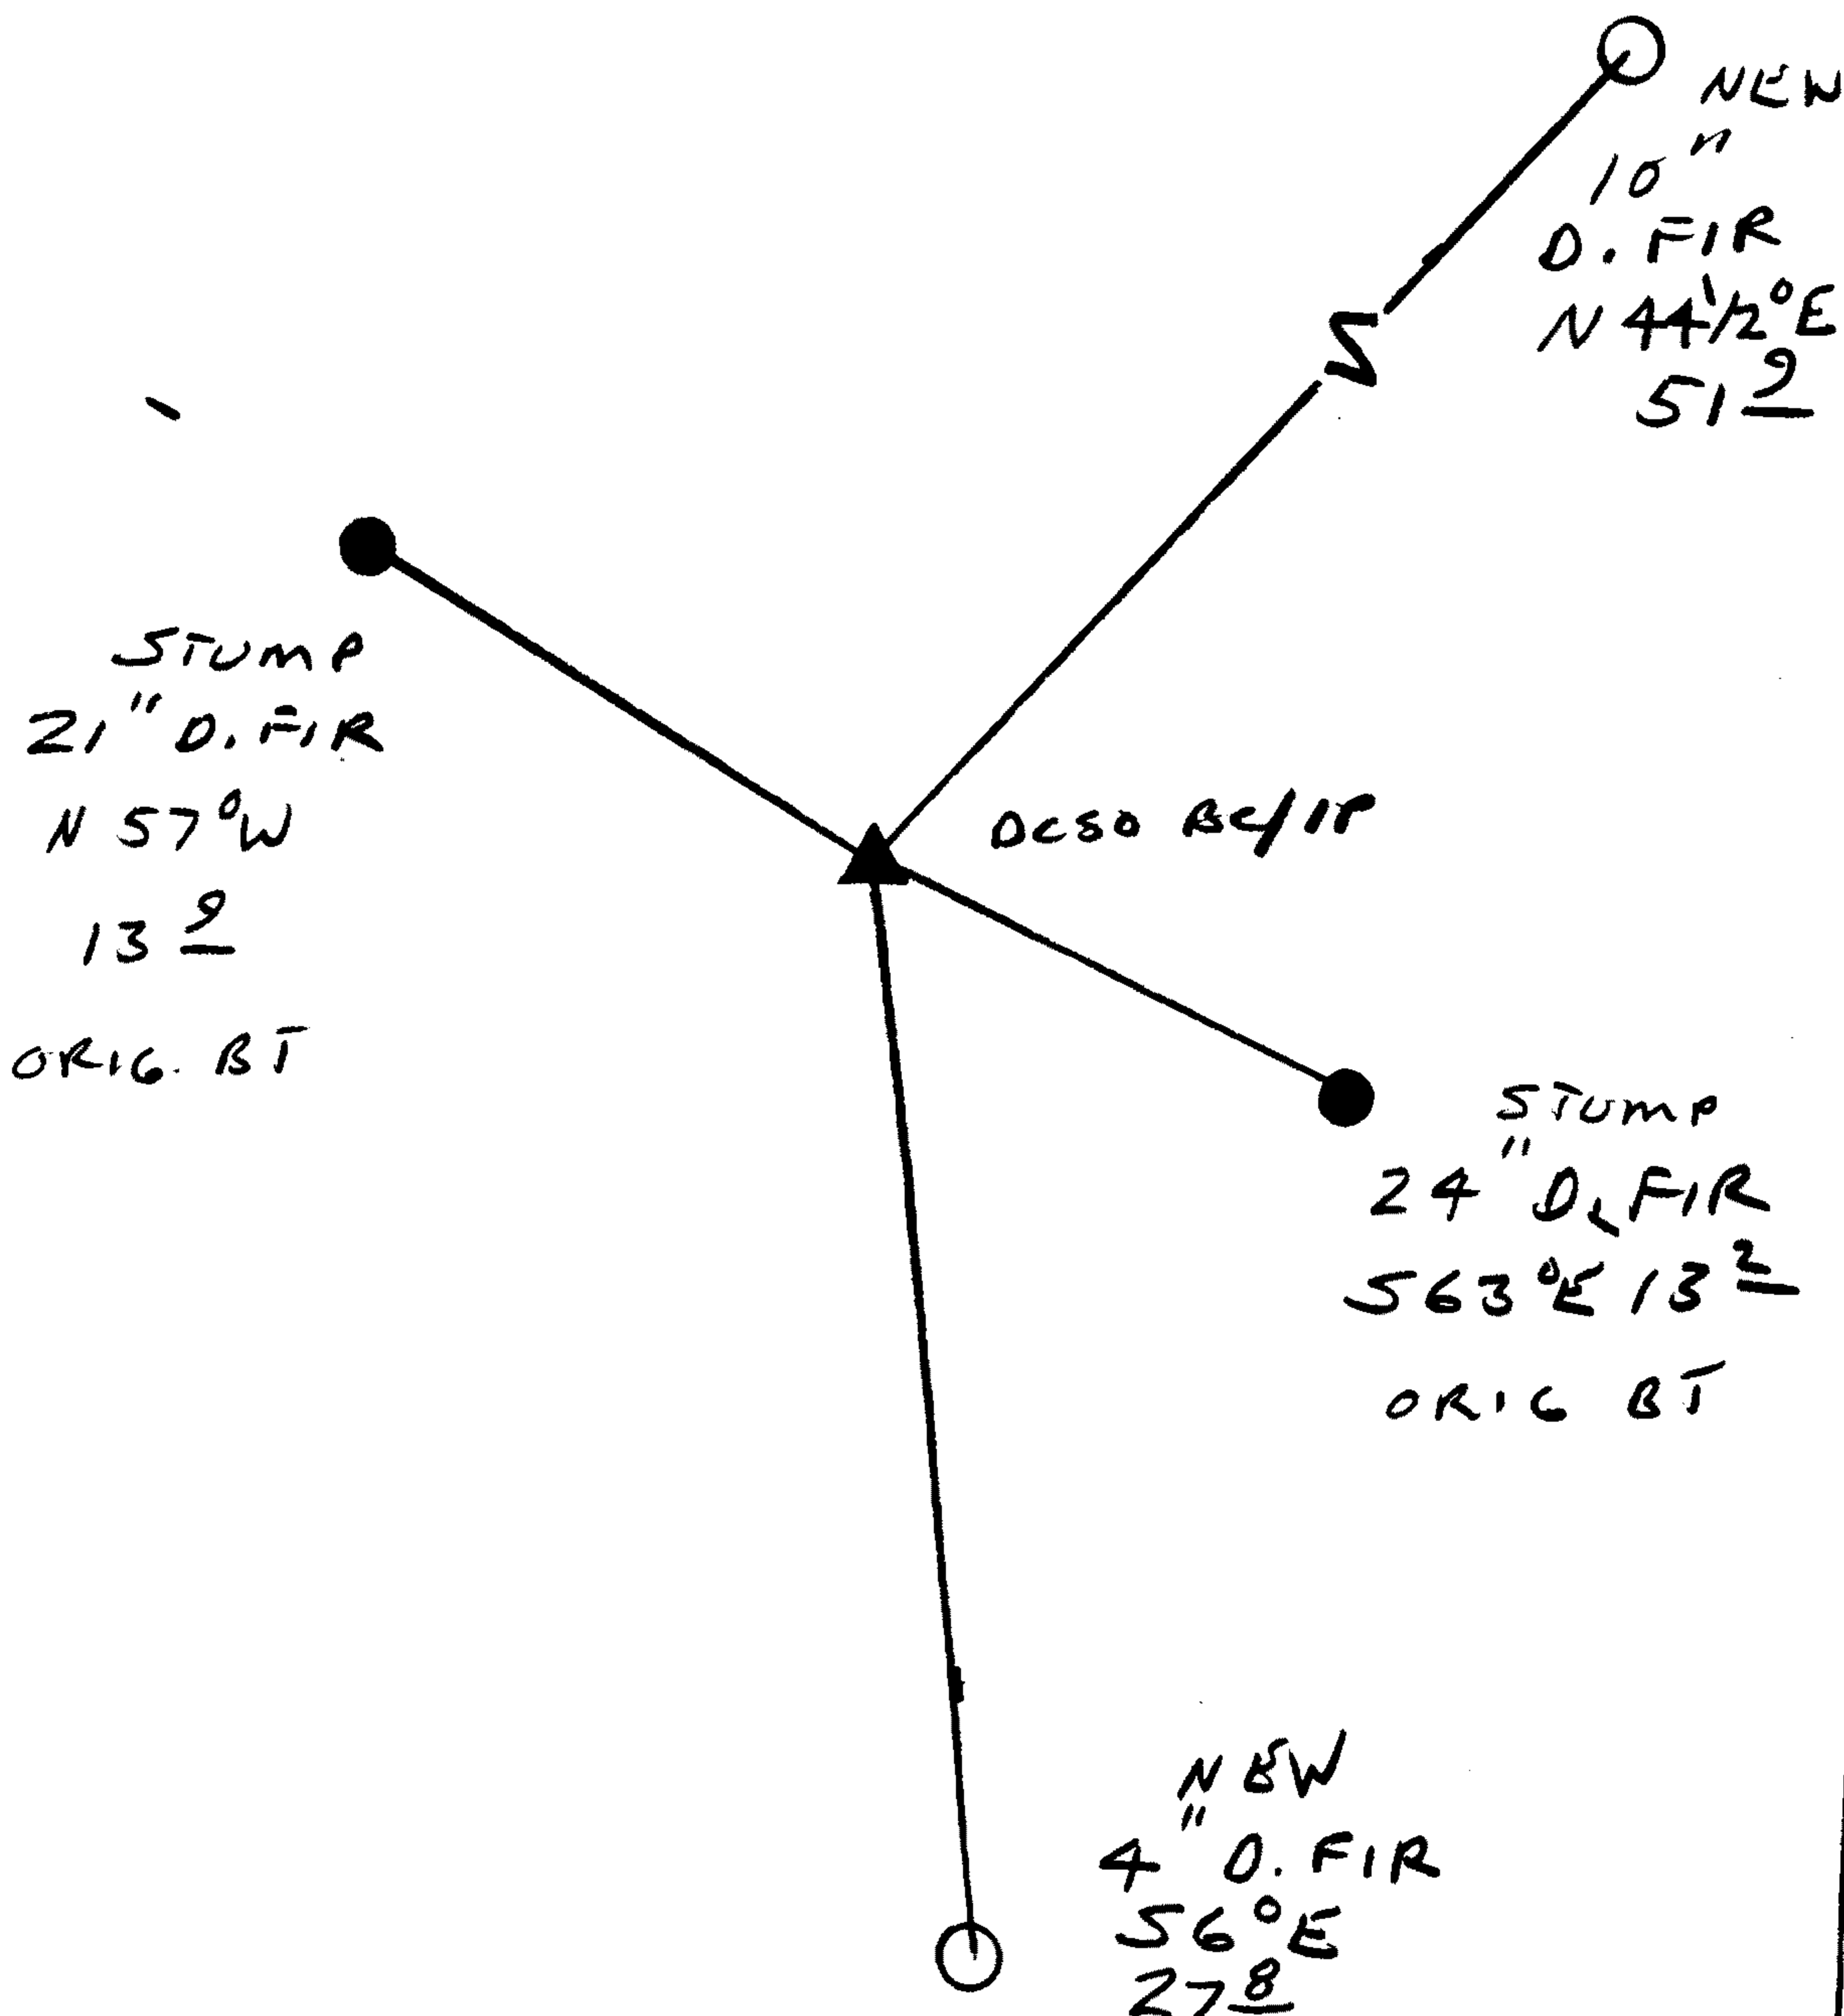

Comp. Declin. 18° E  
 Agency DCSO  
 Party Chief RANDALL W. SMITH  
 Notekeeper Randall W. Smith  
 Witnesses STEPHEN J. FLAUSE

Address

Surveyor's Seal

REGISTERED  
 PROFESSIONAL  
 LAND SURVEYOR

*Randall W. Smith*

OREGON  
 JULY 25, 1990  
 RANDALL W. SMITH  
 2469