



RENEWAL

Monument Set (Procedure and Description)

Monument Detail

NONE

N/A

New Accessories


6" DIA W. OAK DOUBLE BLAZED AND SCRIBED "SE DLC 49 CS BT"  
BEARS N 54 1/2° W, 22.7 FT.

17" DIA B. OAK DOUBLE BLAZED AND SCRIBED "SE DLC 49 CS BT"  
BEARS S 72 1/4° W, 46.3 FT.

Sketch of Monument, Accessories, and General Area

Location & Comments

WE PERPETUATED A  
LOCALLY ACCEPTED MONUMENT

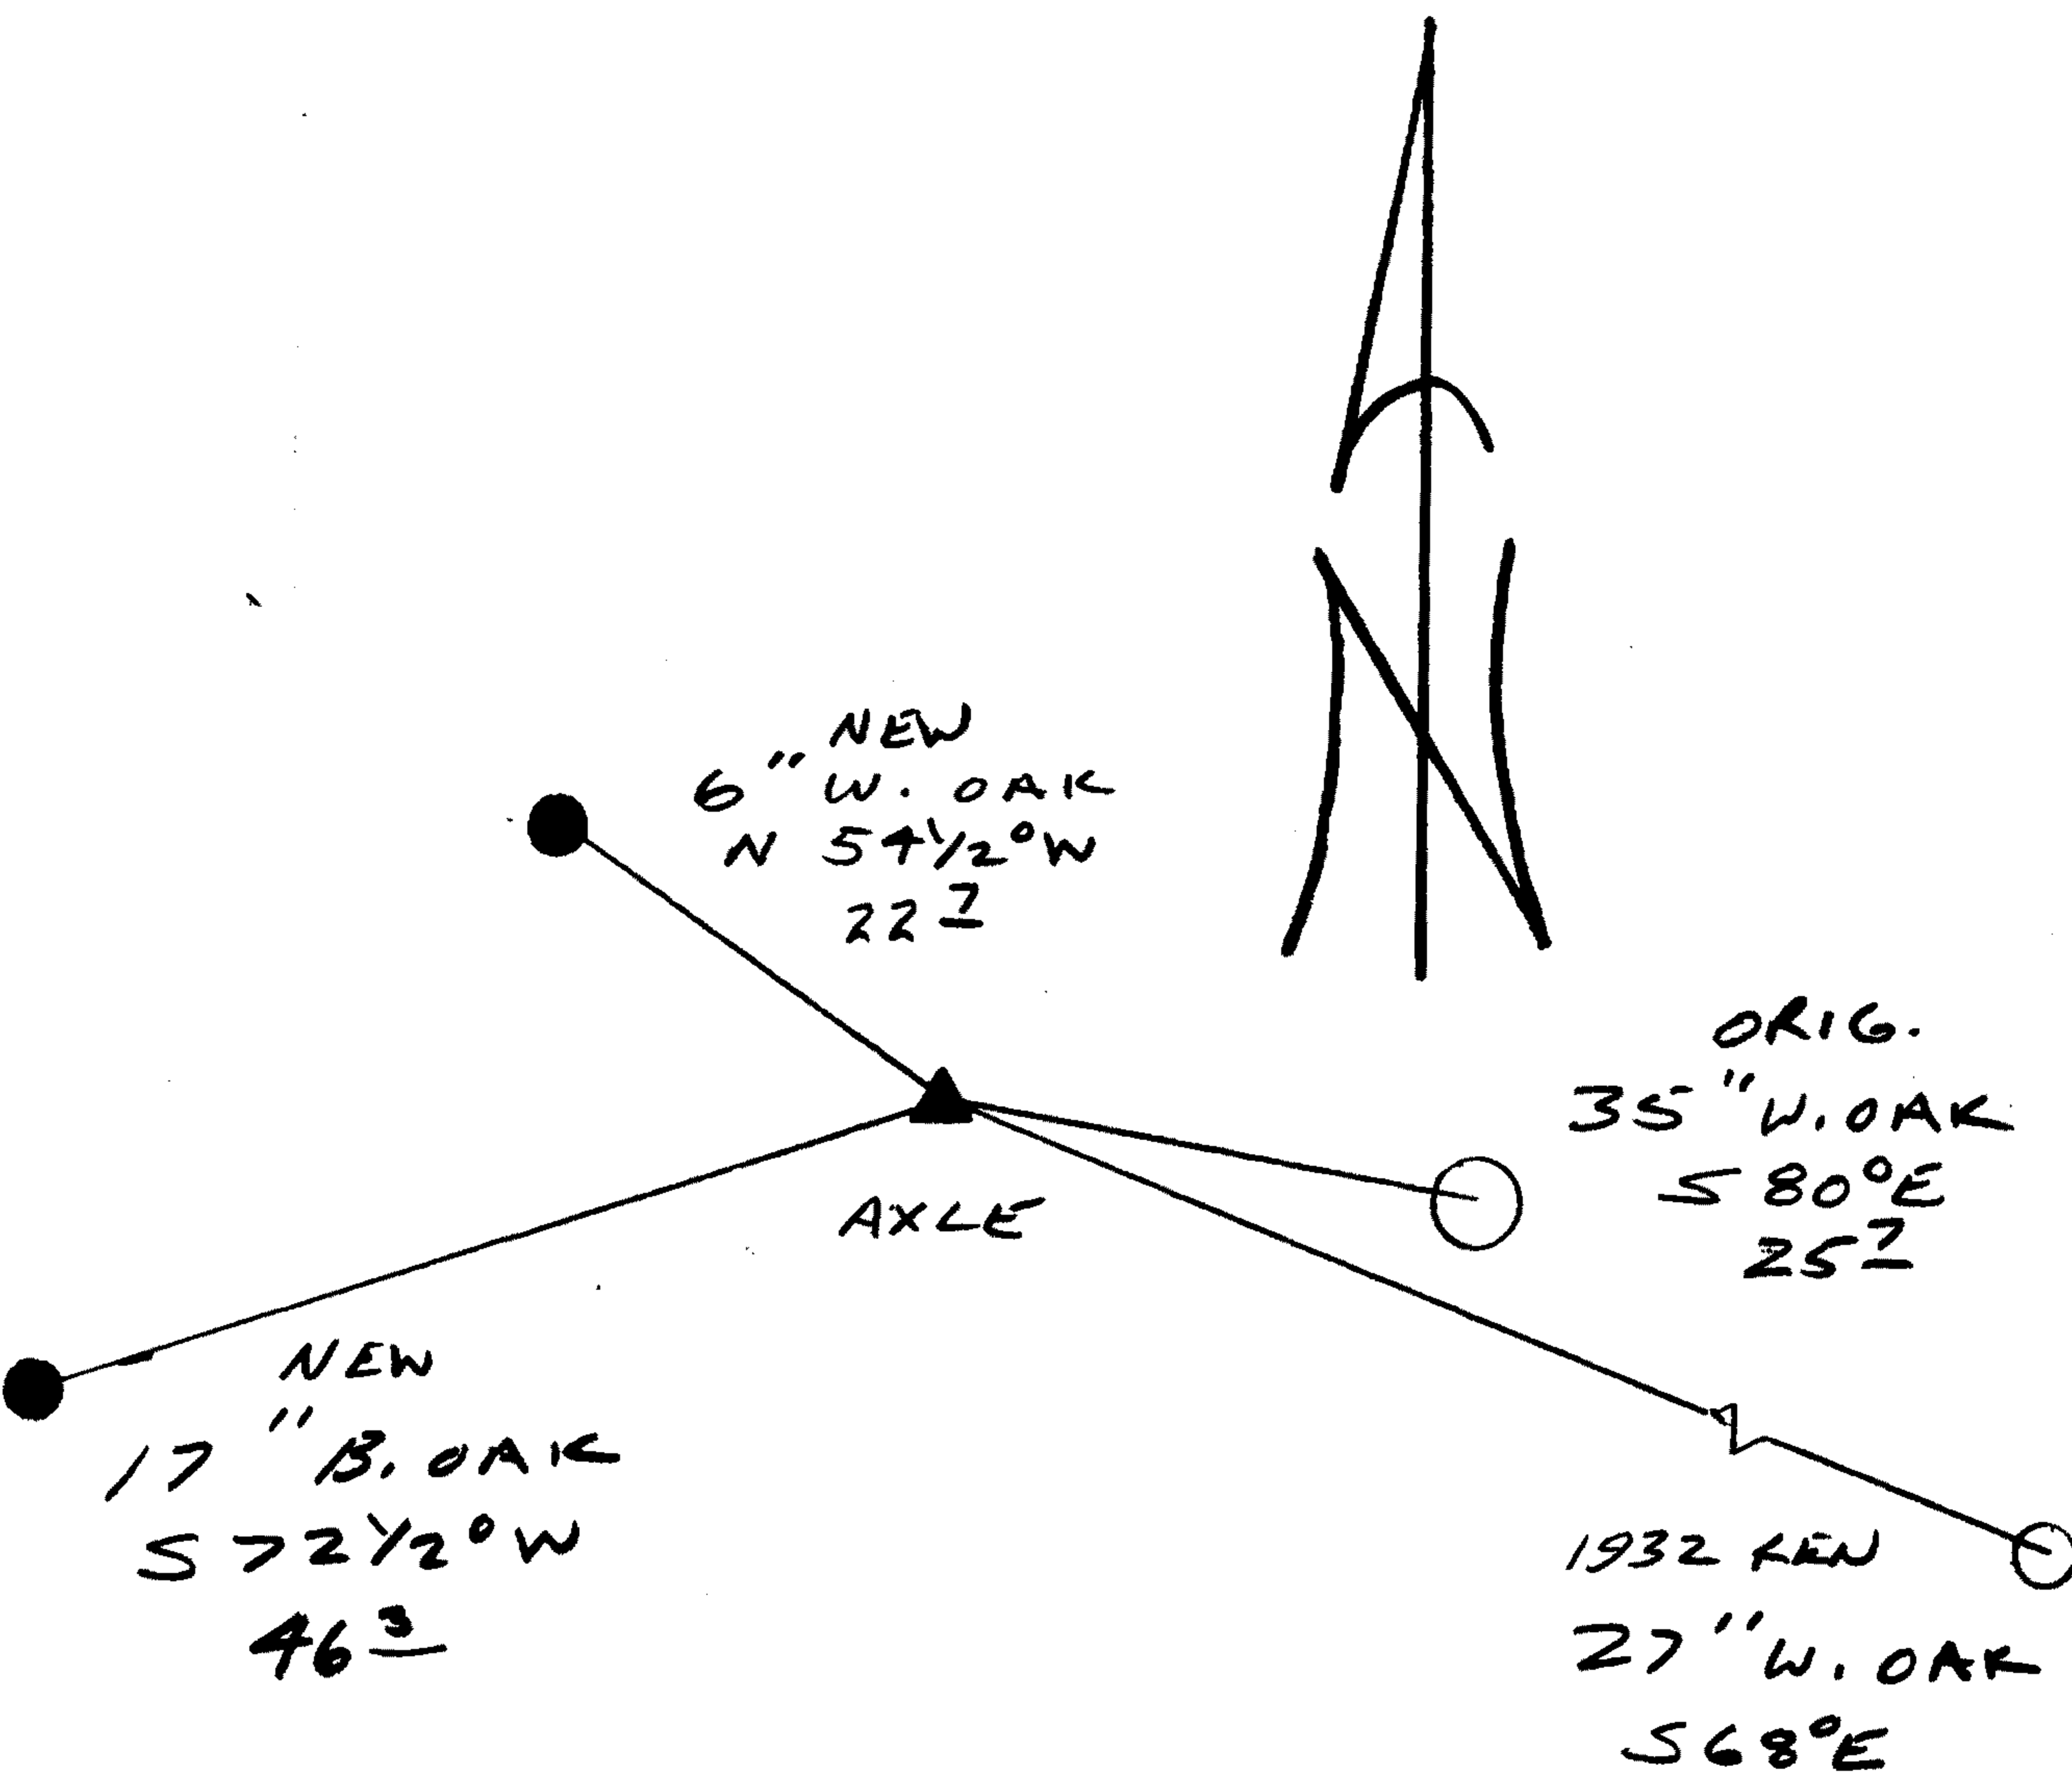

Comp. Declin. 18° E  
Agency DLCSO  
Party Chief RANDALL W SMITH  
Notekeeper Randall W Smith  
Witnesses STEPHEN J FLAUS

Address

Surveyor's Seal

REGISTERED  
PROFESSIONAL  
LAND SURVEYOR

Randall W Smith

OREGON  
JULY 25, 1990  
RANDALL W. SMITH  
2469

EXPIRES 12-31-94