



RENEWAL

Monument Set (Procedure and Description)

Monument Detail

NONE

N/A

New Accessories


15" I. CEDAR DOUBLE BLAZED AND SCRIBED "T28S R5W  
S3CS BT" BEARS S 66° E, 35.7 FT.

14" T. CEDAR DOUBLE BLAZED AND SCRIBED "T28S R5W  
S3CS BT" BEARS S 9 1/2° E, 43.5 FT

Sketch of Monument, Accessories, and General Area

Location & Comments

SW BT FROM 1917 FREAK  
RENEWAL NOT LOOKED FOR.

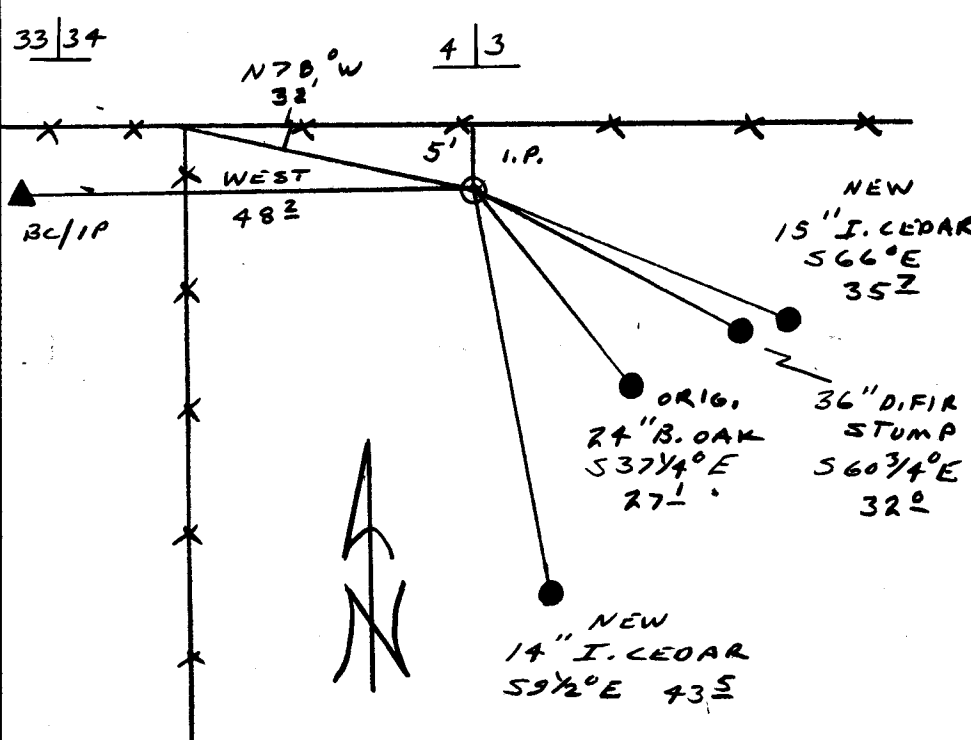

Comp. Declin. 18° E  
Agency OCSO  
Party Chief RANDALL W SMITH  
Notekeeper Randall W Smith  
Witnesses STEPHEN J FLAUS

Address

Surveyor's Seal

REGISTERED  
PROFESSIONAL  
LAND SURVEYOR

Randall W Smith  
EXPIRES 12-31-94

OREGON  
JULY 25, 1990  
RANDALL W. SMITH  
2489