



RENEWAL

Monument Detail

Monument Set (Procedure and Description)

REFERENCED POSITION 1" I.P. AND  
SET A 2 3/8" X 1/4" O.D X 32" LONG  
IRON PIPE AT REFERENCED POSITION.  
BC/IP PROTRUDES 8" ABOVE GROUND

1" I.P. MEASURES 20" LONG IS  
SET ALONG SOUTH SIDE OF  
BC/IP, PROTRUDES 3" ABOVE  
GROUND

DOUGLAS COUNTY SURVEYORS

T 275

1/4 S 31 R  
6  
W

T 285

1993


OFFICE

New Accessories

12" DIA W. OAK DOUBLE BLAZED AND SCRIBED "1/4 S 31 CS BT"  
BEARS N 2° E, 45.7 FT.

6" DIA. W. OAK DOUBLE BLAZED AND SCRIBED "1/4 S 31 CS BT"  
BEARS N 52 1/4° W, 18 1/2 FT.

Sketch of Monument, Accessories, and General Area

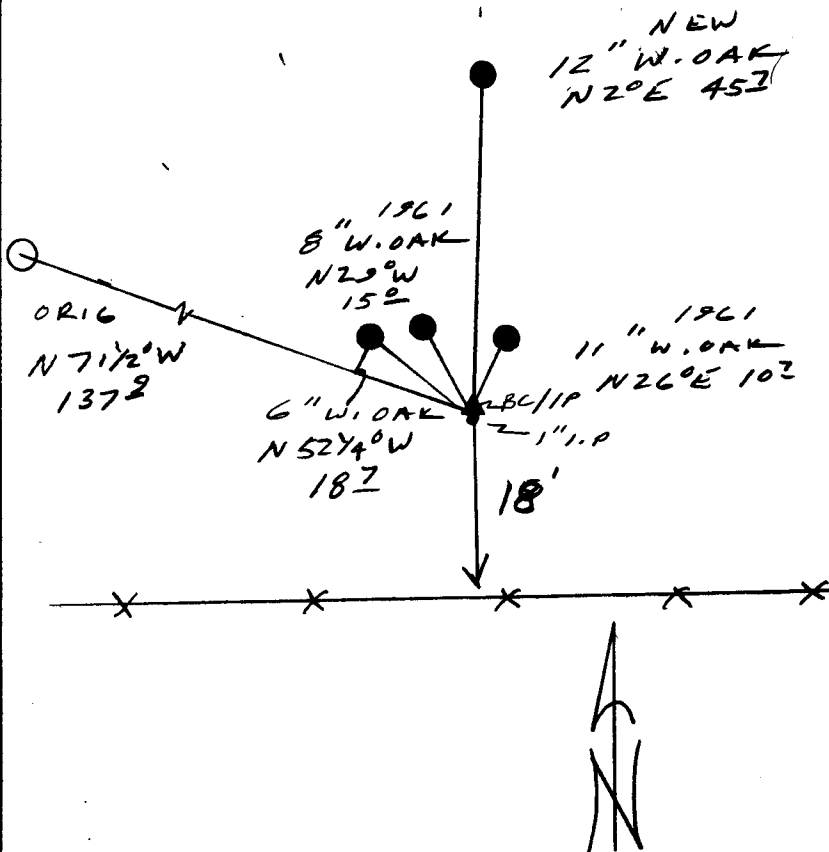

Location & Comments

Comp. Declin. 18° E  
Agency DCSO  
Party Chief RANDALL W SMITH  
Notekeeper Randall W Smith  
Witnesses STEPHEN J FLAUS

Address

Surveyor's Seal

REGISTERED  
PROFESSIONAL  
LAND SURVEYOR

*Randall W Smith*  
EXPIRES 12-31-94

OREGON  
JULY 25, 1990  
RANDALL W. SMITH  
2469