

Township 28S Range 6W Sec. 6 County DOUGLAS

JUN 9 1993

State OK Date 5-13-93 No. \_\_\_\_\_

Corner Designation

COUNTY SURVEYOR  
DOUGLAS COUNTY, ORE.

N 1/4 S6  
ONLY

Condition Report Only  
 Not Found  
 Renewed  
 Unrecorded  
 Surveyed In  
 Referenced Out

Previous Renewals 1961 BYRON

MONUMENT DETAIL

Monument(s) Found: (Condition and Source)

2 1/2" BRASS CAP ON A 1 1/2" O.D.  
IRON PIPE, PROTRUDING 18" ABOVE  
GROUND (1961 BYRON)

COUNTY SURVEYORS OFFICE

T 27S R 6W

NORTH

1/4 S6

T 28S

1961

Accessories Found:

12" NOW 26" DIA. W. OAK WITH A PREVIOUSLY OPENED BLAZE,  
SCRIBE VISIBLE "S", BEARS S 77° E, 156.4 FT  
(AGREES WITH REC) ORIG. BT

24" NOW 48" DIA 12' TALL B. OAK SNAG WITH A ROTTED OUT  
CENTER AND A HEALED BLAZE, (NOTE A NEW 7" DIA B. OAK  
IS GROWING OUT OF EAST EDGE OF BT) BEARS S 8 3/4° W,  
211.9 FT (REC S 8 3/4° W, 209.2 FT DIST POSSIBLE FACE  
MEASUREMENT) ORIG BT

15" NOW 23" DIA. W. OAK WITH A FULLY HEALED SINGLE  
BLAZE, BEARS S 73 1/2° E, 42.5 FT (AGREES WITH REC)  
1961 BYRON

14" NOW 20" DIA. W. OAK WITH A FULLY HEALED SINGLE  
BLAZE BEARS S 55° W, 35.8 FT (AGREES WITH REC)  
1961 BYRON

140 700 T28-6  
149 100 T27-6  
C

RENEWAL

Monument Set (Procedure and Description)

Monument Detail


NONE

N/A

New Accessories

20" DIA. W. OAK DOUBLE BLAZE AND SCRIBED "1/4 S6CS BT"  
BEARS S16 3/4° E, 51.7 FT

Sketch of Monument, Accessories, and General Area

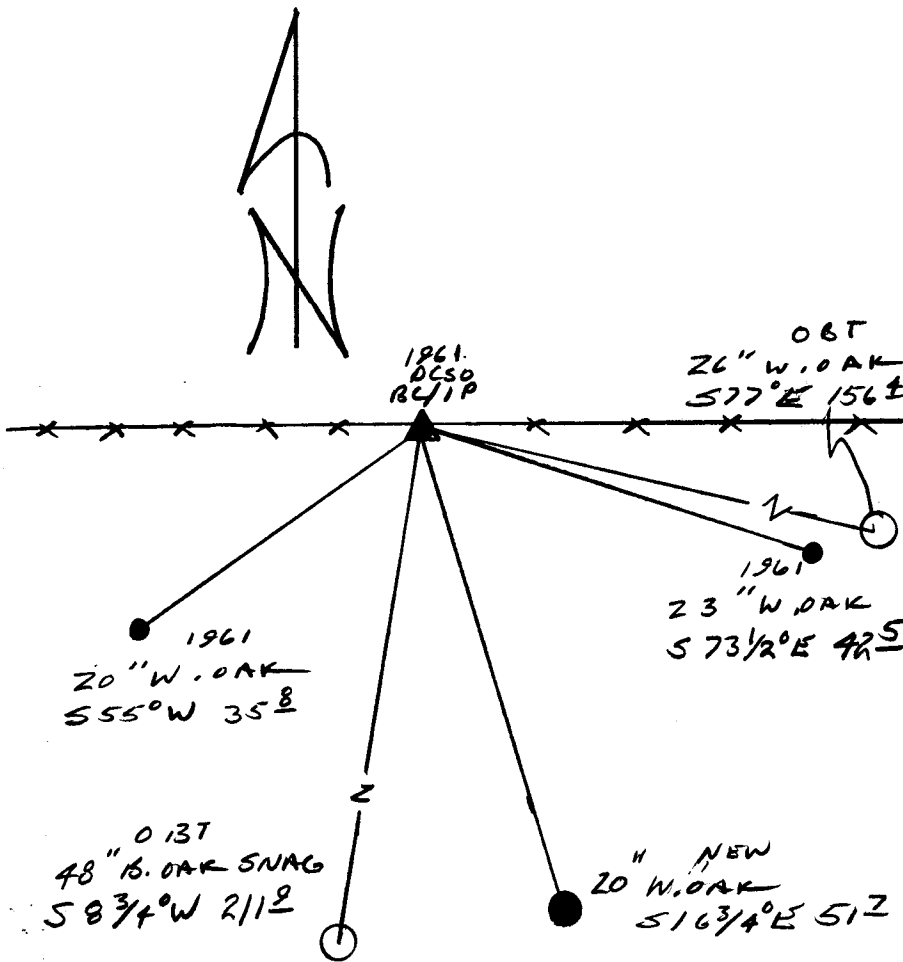

Location & Comments

CORNER LIES IN AN  
EAST - WEST FENCE  
LINE

Comp. Declin. 18° E  
Agency DCSO  
Party Chief RANDALL W SMITH  
Notekeeper Randall W Smith  
Witnesses STEPHEN J FLAUSE

Address

REGISTRY'S Seal  
**PROFESSIONAL  
 LAND SURVEYOR**  
*Randall W Smith*  
 EXPIRES 12-31-94  
 OREGON  
 JULY 25, 1990  
**RANDALL W. SMITH**  
 2469