

GOVERNMENT CORNER RESTORATION FORM

FILED

Township 27S Range SW Sec. 19 County DOUGLAS

State OR Date 5-3-93 No. _____

MAY 12 1993

Corner Designation

DLC
40

COUNTY SURVEYOR

DOUGLAS COUNTY, ORE.

Condition Report Only

Not Found

Renewed

Unrecorded

Surveyed In

Referenced Out

MONUMENT DETAIL

Previous Renewals 1950, RICHARDSON, 1978 MONHEAN

Monument(s) Found: (Condition and Source)

2 1/2" DIA. BRASS CAP ON A 1 1/2" O.D. IRON PIPE, PROTRUDES 8" ABOVE GROUND, (1950 RICHARDSON)

(NOTE LINKS ON ~~BT~~ BRASS CAP MARKED AS IF SE COR)

COUNTY SURVEYORS OFFICE

SW DLC
40

Accessories Found:

1950 RICHARDSON BT'S
2 1/2" NOW 40" DIA. B. OAK WITH A FULLY HEALED BLAZE BEARS S 56 1/4° W, 13.0 FT. (AGREES WITH REC)

18" NOW 26" DIA. B. OAK WITH A FULLY HEALED BLAZE BEARS S 66 1/4° E, 15.8 FT (AGREES WITH 1978 RENEWAL)

Monument Set (Procedure and Description)

Monument Detail

NONE

N/A


315

New Accessories

6" DIA. W. OAK DOUBLE BLAZED AND SCRIBED "SW DLC 40 CS BT"
BEARS S 31° E, 31.5 FT

9" DIA. W. OAK DOUBLE BLAZED AND SCRIBED "SW DLC 40 CS BT"
BEARS S 39° W, 38.0 FT

Sketch of Monument, Accessories, and General Area

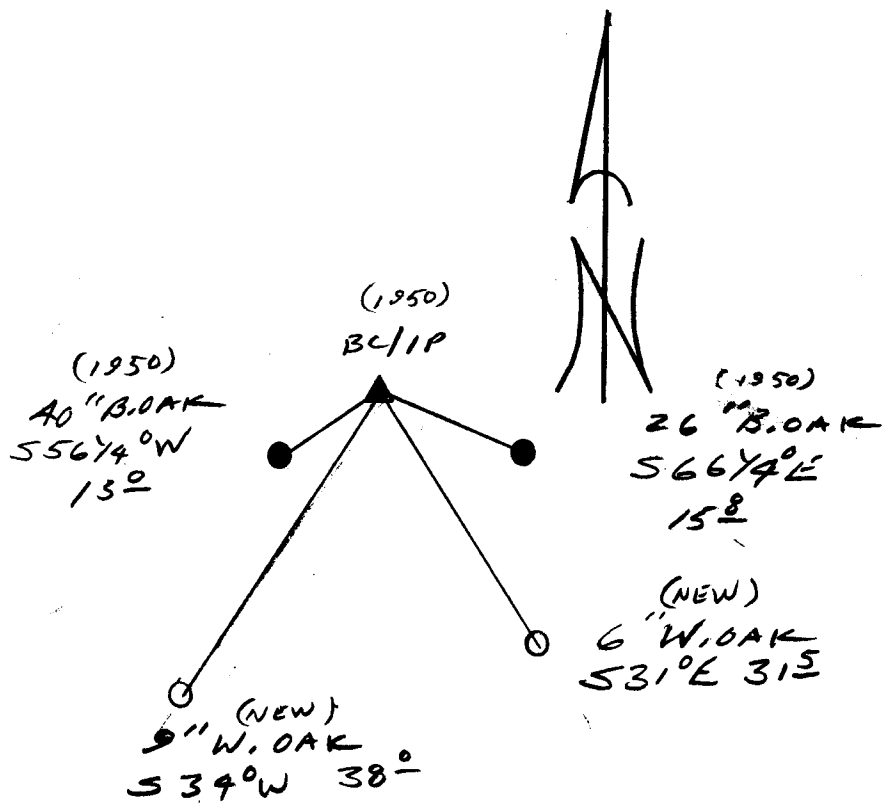

Location & Comments

Comp. Declin. 18° E
 Agency DLGO
 Party Chief RANDALL W. SMITH
 Notekeeper Randall W. Smith
 Witnesses STEPHEN J. FLAVER

Address

Surveyor's Seal

REGISTERED
 PROFESSIONAL
 LAND SURVEYOR

Randall W. Smith
 EXPIRES 12-31-94

OREGON
 JULY 25, 1990
 RANDALL W. SMITH
 2469