

Monument Set (Procedure and Description)

Monument Detail

NONE


N/A

New Accessories

25" ALDER BARK SCRIBED "N Y 4 S 3 CS BT" BEARS N 10 1/2° W, 173 FT.

MULTI TRUNK ASH; BASE OF NORTHERLY 14" DIA. ASH; DOUBLE BLAZED AND SCRIBED "Y 4 S 3 CS BT" BEARS S 49° E 46.8 FT TO CENTER AT BASE OF NE TRUNK.

Sketch of Monument, Accessories, and General Area

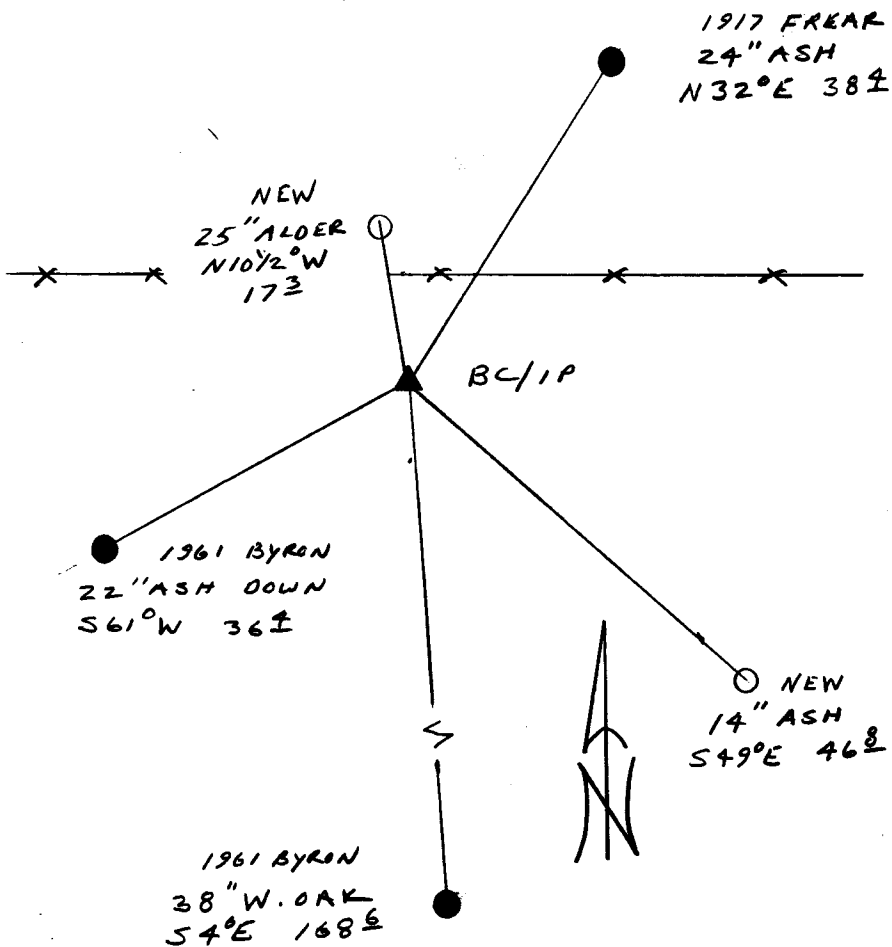

Location & Comments

Comp. Declin. 18°E
Agency DC SO
Party Chief RANDALL W SMITH
Notekeeper Randall W Smith
Witnesses STEPHEN J FLAUSE

Address

Surveyor's Seal

REGISTERED PROFESSIONAL LAND SURVEYOR

Randall W Smith
EXPIRES 12-31-94

OREGON
JULY 25, 1990
RANDALL W. SMITH
2469