

GOVERNMENT CORNER RESTORATION FORM

FILED

JS

Township 27S Range 5W Sec. 33 County DOUGLAS

State OR Date 4-22-93 No. _____

MAY 12 1993

Corner Designation

COUNTY SURVEYOR
DOUGLAS COUNTY, ORE.

S33 | S34

- Condition Report Only
- Not Found
- Renewed
- Unrecorded
- Surveyed In
- Referenced Out

Previous Renewals 1961 DCSO

MONUMENT DETAIL

Monument(s) Found: (Condition and Source)

2 1/2" BRASS CAP ON A 1 1/4" O.D.
IRON PIPE, PROTRUDING 18" ABOVE
GROUND. (1961 DCSO)

COUNTY SURVEYORS OFFICE

T27S R5W

S33 | S34

T28S

1961

Accessories Found:

10" NW 27" DIA B. OAK WITH A FULLY HEALED SINGLE
BLAZE BEARS N49°E, 41.5 FT (REC. N51°E, 42.2 FT)
ORIG 'BT

16" NW 20" DIA. D. FIR WITH A FULLY HEALED DOUBLE
BLAZE BEARS N72°W, 8.0 FT (REC. N39°W, 8.0 FT)
1961 DCSO

1" O.D IRON PIPE PROTRUDING 6" ABOVE GROUND,
(NW COR SEC 3 T28S R5W) BEARS EAST 48.2 FT
(AGREES WITH ORIG. REC.)

Monument Set (Procedure and Description)

Monument Detail

NONE


N/A

New Accessories

18" DIA MADRONE BARK SCRIBED "T27S R5W S34 CS BT"
BEARS N 31° E, 39.3 FT.

Sketch of Monument, Accessories, and General Area

Location & Comments

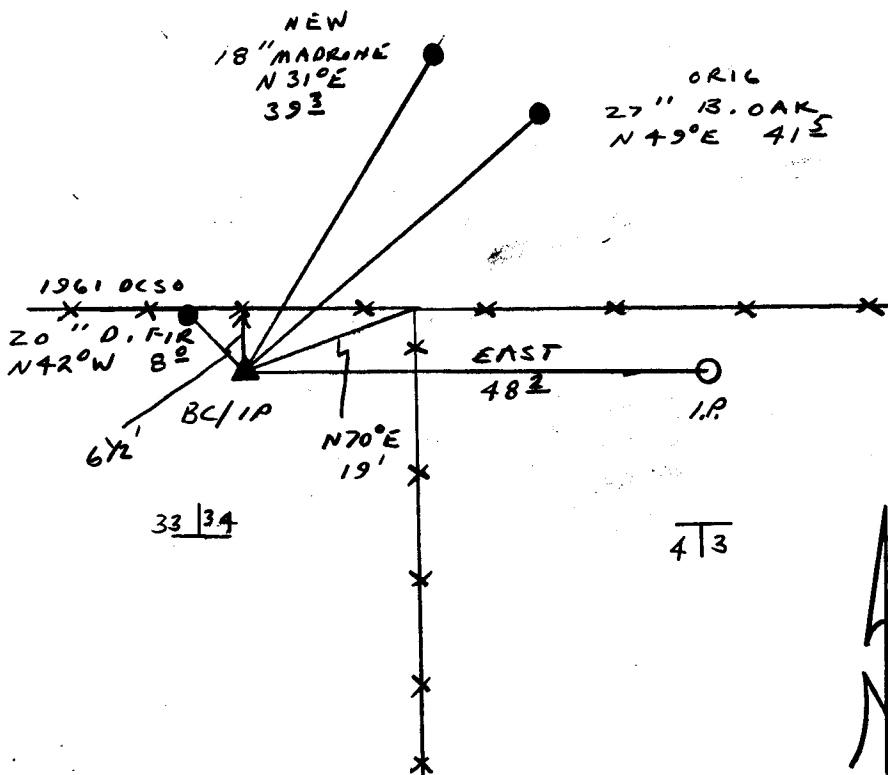

Comp. Declin. 18° E
 Agency DCSO
 Party Chief RANDALL W. SMITH
 Notekeeper Randall W. Smith
 Witnesses STEPHEN J. FLAUSCH

Address

Surveyor's Seal

REGISTERED
 PROFESSIONAL
 LAND SURVEYOR

Randall W. Smith
 EXPIRES 12-31-94

OREGON
 JULY 25, 1990
 RANDALL W. SMITH
 2469