



RENEWAL

Monument Set (Procedure and Description)

Monument Detail

NOTE

STONE MONUMENT IS FIRMLY SET IN GOOD CONDITION


N/A

New Accessories

12" DIA. W. OAK DOUBLE BLAZED AND SCRIBED "Y4S3 CS BT" BEARS N42°W, 2.7 FT

12" DIA. W. OAK DOUBLE BLAZE AND SCRIBED "Y4S2 CS BT" BEARS S16°E, 33.1 FT

Sketch of Monument, Accessories, and General Area

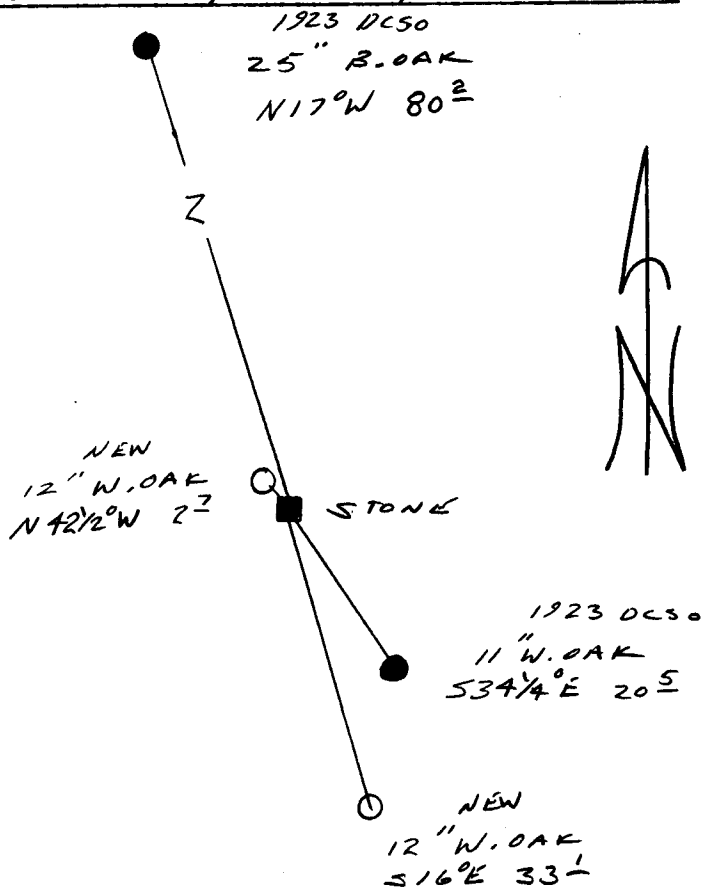

Location & Comments

Comp. Declin. 18°E  
 Agency DCSO  
 Party Chief RANDALL W SMITH  
 Notekeeper Randall W Smith  
 Witnesses STEPHEN J FLAUSE

Address

Surveyor's Seal

REGISTERED  
 PROFESSIONAL  
 LAND SURVEYOR  
*Randall W Smith*  
 EXPIRES 12-31-94  
 OREGON  
 JULY 25, 1990  
 RANDALL W. SMITH  
 2469