

GOVERNMENT CORNER RESTORATION FORM

FILED 8

Township 27S Range 6W Sec. 32 County DOUGLAS

JUN 10 1993

State OR Date 5-13-93 No. _____

Corner Designation

COUNTY SURVEYOR
DOUGLAS COUNTY, ORE.

1/4 532 | 533

Condition Report Only
 Not Found
 Renewed
 Unrecorded
 Surveyed In
 Referenced Out

Previous Renewals 1961 BYRON

Monument(s) Found: (Condition and Source)

2 1/2" BRASS CAP ON A 1 1/2" O.D.
IRON PIPE, PROTRUDING 13" ABOVE
GROUND. (1961 BYRON)

COUNTY SURVEYORS OFFICE

T 27S R 6W

1/4 532 | 533

1961

Accessories Found:

18" Y. OAK NOW 90" DIA. B. OAK WITH A FULLY HEALED
PREVIOUSLY OPENED BLAZE, BEARS N 52 1/2° E, 35.0 FT
(REC N 49° E, 35.0 FT) ORIG BT

9" NOW REMAINS OF ROTTED ROOTS, BEAR S 66° W,
23.8 FT (AGREES WITH REC) ORIG BT

12" NOW 14" DIA. W. OAK WITH A FULLY HEALED DOUBLE BLAZE,
BEARS N 15° E, 20.5 FT (AGREES WITH REC) 1961 BYRON

10" NOW 12" DIA. W. OAK WITH A FULLY HEALED DOUBLE BLAZE,
BEARS N 58° W, 31.8 FT (REC N 58° W 32.9 FT DISTANCE
HITS TRUNK AT A HORIZONTAL FROM BC/IP) 1961 BYRON

Monument Set (Procedure and Description)

Monument Detail


NONE

N/A

New Accessories

11" W. OAK DOUBLE BLAZED AND SCRIBED "1/4532 CS BT"
BEARS N 5 3/4° W, 39.4 FT.

Sketch of Monument, Accessories, and General Area

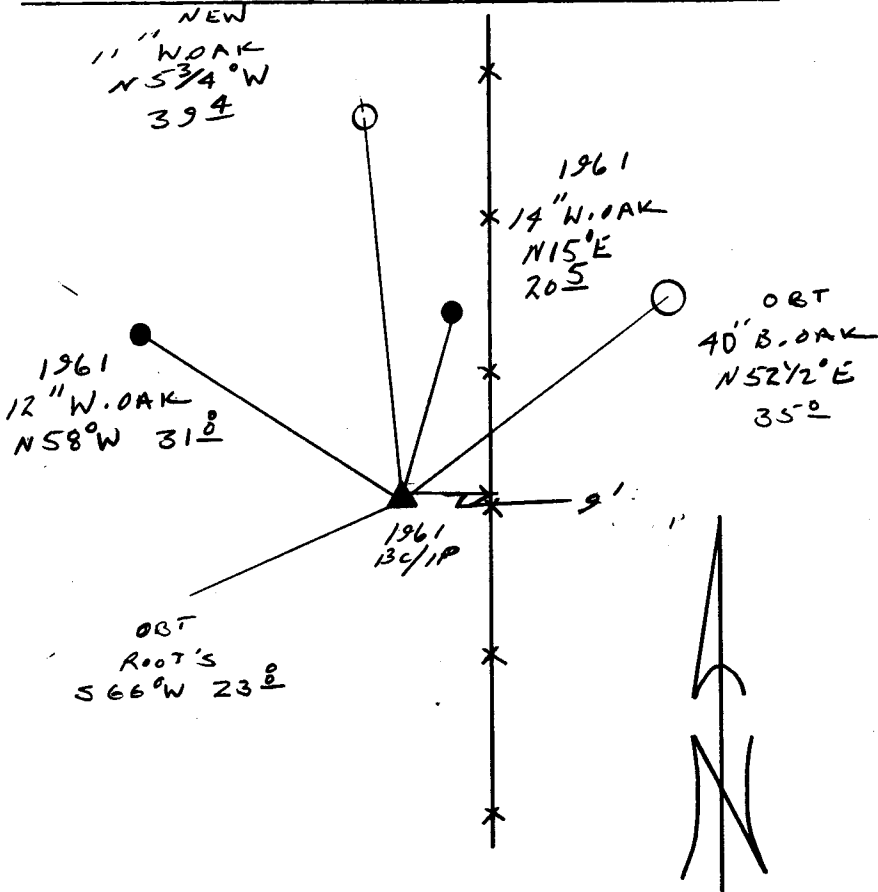

Location & Comments

CORNER LIES 2 FT
WEST OF A NORTH -
SOUTH FENCE LINE

Comp. Declin. 18° E
Agency DCSO
Party Chief RANDALL W. SMITH
Notekeeper Randall W. Smith
Witnesses STEPHEN J. FLAYSE

Address

Surveyor's Seal

REGISTERED
PROFESSIONAL
LAND SURVEYOR

Randall W. Smith
EXPIRES 12-31-94

OREGON
JULY 25, 1990
RANDALL W. SMITH
2489