

GOVERNMENT CORNER RESTORATION FORM

FILED 8

Township 27S Range 6W Sec. 19 County DOUGLAS

JUN 14 1993

State OR Date 5-5-93 No. _____

Corner Designation

COUNTY SURVEYOR
DOUGLAS COUNTY, ORE.

S24 | S19
S25 | S30

Condition Report Only
 Not Found
 Renewed
 Unrecorded
 Surveyed In
 Referenced Out

Previous Renewals 1960 BYRON

Monument(s) Found: (Condition and Source)

2 1/2" DIA BRASS CAP ON A
1 1/2" O.D. IRON PIPE, PROTRUDING
18" ABOVE GROUND. (1960 BYRON)

COUNTY SURVEYORS OFFICE

T 27S
R 7 W S24 | S19
S25 | S30 R 6 W
1960

Accessories Found:

22" NOW 39" DIA W. OAK WITH A HEALED BLAZE,
BEARS N46 1/2° W, 51.0 FT (REC N46 1/2° W, 50.2 FT)
ORIG. BT

NO OTHER ORIG. BT'S FOUND.

1960 BYRON BT'S

16" NOW 23" DIA. B. OAK WITH A FULLY HEALED DOUBLE BLAZE
BEARS S56 1/2° W, 64.8 FT (AGREES WITH REC.)

11" NOW 13" DIA. B. OAK WITH A FULLY HEALED DOUBLE BLAZE
BEARS N24° W, 62.3 FT (AGREES WITH REC.)

14" NOW 16" DIA. W. OAK WITH A FULLY HEALED DOUBLE BLAZE
BEARS N39° E, 65.6 FT (AGREES WITH REC.)

15" NOW 22" DIA. W. OAK WITH A FULLY HEALED DOUBLE BLAZE
BEARS S49° E, 79.7 FT (REC. S51° E, 79.7 FT)

RENEWAL

Monument Detail

Monument Set (Procedure and Description)


SURROUND B&IP WITH A 24" DIA
12" HIGH MOUND OF STONE.

N/A

New Accessories

NONE

Sketch of Monument, Accessories, and General Area

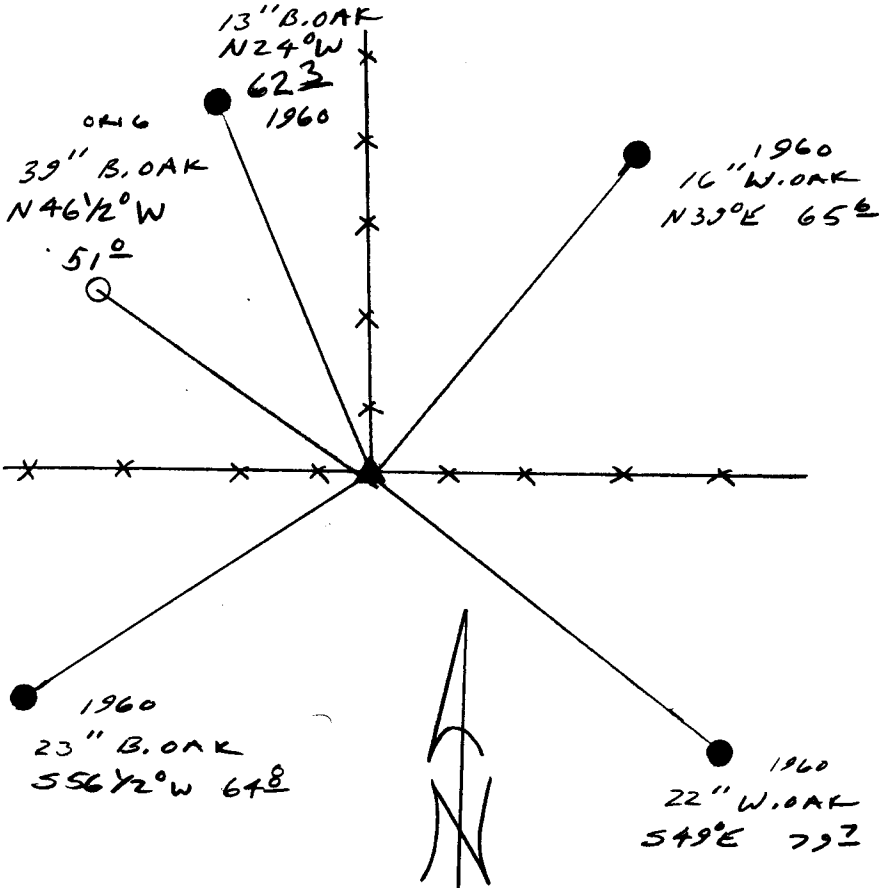

Location & Comments

Comp. Declin. 18°E
 Agency DLS
 Party Chief RANDALL W. SMITH
 Notekeeper Randall W. Smith
 Witnesses STEPHEN J. FLAUSK

Address

REGISTERED **Surveyor's Seal**
 PROFESSIONAL
 LAND SURVEYOR
Randall W. Smith
 EXPIRES 12-31-94
 OREGON
 JULY 25, 1990
 RANDALL W. SMITH
 2469