

RENEWAL

Monument Detail

Monument Set (Procedure and Description)

SET 5/8" BY 30" LONG IRON ROD, 20"
 INTO GROUND. I.R. IS SURROUNDED
 BY A 2 FT DIA BY 9" HIGH
 MOUND OF STONE

GROUND IS HARD AND ROCKY, UNABLE
 TO SET BRASS CAP IRON PIPE
 MONUMENT.


N/A

New Accessories

13" W. OAK DOUBLE BLAZED AND SCRIBED "1/4 SICS BT"
 BEARS S 48° W, 54.4 FT.

6" W. OAK DOUBLE BLAZED AND SCRIBED "1/4 SICS BT"
 BEARS S 30° W, 23.4 FT.

Sketch of Monument, Accessories, and General Area

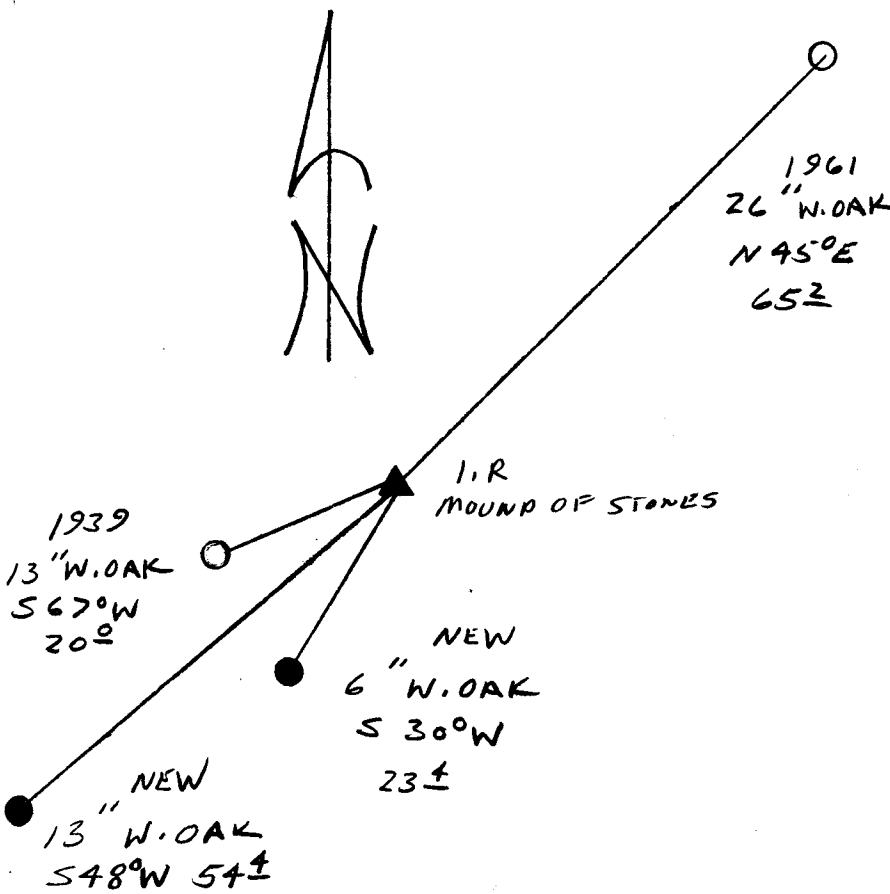

Location & Comments

Comp. Declin. 18° E
 Agency DCSO
 Party Chief RANDALL W SMITH
 Notekeeper Randall W Smith
 Witnesses STEPHEN J PLASE

Address

Surveyor's Seal
 REGISTERED
 PROFESSIONAL
 LAND SURVEYOR

Randall W Smith
 EXPIRES 12-31-94

OREGON
 JULY 25, 1990
 RANDALL W. SMITH
 2469