

GOVERNMENT CORNER RESTORATION FORM

FILED *pc*

Township 27S Range 6W Sec. 16 County DOUGLAS

State OR Date 8-31-93 No. _____

SEP 9 1993

Corner Designation

SW COR
DLC
59

COUNTY SURVEYOR
DOUGLAS COUNTY, OR

- Condition Report Only
- Not Found
- Renewed
- Unrecorded
- Surveyed In
- Referenced Out

Previous Renewals 1928 BBI, 1993 SHANER

Monument(s) Found: (Condition and Source)

A SANDSTONE MONUMENT
PROTRUDING 3" ABOVE GROUND.
TOP MEASURES 6" X 5"
ORIG. STONE

N/A

Accessories Found:

8" NOW 16" DIA 3/2' HIGH ROTTED OAK STUMP; WITH
ILLEGIBLE REVERSE SCRIBING, BEARS N43°E,
40.9 FT (AGREES WITH REC) 1928 BBI

8" NOW 14" DIA W. OAK WITH A FULLY HEALED SINGLE
BLAZE, BEARS N70°E, 42.9 CREC N70°E, 43.6
DISTANCE IS A SLOPE MEASUREMENT) 1928 BBI

10" DIA. W. OAK WITH A RECENT SINGLE BLAZE,
SCRIBING VISIBLE "SWC CL50 BT" BEARS N45°E,
45.2 FT (REC N48°E, 45.2 FT) 1998 SHANER

276 050050

RENEWAL

Monument Detail

Monument Set (Procedure and Description)

STONE REFERENCED, FD UNMARKED AND MEASURED 15" LONG WHEN REMOVED.
 A 2 3/8" DIA DC50 BRASS CAP ON A 1 3/8" DIA BY 32" LONG IRON PIPE IS SET AT REFERENCED POSITION, BC/IP PROTRUDE 9" ABOVE GROUND.

CORNER STONE IS SET ALONG NORTH EDGE OF BC/IP, PROTRUDING 4" ABOVE GROUND

DOUGLAS COUNTY SURVEYORS

T 275

R
6
W

DLK
50

SW COR


1993
OFFICE

New Accessories

10" DIA. B. OAK DOUBLE BLAZED AND SCRIBED "SW DLK 50 CS BT"
 BEARS N25 1/2° E, 33.6 FT

6" DIA. W. OAK DOUBLE BLAZED AND SCRIBED "SW DLK 50 CS BT"
 BEARS N55 1/2° E, 31.2 FT

Sketch of Monument, Accessories, and General Area

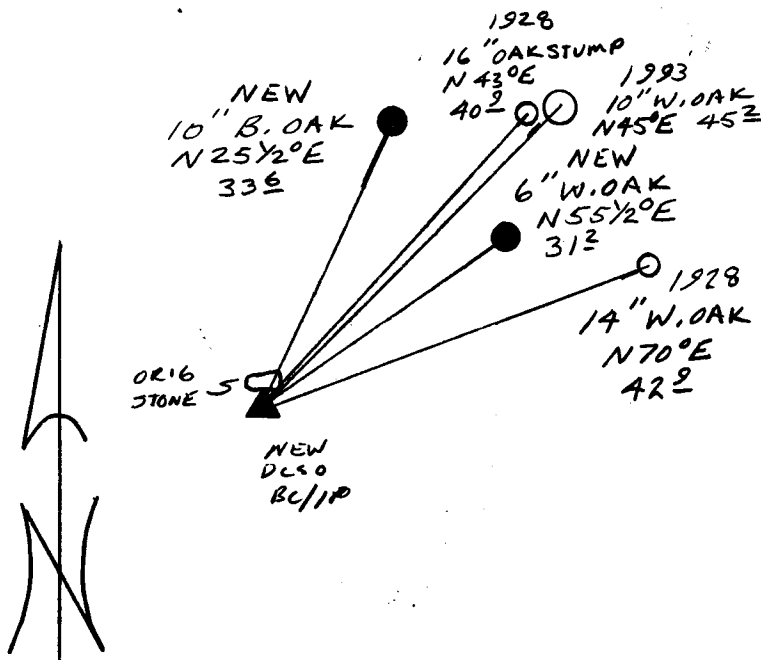

Location & Comments

TWO FENCE POST SET
 BY SHANK FOUND
 NORTH 1 FT
 WEST 1 FT

Comp. Declin. 18° E
 Agency DC50
 Party Chief RANDALL W SMITH
 Notekeeper Randall W Smith
 Witnesses STEPHEN + FLAUSÉ

Address

Surveyor's Seal

REGISTERED
 PROFESSIONAL
 LAND SURVEYOR

Randall W Smith
 EXPIRES 12-31-94

OREGON
 JULY 25, 1990
 RANDALL W. SMITH
 2488