



RENEWAL

Monument Detail

Monument Set (Procedure and Description)

POSITION OF IRON PIPE IS REFERENCED  
I.P. MEASURED 12" LONG. A 2 3/8" DIA  
ALSO BRASS CAP ON A 1 3/8" DIA. BY  
32" LONG IRON PIPE IS SET AT  
REFERENCED POSITION. DC/IP PROTRUDES  
6" ABOVE GROUND

DOUGLAS COUNTY SURVEYORS OFFICE

T 29 S R 4 W



DLC 39

1993

I.P. IS SET ALONG NORTH EDGE  
OF ALSO DC/IP, PROTRUDES 3"  
ABOVE GROUND

New Accessories


17" DIA. J. PINE DOUBLE BLAZED AND SCRIBED "NWINTDLC39CSBT"  
BEARS N 45 1/2° E, 14.6 FT

13" DIA. DOUBLE TRUNKED MADRONE DOUBLE BLAZED AND SCRIBED "NWINTDLC39CSBT"  
ON EAST TRUNK, ROOT CROWN BEARS WEST 23.2 FT

4" DIA. W. FIR DOUBLE BLAZED AND SCRIBED "X BT" BEARS N 45 1/2° E, 48.1 FT

27" DIA. J. PINE DOUBLE BLAZED AND SCRIBED "NWINTDLC39CSBT"  
BEARS N 9° W, 30.8 FT

Sketch of Monument, Accessories, and General Area

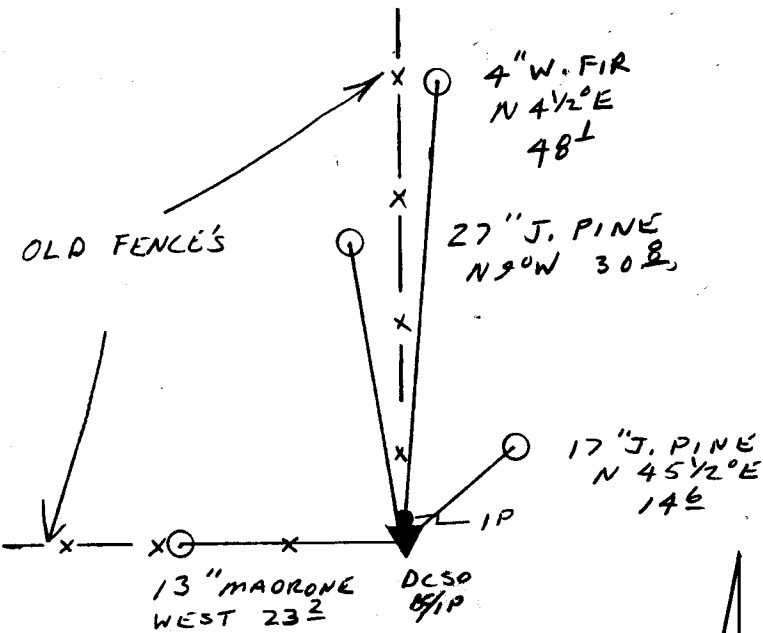

Location & Comments

CORNER LIES AT THE  
INTERSECTION OF OLD  
MOSTLY DOWN FENCES  
RUNNING NORTH AND  
WEST.

Comp. Declin. 18° E  
Agency DCSO  
Party Chief RANDALL W SMITH  
Notekeeper Randall W Smith  
Witnesses STEPHEN J FLAUSK

Address

Surveyor's Seal

REGISTERED  
PROFESSIONAL  
LAND SURVEYOR

Randall W Smith  
EXPIRES 12-31-94

OREGON  
JULY 25, 1990  
RANDALL W. SMITH  
2469