

Monument Set (Procedure and Description)

Monument Detail

NONE

N/A

★ (COMMENTS) ★


NOTE MAGNETIC INTERFERENCE AT CORNER IS APPROX. -6° LEFT BEARINGS ARE TAKEN AWAY FROM CORNER

New Accessories

SE CORNER OF BUILDING AT 200 W. MILITARY AVE BEARS $N 49^{\circ} W$, 51.5 FT

FIRE HYDRANT BEARS $N 25 \frac{3}{4}^{\circ} W$, 35.8 FT

Sketch of Monument, Accessories, and General Area

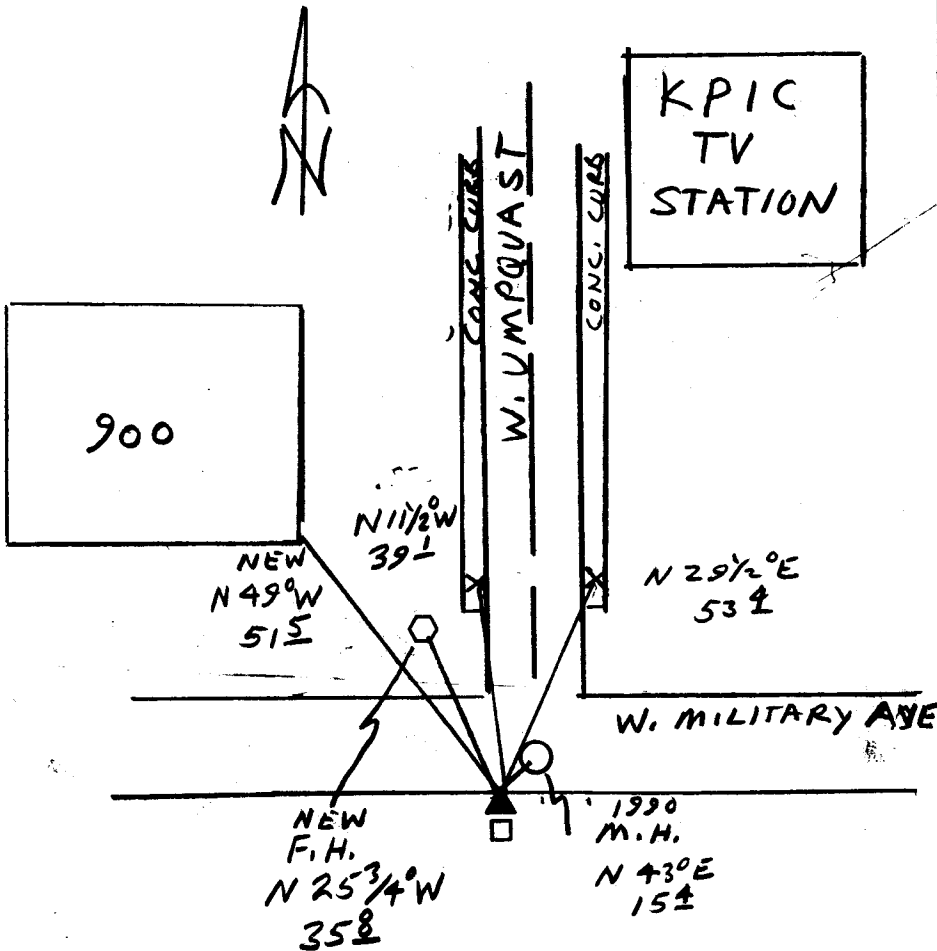

Location & Comments

CORNER LIES AT THE INTERSECTION OF W. MILITARY AVE AND W. UMPQUAST IN SOUTH DITCH OF MILITARY AVE. METAL W. POST AND SIGN BEAR SOUTH 1 FT.

Comp. Declin. $18^{\circ} E$
 Agency DCSO
 Party Chief RANDALL W. SMITH
 Notekeeper R. W. Smith
 Witnesses STEPHEN J. FLAUS

Address

REGISTERED ^{Surveyor's Seal}
 PROFESSIONAL
 LAND SURVEYOR

Randall W. Smith
 EXPIRES 12-31-94

OREGON
 JULY 25, 1990
 RANDALL W. SMITH
 2489