

FILED JP

GOVERNMENT CORNER RESTORATION FORM

Township 28S Range 07 Sec. 28 County DOUGLAS OCT 17 1993

State OK Date 10-12-93 No. _____

COUNTY SURVEYOR
DOUGLAS COUNTY, ORE.

Corner Designation

529 | 528
532 | 533

Condition Report Only
Not Found
 Renewed
Unrecorded
Surveyed In
Referenced Out

Previous Renewals 1926 BOWKER, 1955 + 1968 DCSO

Monument(s) Found: (Condition and Source)
2 1/2" DIA DCSO BRASS CAP ON
A 1 1/2" O.D. IRON PIPE PROTRUDING
11" ABOVE GROUND IN AN
EAST - WEST FENCE LINE,
1955 DCSO

FENCE TO SOUTH AS RECORDED
IN 1968 DCSO RENEWAL GONE

COUNTY SURVEYORS OFFICE

T28S R7W

29 | 28
32 | 33
1955

Accessories Found:

- 16" NW 21" DIA. 2 FT HIGH ROTTED D. FIR STUMP, NO BLAZES OR
SCRIBING VISIBLE, BEARS N 54° E, 47.0 FT (1926 BOWKER)
(AGREES WITH REC)
- 12" NW 15" DIA 3 FT HIGH ROTTED D. FIR STUMP, SCRIBING
VISIBLE " 8 29" BEARS N 10° E, 13.3 FT (1926 BOWKER)
(AGREES WITH 1955 DCSO REC)
- 12" NW 27" DIA D. FIR WITH A FULLY HEALED DOUBLE BLAZE,
BEARS N 25° W, 4.6 FT (1955 DCSO) (AGREES WITH REC).
- 16" NW 16" DIA 3 FT HIGH ROTTED D. FIR STUMP, SCRIBING
VISIBLE ON UNHEALED BLAZE " 32 CS" BEARS S 46 1/2° W 53.3 FT
(1955 DCSO) (AGREES WITH REC.)
- 20" NW 24" DIA 6 FT HIGH D. FIR STUMP WITH A HEALED
SINGLE BLAZE AND BARK SCRIBING " S 28" BEARS
N 86° E, 14.1 FT (1955 DCSO) (AGREES WITH REC)
- 4" NW 9" DIA. B. OAK WITH A FULLY HEALED SINGLE
BLAZE, BEARS S 35 1/2° W, 15.5 FT (1968 DCSO) (AGREES
WITH REC)

300200

Monument Set (Procedure and Description)

Monument Detail


NONE

N/A

New Accessories

5" DIA. D.FIR DOUBLE BLAZED AND SCRIBED "X BT" BEARS S59°E, 36.0 FT
7" DIA D.FIR DOUBLE BLAZED AND SCRIBED "TZBS R7W/SZBS CS BT" BEARS N35°E, 18.3 FT.

Sketch of Monument, Accessories, and General Area

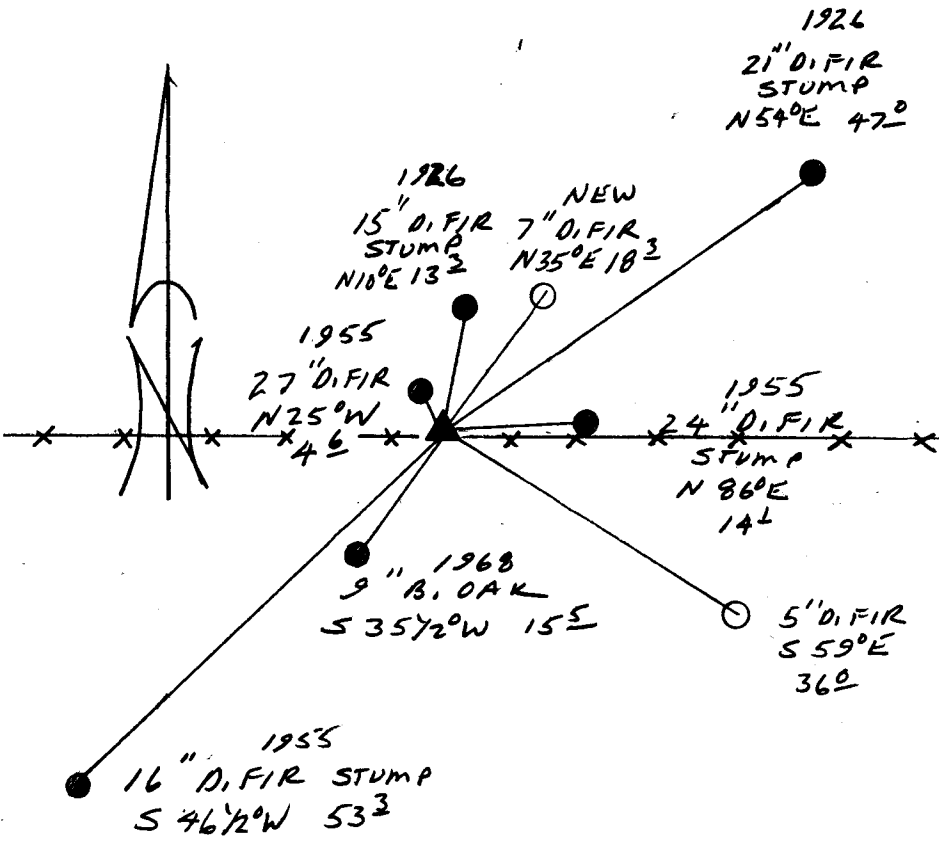

Location & Comments

Comp. Declin. 18°E
Agency DCSO
Party Chief RANDALL W SMITH
Notekeeper [Signature]
Witnesses STEPHEN J FLAUSK
Address

Surveyor's Seal

REGISTERED PROFESSIONAL LAND SURVEYOR
Randall W Smith
EXPIRES 12-31-99
OREGON JULY 25, 1990
RANDALL W. SMITH
2400