

GOVERNMENT CORNER RESTORATION FORM

Township 24S Range 4W Sec. 34 County DOUGLAS

OCT 27 1993

State OR Date 9-20-93 No. \_\_\_\_\_

COUNTY SURVEYOR  
DOUGLAS COUNTY, ORE.

Corner Designation

N 1/16  
S 34 | S 35

- Condition Report Only
- Not Found
- Renewed
- Unrecorded
- Surveyed In
- Referenced Out

ERRONEOUS 1972 BLM

Previous Renewals 1985 BLM

MONUMENT DETAIL

Monument(s) Found: (Condition and Source)

3 1/4" DIA BLM BRASS CAP  
ON A 2 1/2" O.D. IRON PIPE, PROTRUDES  
3" ABOVE GROUND. (1985 BLM)

U.S. DEPT. OF THE INTERIOR

N 1/16

S 34 | S 35  
1985  
1972

BUR. OF LAND MANAGEMENT

Accessories Found:

24" NOW 24" DIA. D.FIR WITH A FULLY HEALED SINGLE BLAZE  
BEARS S 28° E, 42.2 FT (REC. S 26 1/2° E, 42.2 FT) 1985 BLM

8" NOW 8" DIA DEAD 20 FT HIGH D.FIR SNAG, WITH A  
PARTIALLY HEALED SINGLE BLAZE, SCRIBING VISIBLE  
"N Y 16 S 34 BT" BEARS S 83 1/2° W, 84.5 FT (AGREES  
WITH REC) 1985 BLM

Oct 1993

Monument Set (Procedure and Description)

Monument Detail

NONE


N/A

- 36" DIA 4 FT HIGH D. FIR STUMP WITH BOAT SPIKE SET THROUGH BT TAG ON TOP, B.S. BEARS N 14° E, 104.8 FT. (BOAT SPIKE 18 9" LONG AND STAMPED B02 ON TOP)

New Accessories

- 3" DIA. D. FIR DOUBLE BLAZED AND SCRIBED "X BT" BEARS N 43 1/2° W, 42.9 FT
- 23" DIA 5 FT HIGH D. FIR STUMP WITH BOAT SPIKE SET THROUGH BT TAG ON TOP (HAS A CHOPPED OUT BLAZE ON SOUTHWEST TRUNK), B.S. BEARS S 74 1/2° E, 19.6 FT. (BOAT SPIKE AS 8" LONG AND STAMPED B01 ON TOP)

Sketch of Monument, Accessories, and General Area

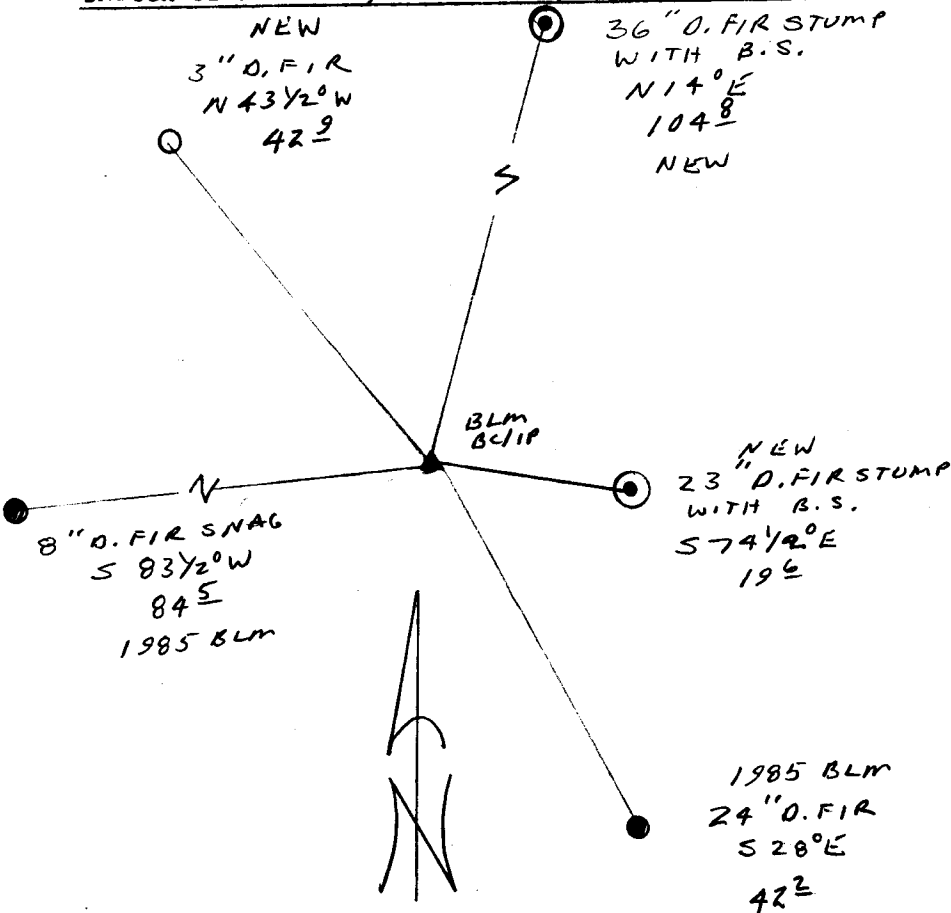

Location & Comments

Comp. Declin. 18° E  
 Agency DSSO  
 Party Chief RANDALL W SMITH  
 Notekeeper RANDALL W SMITH  
 Witnesses STEPHEN J FLOUSE

Address

Surveyor's Seal

REGISTERED  
 PROFESSIONAL  
 LAND SURVEYOR

*Randall W Smith*  
 EXPIRES 12-31-94

OREGON  
 JULY 25, 1990  
 RANDALL W. SMITH  
 2400