



RENEWAL

Monument Set (Procedure and Description)

Monument Detail

1 3/8" O.D X 32" LONG IRON PIPE, WITH  
 A 2 3/8" DIA. DC SO BRASS CAP IS  
 SET AT REFERENCED POSITION  
 OF 3/4" I.D. IRON PIPE, BC/IP  
 PROTRUS 5" ABOVE GROUND.

3/4" I.D. ~~PIPE~~ HAD AN OVERALL LENGTH  
 OF 19" IP PIECES ARE SET ALONG  
 NORTH EDGE OF DC SO BC/IP, PROTRUDING  
 3" ABOVE GROUND.

DOUGLAS COUNTY SURVEYORS  
 T 30 S

1/4 R  
 S 27 | S 26 S  
 W

1993  
 OFFICE

New Accessories


3" DIA CEDAR DOUBLE BLAZED AND SCRIBED " X BT "  
 BEARS S 53° E, 15.4 FT

7" DIA. MADRONE BARK SCRIBED " 1/4 S 27 CS BT " BEARS N 85 1/2° W, 8.4 FT

11" DIA. MADRONE DOUBLE BLAZED AND SCRIBED " 1/4 S 27 CS BT "  
 BEARS S 24° W, 16.5 FT

Sketch of Monument, Accessories, and General Area

Location & Comments

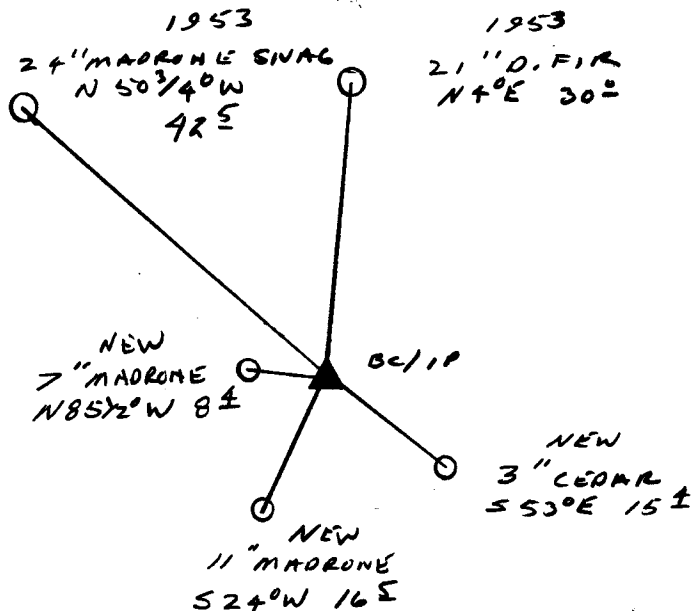

*(This section is mostly blank with a diagonal line drawn through it.)*

Comp. Declin. 18° E  
 Agency DCSO  
 Party Chief RANDALL W SMITH  
 Notekeeper Randall W Smith  
 Witnesses STEPHEN J FLAUSK

Address

Surveyor's Seal

REGISTERED  
 PROFESSIONAL  
 LAND SURVEYOR

*Randall W Smith*  
 EXPIRES 12-31-94

OREGON  
 JULY 25, 1990  
 RANDALL W. SMITH  
 2499