

RENEWAL

Monument Set (Procedure and Description)

WE INVESTIGATED NUMEROUS POSITIONS TO RESET 1966 BC/IP. NONE OF WHICH FIT WELL ON GROUND (BC/IP WOULD FALL INSIDE COR. TREE OR LIE ON TOP OF LARGE UNDISTURBED ROOTS) WE RESET ALSO BC/IP AT MOST PROBABLE 1966 POSITION BETWEEN TWO LARGE ROOTS ON SOUTHERLY SIDE OF CORNER TREE. LOOSE DIRT WAS FOUND BETWEEN ROOTS DOWN TO A DEPTH THAT GROUND MARKS SHOWED ON BC/IP. BC/IP PROTRUDES 18" ABOVE GROUND AND IS SURROUNDED BY A 2 1/2 FT DIA 15" HIGH MOUND OF STONE

Monument Detail


COUNTY SURVEYOR OFFICE

$\frac{1}{4}$
 N 15° E 2.6 FT
 TO COR R
 R 2 W S 24 | S 19 R
 W W
 RESET 1993
 T 315
 1966

BC/IPS AND DISTANCES TAKEN FROM CENTER OF ORIG. COR. TREE
New Accessories

- ALSO BC/IP BEARS S 45° W, 2.6 FT.
- 21" DIA W. FIR (1966 RENTREE) WITH A FULLY HEALED DOUBLE BLAZE BEARS S 49 1/2° E, 13.0 FT
- 6" DIA. W. FIR DOUBLE BLAZED AND SCRIBED "Y 4 S 19 CS BT" BEARS S 14 1/2° E, 20.2 FT
- 8" DIA. D. FIR DOUBLE BLAZED AND SCRIBED "Y 4 S 24 CS BT" BEARS S 79° W, 12.8 FT
- 8" DIA MAPLE DOUBLE BLAZED AND SCRIBED "Y 4 S 19 CS BT" BEARS N 19° E, 19.5 FT

Sketch of Monument, Accessories, and General Area

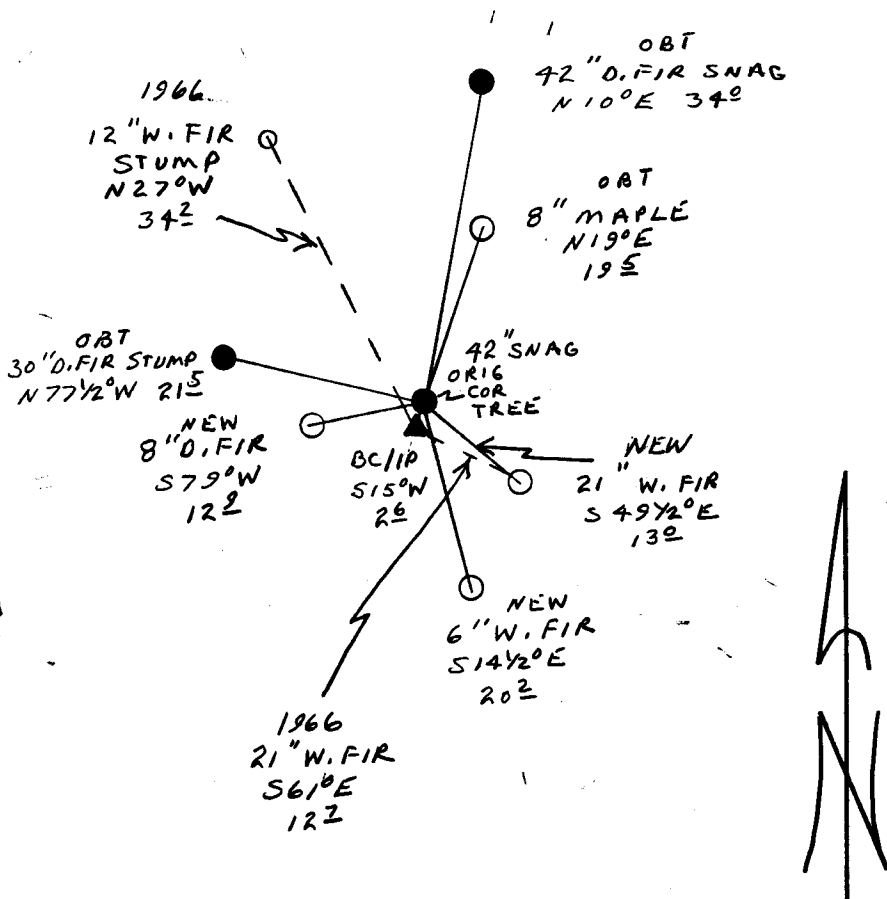

Location & Comments

THE CORNER IS THE ORIG. CORNER TREE. ALL NEW ACCESSORIES ARE IN REFERENCE TO THE CORNER TREE. THE ALSO BC/IP SHOULD BE USED AS A REFERENCE TO THE CORNER TREE.

Comp. Declin. 18° E
 Agency DCSO
 Party Chief RANDALL W SMITH
 Notekeeper Randall W Smith
 Witnesses STEPHEN J FLAUSE

Address

Surveyor's Seal
 REGISTERED
 PROFESSIONAL
 LAND SURVEYOR
Randall W Smith
 EXPIRES 12-31-94
 OREGON
 JULY 25, 1990
 RANDALL W. SMITH
 2469