

RENEWAL

Monument Set (Procedure and Description)

Monument Detail

NONE


N/A

New Accessories

- 5/8" IRON ROD 3" BELOW ROAD SURFACE, BEARS S 63° E, 22.5 FT
- 11" DIA D. FIR AT NORTH WEST CORNER OF PROPERTY AT 602 O.C. BROWN RD. SINGLE SMALL LOW BLAZE "S 19 BT" BEARS N 11 1/2° E, 115.0 FT
- PK NAIL INTO CENTER OF 13" DIA 5 1/2 FT HIGH CORNER POST BEARS S 42 3/4° E, 29.6 FT

Sketch of Monument, Accessories, and General Area

Location & Comments

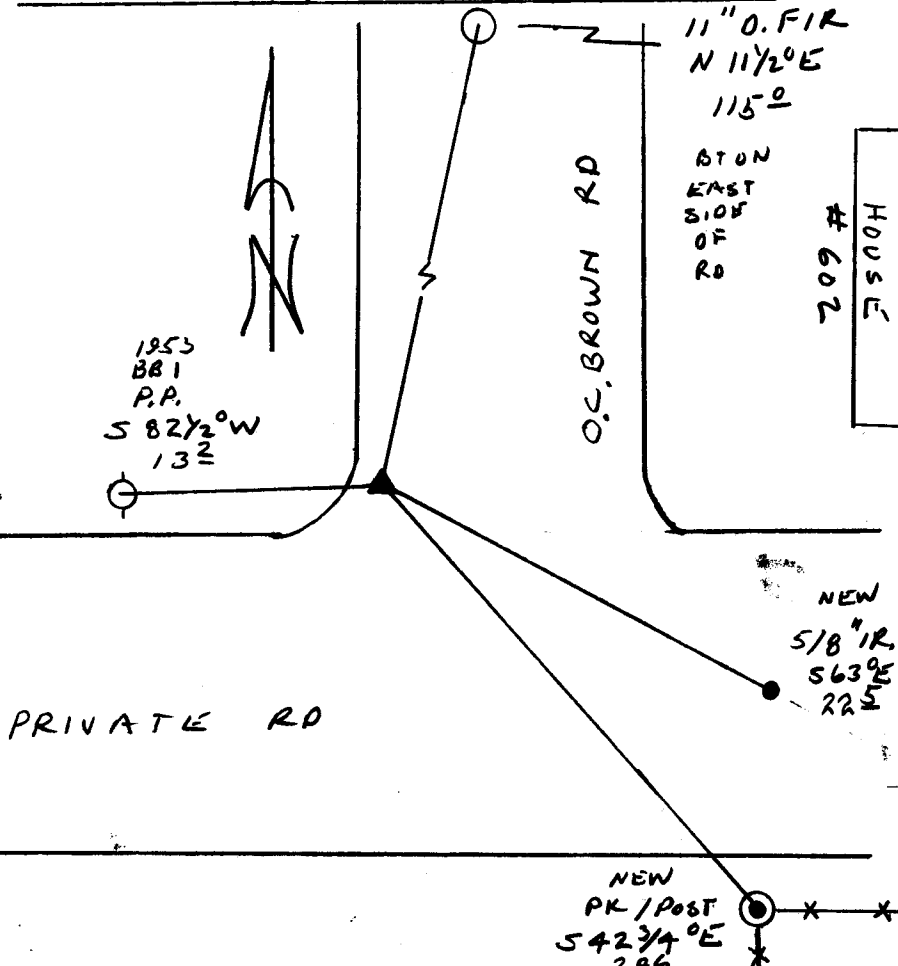

Location & Comments

Comp. Declin. 17 3/4° E

Agency D.C.S.O.

Party Chief RANDALL W SMITH

Notekeeper Randall W Smith

Witnesses STEPHEN J FLAUS

Address

Surveyor's Seal

REGISTERED
PROFESSIONAL
LAND SURVEYOR

Randall W Smith
EXPIRES 12-31-94

OREGON
JULY 25, 1990
RANDALL W. SMITH
2489