



Monument Set (Procedure and Description)

Monument Detail

NONE


N/A

New Accessories

10" DIA. W. OAK DOUBLE BLAZED AND SCRIBED "Y4S23CS BT"  
BEARS N87 1/2° E, 101.6 FT

6" DIA. W. OAK DOUBLE BLAZED AND SCRIBED "Y4S26CS BT"  
BEARS S83 1/2° W, 118.9 FT.

Sketch of Monument, Accessories, and General Area

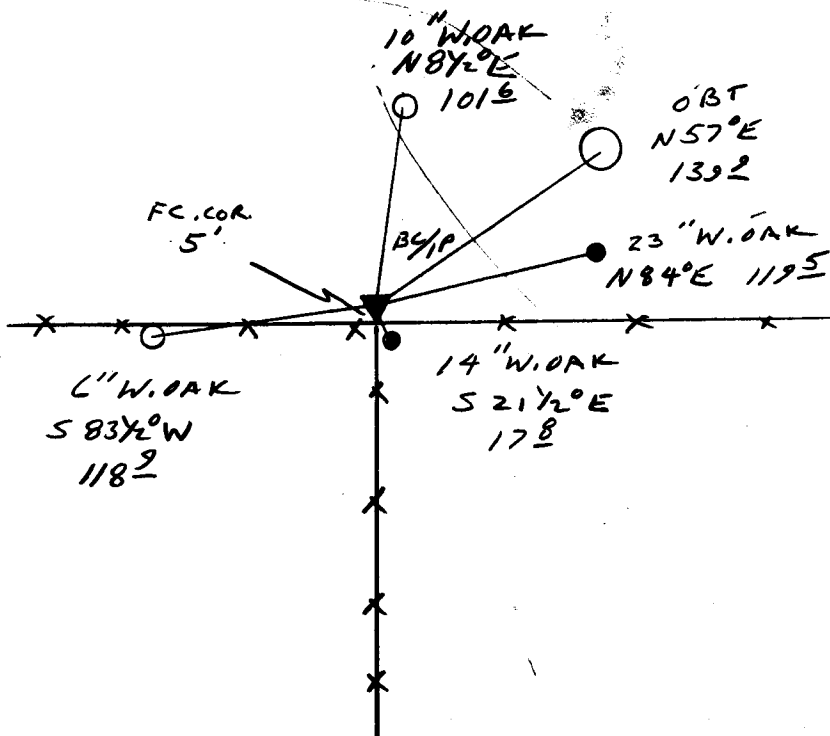

Location & Comments

CORNER LIES NEAR THE INTERSECTION OF A EAST-WEST AND SOUTHER FENCE LINES. AREA APPEARS TO HAVE MAGNETIC PROBLEM BRG'S TAKE WITH STAFF COMPASS.

Comp. Declin. 17 3/4° E  
Agency DCSO  
Party Chief RANDALL W. SMITH  
Notekeeper Randall W. Smith  
Witnesses STEPHEN J. FLAUS

Address

Surveyor's Seal

REGISTERED PROFESSIONAL LAND SURVEYOR

Randall W. Smith

EXPIRES 12-31-94

OREGON JULY 25, 1990

RANDALL W. SMITH

2469