

RENEWAL

Monument Set (Procedure and Description)

NONE


Monument Detail

N/A

New Accessories

N/A

Sketch of Monument, Accessories, and General Area

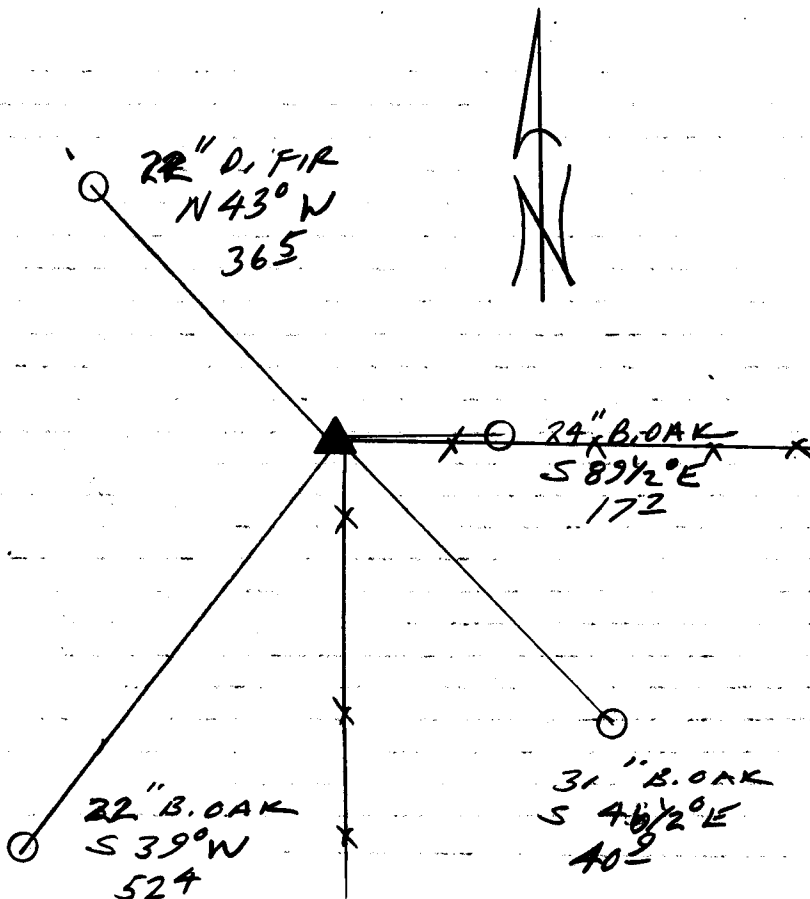

Location & Comments

CORNER LIES AT THE INTERSECTION OF A SOUTHERLY AND EASTERLY RUNNING FENCE LINES

Comp. Declin. 17 3/4° E
 Agency DCSO
 Party Chief RANDALL W. SMITH
 Notekeeper Randall W. Smith
 Witnesses STEPHEN J. FRAUSE

Address

REGISTERED **Surveyor's Seal**
 PROFESSIONAL
 LAND SURVEYOR

Randall W. Smith
EXPIRES 12-31-94

OREGON
 JULY 25, 1990
RANDALL W. SMITH
 2469