

GOVERNMENT CORNER RESTORATION FORM

Date: 3-15-94 By: JC

Township 305 Range 5W Sec. 34 County DOUGLAS This survey consists of:

State OR Date 11-3-93 No. \_\_\_\_\_

Map: \_\_\_\_\_  
Narrative: \_\_\_\_\_  
Corner Rpt: C.S. 64/50

Corner Designation

SW  
COR  
DLC59

DOUGLAS COUNTY  
Condition Report Only  
SURVEYOR  
 Not Found  
 Renewed  
 Unrecorded  
 Surveyed In  
 Referenced Out

Previous Renewals 1937 BOYER

MONUMENT DETAIL

Monument(s) Found: (Condition and Source)

1" ID IRON PIPE PROTRUDING  
2" ABOVE GROUND, I.P. LEANS  
N35°E 0.35 FT FROM A PLUMB  
POSITION. (SOURCE UNKNOWN)

N/A

Accessories Found:

FRAGMENTAL REMAINS OF AN OAK FOUND NEAR RECORD  
POSITION OF O.B.T. (N10°E, 46.2 FT) OBT

18" NOW 22" DIA 172 FT HIGH ROTTED D.FIR STUMP, NO  
BLAZES OR SCRIBING FOUND, BEARS N32°W, 76.7 FT  
(AGREES WITH REC.) 1937 BOYER

RENEWAL

Monument Set (Procedure and Description)

Monument Detail

A 2 3/8" DIA. DCSD BRASS CAP ON A 1 3/8" BY 32" LONG IRON PIPE IS SET AT REFERENCED PLUMB POSITION OF FOUND 1" I.P. PROTRUDING 5" ABOVE GROUND.

1" I.P. MEASURED 23" LONG WHEN REMOVED FROM GROUND, IT'S RESET ALONG NORTH EDGE OF DCSD RELI.P. PROTRUDING 4" ABOVE GROUND.

DOUGLAS COUNTY SURVEYORS

T 30 S  
R 5 W

SW 1/4 59

1993  
OFFICE

New Accessories


5" W. OAK DOUBLE BLAZED AND SCRIBED "SW DLC 59 CS RT" BEARS S 32° E, 18 1/2 FT

9" MADRONE BARK SCRIBED "SW DLC 59 CS RT" BEARS S 89° W, 11.8 FT

5" W. OAK DOUBLE BLAZED AND SCRIBED "SW DLC 59 CS RT" BEARS N 76° E, 37.6 FT

8" MADRONE BARK SCRIBED "SW DLC 59 CS RT" BEARS N 34° W, 30.6 FT

Sketch of Monument, Accessories, and General Area

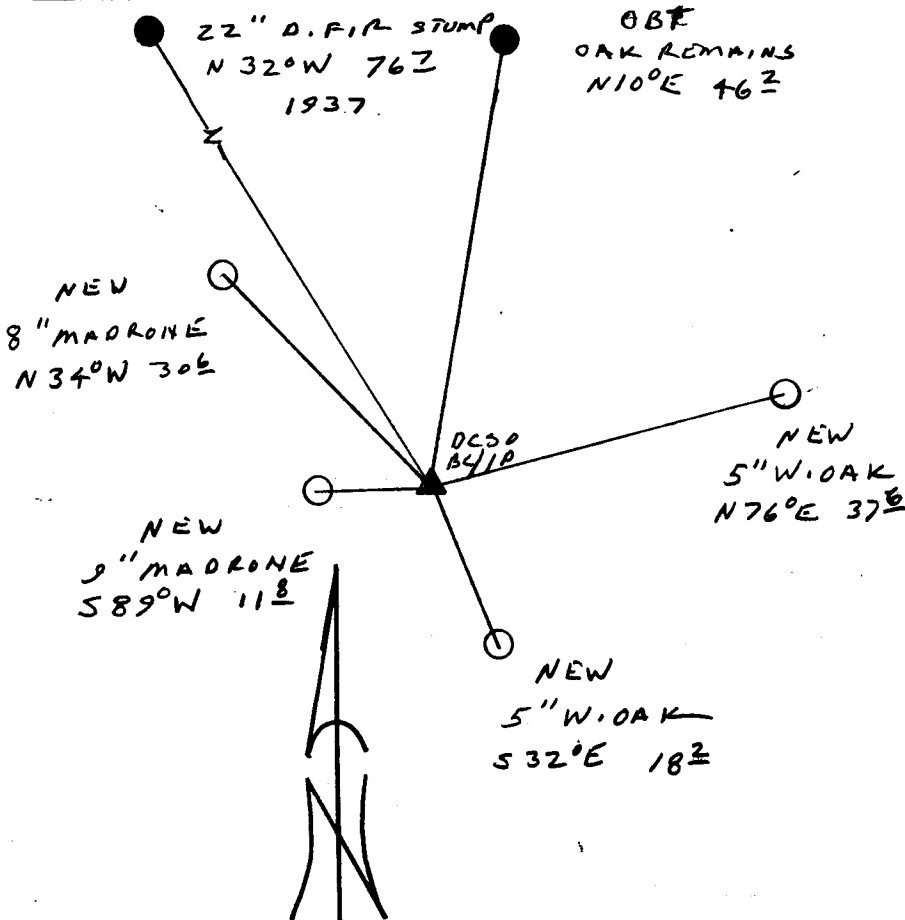

Location & Comments

Comp. Declin. 18° E  
Agency DCSD  
Party Chief RANDALL W. SMITH  
Notekeeper *Randall W. Smith*  
Witnesses STEPHEN J. FLAVSK

Address

Surveyor's Seal

REGISTERED  
PROFESSIONAL  
LAND SURVEYOR

*Randall W. Smith*  
EXPIRES 12-31-94

OREGON  
JULY 25, 1990  
RANDALL W. SMITH  
2488