

GOVERNMENT CORNER RESTORATION FORM

Date: 6-2-94 By: JP  
This survey consists of:

Township 77S Range 5W Sec. 11 County DOUGLAS Map: \_\_\_\_\_  
State OR Date 5-26-94 No. \_\_\_\_\_ Narrative: \_\_\_\_\_  
Corner Rpt: \_\_\_\_\_

Corner Designation

$\frac{1}{4}$   $\frac{S 11}{S 14}$

DOUGLAS COUNTY  
SURVEYOR

- Condition Report Only
- Not Found
- Renewed
- Unrecorded
- Surveyed In
- Referenced Out

MONUMENT DETAIL

Previous Renewals 1967 BAUGHMAN

Monument(s) Found: (Condition and Source)

NONE FOUND

N/A

Accessories Found:

BRG'S TAKEN FROM A POSITION DETERMINED FROM ONE O.B.T.  
11" NOW 28" DIA 15 FT HIGH DEAD OAK SNAG WE  
OPEN AND FIND GOOD SCRIBING, A PARTIAL "BT", BEARS  
N 44 3/4° W, 198.0 FT (HELD AT ORIG. REC.) O.B.T.

16" ELM NOW 23" DIA ASH WITH A PARTIALLY HEALED SINGLE  
BLAZE, GOOD ILLIGIBLE SCRIBE MARKS VISIBLE, BEARS  
S 49 3/4° W, 163.8 FT. (REC. S 49° W 165.9 FT TO A 1967  
PROPORTIONED POSITION) 1967

NO EVIDENCE OF ORIGINAL SW BT FOUND.

NO EVIDENCE OF 1967 NW BT FOUND

540500

RENEWAL

Monument Set (Procedure and Description)

2 3/8" DIA BRASS CAP ON A 1 3/8" O.D.  
 BY 32" LONG IRON PIPE IS SET  
 AT RECORD BEARING AND DISTANCE  
 FROM REMAINING ORIGINAL BEARING  
 TREE. BC/IP PROTRUDES 2" ABOVE  
 GROUND.

Monument Detail

DOUGLAS COUNTY SURVEYORS  
 T 27 S


R  
 1/4 S 11 5  
 S 14 W

1994  
 OFFICE

New Accessories

16" DIA W. OAK DOUBLE BLAZED AND SCRIBED "1/4 S 14 CS BT"  
 BEARS S 14 1/4° W, 247.1 FT.  
 25" DIA MAPLE DOUBLE BLAZED AND SCRIBED "1/4 S 11 CS BT"  
 BEARS N 34 1/2° W, 184.0 FT.  
 25" DIA. B. OAK DOUBLE BLAZED AND SCRIBED "1/4 S 11 CS BT"  
 BEARS N 64 1/2° E, 253.6 FT

Sketch of Monument, Accessories, and General Area

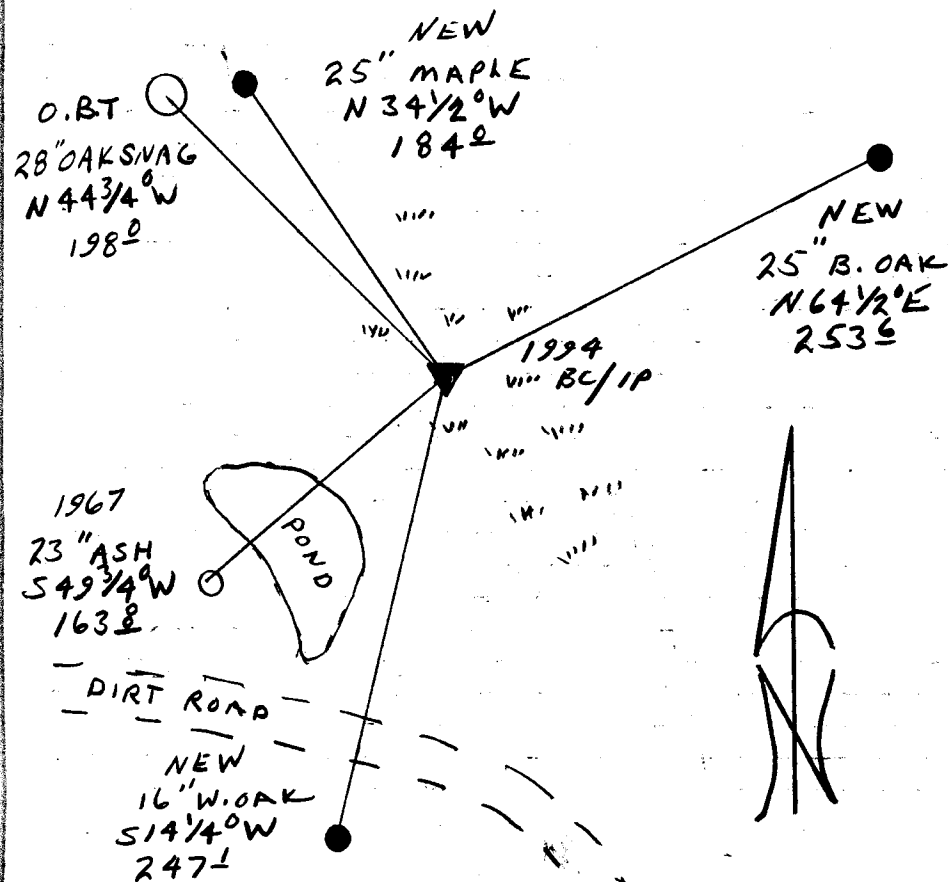

Location & Comments

CORNER LIES APPROX 30'  
 NORTHEAST OF POND  
 DIKE TOP, IN WET MARSHY  
 AREA

Comp. Declin. 17 3/4° E  
 Agency DCSG  
 Party Chief RANDALL W. SMITH  
 Notekeeper Randall W. Smith  
 Witnesses STEPHEN J. FLAUSE

Address

Surveyor's Seal

REGISTERED  
 PROFESSIONAL  
 LAND SURVEYOR  
 Randall W. Smith  
 EXPIRES 12-31-94  
 OREGON  
 JULY 25, 1990  
 RANDALL W. SMITH  
 2469