

RENEWAL

Monument Set (Procedure and Description)

Monument Detail

BC/1P REFERENCED AND REMOVED,
 BC/1P RETURNED TO REFERENCED
 POSITION, NOW PROTRUDES 4" ABOVE
 GROUND. (MEASURED 36" LONG)

N/A


New Accessories

- 11" DIA. MADRONE (DIA. TAKEN 2 FT ABOVE GROUND) BARK SCRIBED
 " T 275 R 5W S 2 CS BT" BEARS N 21° W, 29.5 FT.
- 10" DIA. MADRONE DOUBLE BLAZED AND SCRIBED " T 275 R 5W S 11
 CS BT" BEARS S 45 1/2° W, 48.2 FT.
- 19" DIA. D. FIR DOUBLE BLAZED AND SCRIBED " T 275 R 5W S 12 CS BT"
 BEARS S 84° E, 65.8 FT

Sketch of Monument, Accessories, and General Area

Location & Comments

CORNER LIES ON A STEEP NORTH EASTERLY SLOPE.

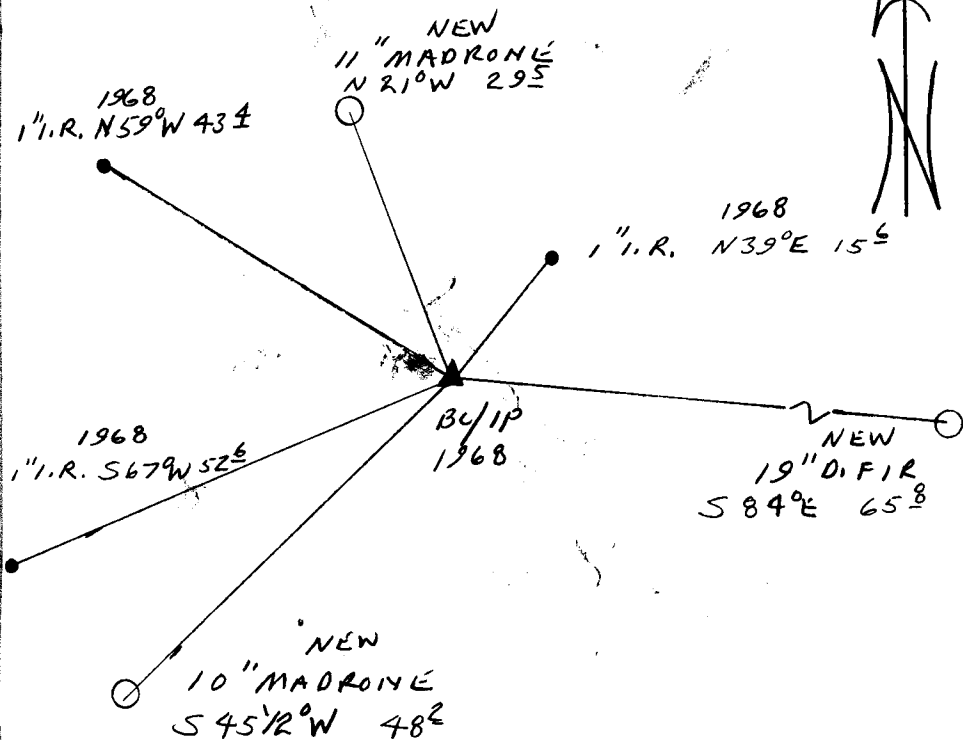

Comp. Declin. 17 3/4° E
 Agency DCSO
 Party Chief RANDALL W SMITH
 Notekeeper Randall W Smith
 Witnesses STEPHEN J FLAUSE

Address

Surveyor's Seal

REGISTERED
 PROFESSIONAL
 LAND SURVEYOR

Randall W Smith
 EXPIRES 12-31-94

OREGON
 JULY 25, 1960
 RANDALL W SMITH
 2489