

GOVERNMENT CORNER RESTORATION FORM

Date: 6/14/94 By: JP
This survey consists of

Township 27S Range 5W Sec. 12 County DOUGLAS State OR
Date 5-3-94 No. CS. 64/51

Corner Designation

$\frac{1}{4}$ S 12
S 13

DOUGLAS COUNTY

- SURVEYOR
- Condition Report Only
- Not Found
- Renewed
- Unrecorded
- Surveyed In
- Referenced Out

Previous Renewals 1971 BAUGHMAN

Monument(s) Found: (Condition and Source)

2 1/2" DIA BRASS CAP ON A
1 1/2" O.D. IRON PIPE, PROTRUDES
10" ABOVE GROUND (1971 BAUGHMAN)

1970

$\frac{1}{4}$ S 12
S 13

OLS 536

Accessories Found:

10" NOW 15" DIA. B. OAK WITH A FULLY HEALED
DOUBLE BLAZE, BEARS N 59° W, 62.1 FT (REC
N 63° W, 63.0 FT DISTANCE IS A SLOPE MEASUREMENT)
(1970)

9" NOW 17" DIA. PINE WITH A FULLY HEALED DOUBLE
BLAZE, BEARS S 78° W, 68.2 FT (AGREES WITH REC)
(1976)

640503

Monument Set (Procedure and Description)

Monument Detail

NONE


N/A

New Accessories

11" DIA. MADRONE BARK SCRIBED "Y4S13CS BT"
BEARS S 29° E , 18.3 FT

17" DIA. B. OAK DOUBLE BLAZED AND SCRIBED "Y4S13CS BT"
BEARS S 4 1/2° E , 51.0 FT

Sketch of Monument, Accessories, and General Area

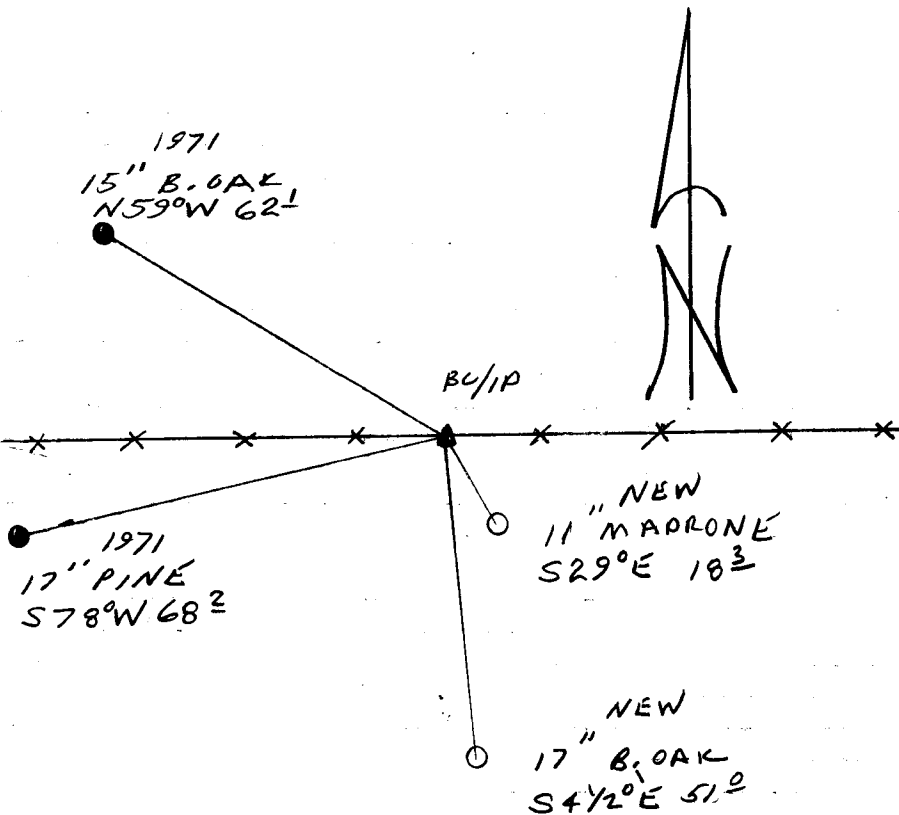

Location & Comments

CORNER LIES IN AN EAST WEST FENCE LINE.

OPENED 3 LARGE OAKS
LOOKING FOR ORIG. MARKS
NONE FOUND

Comp. Declin. 17 3/4° E
Agency DCSO
Party Chief RANDALL W. SMITH
Notekeeper Randall W. Smith
Witnesses STEPHEN J. FLAUSCH

Address

Surveyor's Seal

REGISTERED
PROFESSIONAL
LAND SURVEYOR

Randall W. Smith
EXPIRES 12-31-94

OREGON
JULY 25, 1990
RANDALL W. SMITH
2469