

GOVERNMENT CORNER RESTORATION FORM

Date: 8/31/94 By: BC

Township 22S Range 6W Sec. 15 County DOUGLAS

This survey consists of: Map: \_\_\_\_\_

State OR Date 6-9-94 No. \_\_\_\_\_

Narrative: \_\_\_\_\_  
Correr Rpt: CS 64/52

Corner Designation

CS  
1/16

DOUGLAS COUNTY

- Condition Report Only
- Not Found
- Renewed
- Unrecorded
- Surveyed In
- Referenced Out


Previous Renewals NONE

MONUMENT DETAIL

Monument(s) Found: (Condition and Source)

3/4" DIA BRASS CAP ON A 2 1/2" BY  
30" LONG IRON PIPE IS FOUND  
OUT OF GROUND 6 FT NORTHEAST  
OF CORNER. 1963 BLM

U.S. CADASTRAL SURVEY

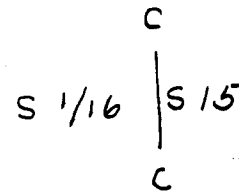

1963

BUREAU OF LAND MANAGEMENT

Accessories Found:

15" NOW 22" DIA. OLIVE WITH A FULLY HEALED SINGLE BLAZE,  
BEARS N 47° W, 41.2 FT (AGREES WITH REC) 1963 BLM

20" NOW 22" DIA. BROWN OLIVE WITH A FULLY HEALED SINGLE BLAZE,  
ROOT HOLE BEARS N 55 3/4° E 20.1 FT (AGREES WITH REC)  
1963 BLM

Monument Set (Procedure and Description)

1963 BLM BC/IP IS RESET AT A POSITION DETERMINED FROM 1963 BT'S. BC/IP NOW PROTRUDES 6" ABOVE GROUND. THE MARKS RESET 1994 ARE ADDED TO BRASS CAP.

U.S. CADASTRAL SURVEY

C  
S 1/16 | S15

C  
RESET 1994  
1963

BUREAU OF LAND MANAGEMENT


New Accessories

6" DIA. D. FIR DOUBLE BLAZED AND SCRIBED "CS 1/16 S15 CS BT" BEARS S52 1/2° W 7.9 FT.

6" DIA. D. FIR DOUBLE BLAZED AND SCRIBED "CS 1/16 S15 CS BT" BEARS S27° E 13.1 FT

3' DIA. D. FIR DOUBLE BLAZED AND SCRIBED " X BT" BEARS S76 1/2° E 9.2 FT

Sketch of Monument, Accessories, and General Area

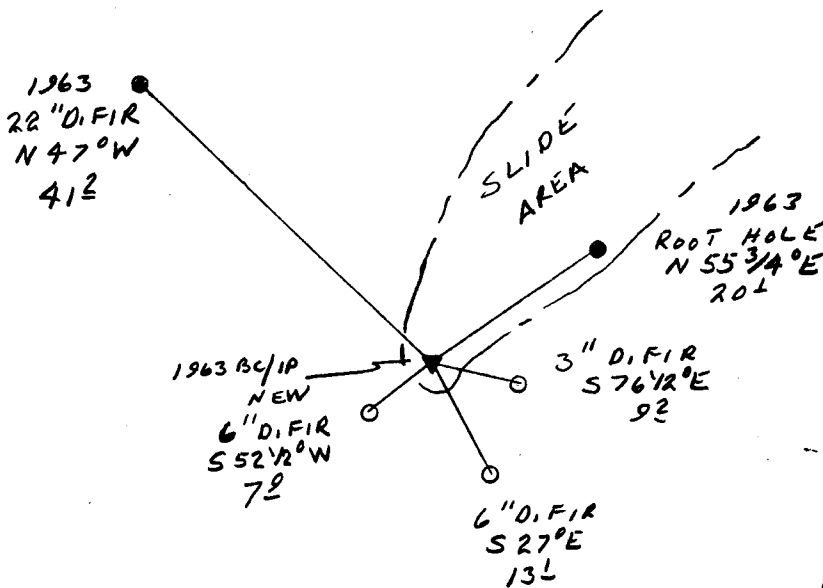

Location & Comments

Comp. Declin. 17 3/4° E  
Agency DCSO  
Party Chief RANDALL W. SMITH  
Notekeeper Randall W. Smith  
Witnesses STEPHEN J. FLAUSE

Address

Surveyor's Seal  
REGISTERED  
PROFESSIONAL  
LAND SURVEYOR  
Randall W. Smith  
EXPIRES 12-31-94  
OREGON  
JULY 25, 1990  
RANDALL W. SMITH  
2489