



RENEWAL

Monument Set (Procedure and Description)

Monument Detail

NONE


EXISTING MONUMENT IS GOOD AND STABLE ON A FAIRLY STEEP WESTERLY SLOPE, DID NOT WANT TO DISTURB GROUND TO SET A B.C./I.P.

N/A

New Accessories

- 9" DIA. D. FIR DOUBLE BLAZED AND SCRIBED "1/4 S 2 CS BT" BEARS S 37° W, 17.2 FT
- 6" DIA. D. FIR DOUBLE BLAZED AND SCRIBED "1/4 S 35 CS BT" BEARS N 11° E, 23.2 FT
- 10" DIA. I CEDAR DOUBLE BLAZED AND SCRIBED "1/4 S 25 CS BT" BEARS N 56° W, 10.6 FT

Sketch of Monument, Accessories, and General Area

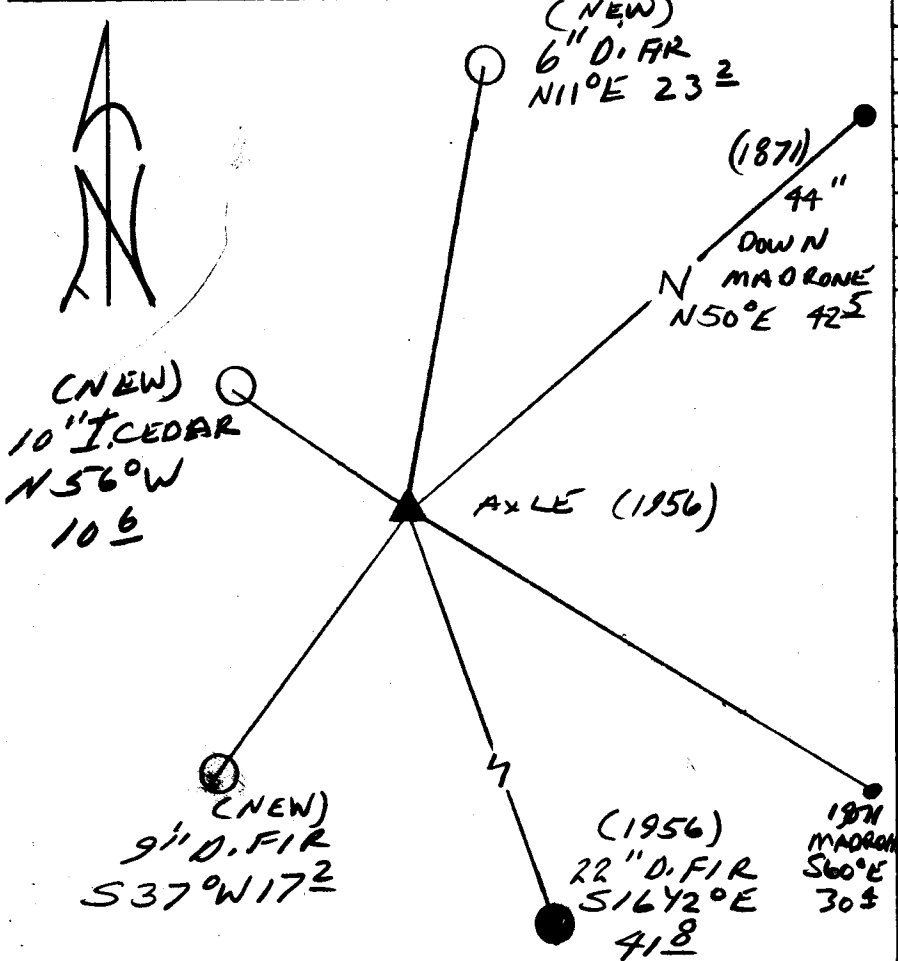

Location & Comments

REMAINS OF A DOWN FENCE LINE VISIBLE SOUTH OF CORNER

Comp. Declin. 17 3/4° E  
 Agency D.S.S.O  
 Party Chief RANDALL W. SMITH  
 Notekeeper [Signature]  
 Witnesses STEPHEN J. FRAUSE

Address

Surveyor's Seal

REGISTERED PROFESSIONAL LAND SURVEYOR

Randall W. Smith  
EXPIRES 12-31-94

OREGON  
JULY 25, 1890  
RANDALL W. SMITH  
2469