

GOVERNMENT CORNER RESTORATION FORM

Date: 12-29-94 By: [Signature]  
This survey consists of:

Township 31S Range 6W Sec. 16 County DOUGLAS

State OR Date 8-4-94 No. \_\_\_\_\_

Narrative: \_\_\_\_\_  
Corner Rpt: 64/92

Corner Designation

S17/S16  
S20/S21

DOUGLAS COUNTY

- Condition Report Only
- Not Found
- Renewed
- Unrecorded
- Surveyed In
- Referenced Out

Previous Renewals #67 300400

Monument(s) Found: (Condition and Source)

2 1/2" BRASS CAP ON A 1 1/2"  
O.D. IRON PROTRUSION 9"  
ABOVE GROUND LEANING 16" SOUTH  
OF PLUMB. (REN #67)

COUNTY SURVEYORS OFFICE

T 31S  
S17/S16  
S20/S21  
R 6W  
1964

Accessories Found:

14" NOW 20" DIA MADRONE WITH A PARTIALLY HEALED  
SINGLE BLAZE SCRIBE MARKS VISIBLE "366"  
BEARS N 50° E, 27.3 FT (REC N 50° E 30.4  
SLOPE MEASUREMENT) O.B.T

20" NOW 29" DIA. 3 FT HIGH ROTTED MADRONE STUMP  
WITH EVIDENCE OF A BLAZE NO SCRIBING VISIBLE,  
BEARS S 40° W, 72.4 FT (REC S 40° W 68.0 FT) O.B.T

18" NOW 27" DIA. 3 FT HIGH ROTTED MADRONE STUMP  
WITH EVIDENCE OF A BLAZE NO SCRIBING VISIBLE  
BEARS N 57 1/2° W, 65.8 FT (REC N 60° W, 62.3 FT) O.B.T  
ORIG SE BT NOT FD

5" NOW 12" DIA. O. FIR WITH A FULLY HEALED SINGLE  
BLAZE, BEARS S 46° E 36.3 FT (AGREES WITH REC) 1967

5" NOW 12" DIA. O. FIR WITH A FULLY HEALED SINGLE  
BLAZE, BEARS S 10° W, 15.0 FT (AGREES WITH REC.) 1967

RENEWAL

Monument Set (Procedure and Description)

Monument Detail

RETURNED BC/IP TO PLUMB POSITION  
PROTRUDES 8" ABOVE GROUND


N/A

New Accessories

14" DIA. D. FIR DOUBLE BLAZED AND SCRIBED "T31S RGWS17CS BT"  
BEARS N 80° W, 36.4 FT.

Sketch of Monument, Accessories, and General Area

Location & Comments

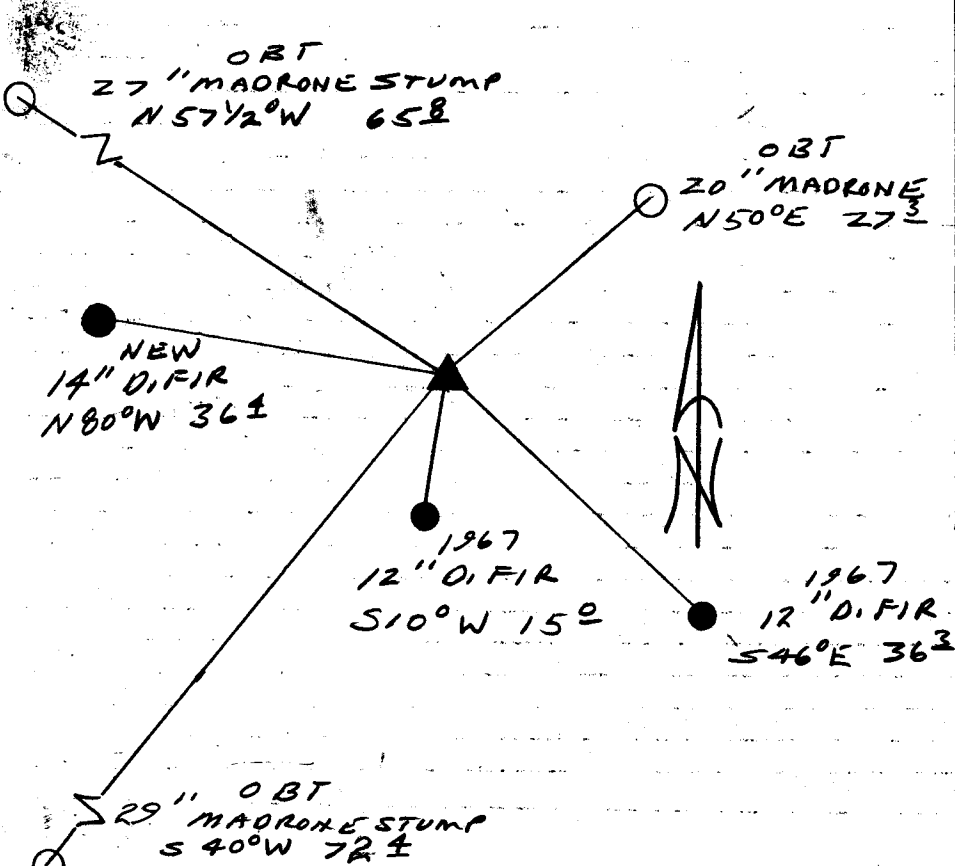

Comp. Declin. 17 3/4° E  
 Agency OCSO  
 Party Chief RANDALL W. SMITH  
 Notekeeper Randall W. Smith  
 Witnesses STEPHEN E. KAUSK

Address

Surveyor's Seal

REGISTERED  
PROFESSIONAL  
LAND SURVEYOR

Randall W. Smith  
EXPIRES 12-31-91

OREGON  
JULY 25, 1990  
RANDALL W. SMITH  
2489