

GOVERNMENT CORNER RESTORATION FORM

Date: 12/9/94 By: JP

Township 26S Range 3W Sec. 17 County DOUGLAS

This survey consists of: _____
Map: _____

State OK Date 9-15-94 No. _____

Narrative: _____
Corner Rpt: CS. 64/52

Corner Designation

DOUGLAS COUNTY
SURVEYOR

$\frac{1}{4} \frac{517}{520}$

- _____ Condition Report Only
- _____ Not Found
- Renewed
- _____ Unrecorded
- _____ Surveyed In
- _____ Referenced Out

PI# 240400

Previous Renewals 1949 BOYER, 1955 BYRON, 1966 TRACY

MONUMENT DETAIL

Monument(s) Found: (Condition and Source)

2 1/2" DIA. BRASS CAP ON A 1 1/2"
O.D. IRON PIPE PROTRUDING 10"
ABOVE GROUND. (1966 TRACY)

2" WIDE STEEL AUTO SPRING
FOUND ALONG SE. EDGE OF
BC/IP PROTRUDING 10" ABOVE
GROUND (1949 BOYER)

COUNTY SURVEYORS OFFICE

T 26S
 $\frac{517}{520}$
 R 3W
 1966

Accessories Found:

20" B. OAK NOW 28" DIA W. OAK WITH A FULLY HEALED BLAZE
BEARS S 6 1/2° E, 10.4 FT (REC S 30° E 9.9 FT DIST A
POSSIBLE FACE MEASUREMENT) O. B.T.

10" NOW 15" DIA. 1 FT HIGH ROTTED D. FIR STUMP,
ILLEGIBLE SCRIBE MARKS VISIBLE BEARS N 68° E
23.5 FT (AGREES WITH REC) 1955 BYRON

1949 D. FIR BEARING N 69° W 44 FT NOW GONE

8" NOW 13" DIA. D. FIR WITH A FULLY HEALED DOUBLE
BLAZE BEARS S 88° W, 5.1 FT (AGREES WITH REC)
1966 TRACY (NOTE THIS RT NOT NOTED IN
PI# 240400, FD IN CS 54/7 CORNER RENEWAL
NOTES)

Monument Set (Procedure and Description)

Monument Detail

NONE


N/A

New Accessories

5/8" IR PROTRUDING 4" ABOVE GROUND AT ANGLE PT IN FENCE LINE LINE, BEARS S23 1/2° E 49.5 FT.

25" DIA ICE OAK DOUBLE BLAZED AND SCRIBED "T265 R3WSRCS BT" S55° W, 51.7 FT.

Sketch of Monument, Accessories, and General Area

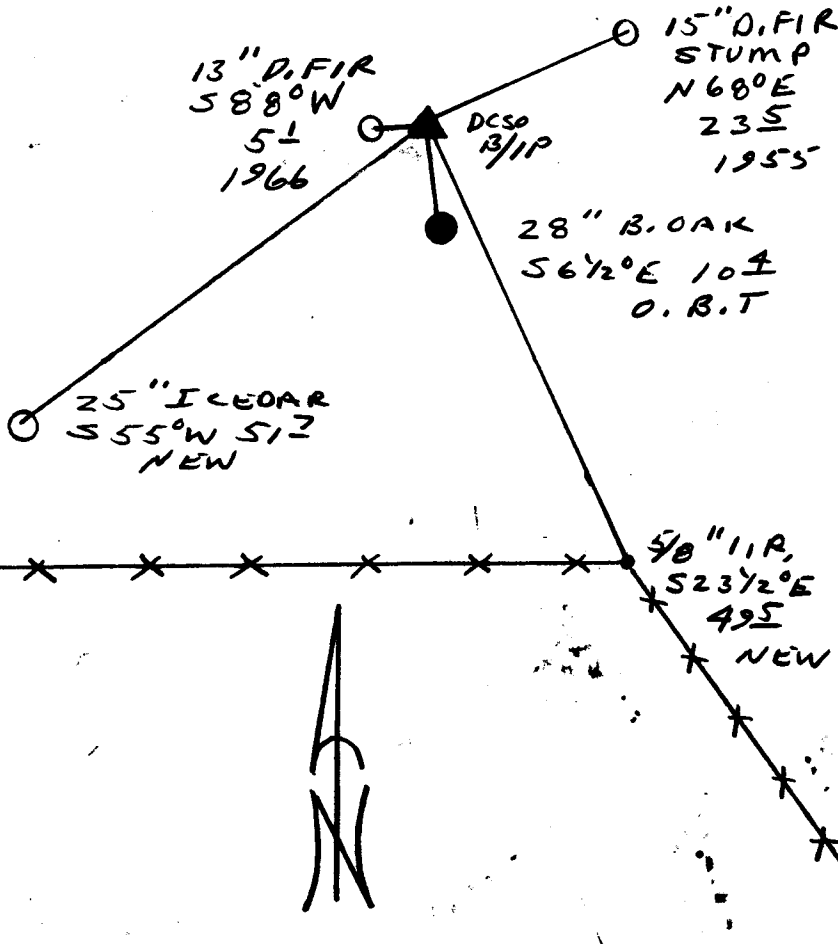

Location & Comments

Comp. Declin. 17 3/4° E
 Agency D.C.S.O.
 Party Chief RANDALL W. SMITH
 Notekeeper Randall W. Smith
 Witnesses STEPHEN J. FLAUSÉ

Address

Surveyor's Seal

REGISTERED
 PROFESSIONAL
 LAND SURVEYOR

Randall W. Smith
 EXPIRES 12-31-94

OREGON
 JULY 25, 1990
 RANDALL W. SMITH
 2499