

GOVERNMENT CORNER RESTORATION FORM

Date: 12-30-95 By: JP

Township 30S Range 9W Sec. 27

County DOUGLAS

This survey consists of:

State OR

Date 12-19-94

No. _____

Narrative: _____

Corner Spt: 64/52

Corner Designation

1/4 S 28 | S 27

DOUGLAS COUNTY

Condition: REPAIR Only

Not Found

Renewed

Unrecorded

Surveyed In

Referenced Out

MONUMENT DETAIL

Previous Renewals # 71

Monument(s) Found: (Condition and Source)

40" NOW 40" DIA. 60' HIGH
D. FIR SNAG WITH A PREVIOUSLY
OPENED BLAZE ON WEST SIDE
SCRIBING VISIBLE "4 S"
ORIG. CORNER TREE

2 1/2" DIA. DCSO BRASS CAP
ON A 1 1/4" OLD IRON PIPE
PROTRUDES 18" ABOVE GROUND
(1965 REN #71)

NOTE: DCSO BC/IP SET IN
ERROR AS ORIG BT NOTED
IN REN #71 WAS THE
CORNER TREE

COUNTY SURVEYORS OFFICE

T 30S R 9W

1/4 28 | 27

1965

Accessories Found:

BRG'S + DIST TAKEN TO CENTER OF CORNER TREE
40" NOW 36" DIA 20' HIGH BURNT D. FIR SNAG
NO SCRIBING VISIBLE, BEARS S 3 1/2° W, 77.9 FT
(REC S 6° W, 77.9 FT) O.B.T.

36" NOW 36" DIA. 15' HIGH D. FIR SNAG
WITH SCRIBING VISIBLE ON A OPENED BLAZE
1/4 S T" BEARS S 42 1/2° E, 14.5 FT
(REC S 54° E, 15.8 FT COULD BE A SLOPE
MEASUREMENT). O.B.T.

1 1/4" O.D. 17" HIGH IRON PIPE WITH DCSO
YELLOW PLASTIC CAP BEARS N 56 1/2° W
16.9 FT (REC S 54° E, 15.8 FT WOULD BE
A DISTANCE AND BRG FROM I.P. TO BLAZE)
(1965 REN 71)

Monument Set (Procedure and Description)

Monument Detail


BRASS CAP ~~FROM~~ ERRONEOUSLY SET IN 1965 IS SAWED OFF AND A YELLOW DCSO PLASTIC CAP IS SET IN IRON PIPE. NOW PROTRUDES 17" ABOVE GROUND.

N/A

New Accessories BRG AND DIST. TAKEN TO CNT OF CORNER TREE

- 11" NOW 18" DIA. D. FIR WITH A FULLY HEALED DOUBLE BLAZE BEARS N 52° W, 25.4 FT. 1965 BT
- 6" NOW 11" DIA. D. FIR WITH A FULLY HEALED DOUBLE BLAZE FACING SOUTHWESTERLY BEARS, N 16° W, 18.4 FT 1965 BT
- 10" DIA. D. FIR DOUBLE BLAZE AND SCRIBED "45 27 CS BT" BEARS N 20° E, 11.7 FT

Sketch of Monument, Accessories, and General Area

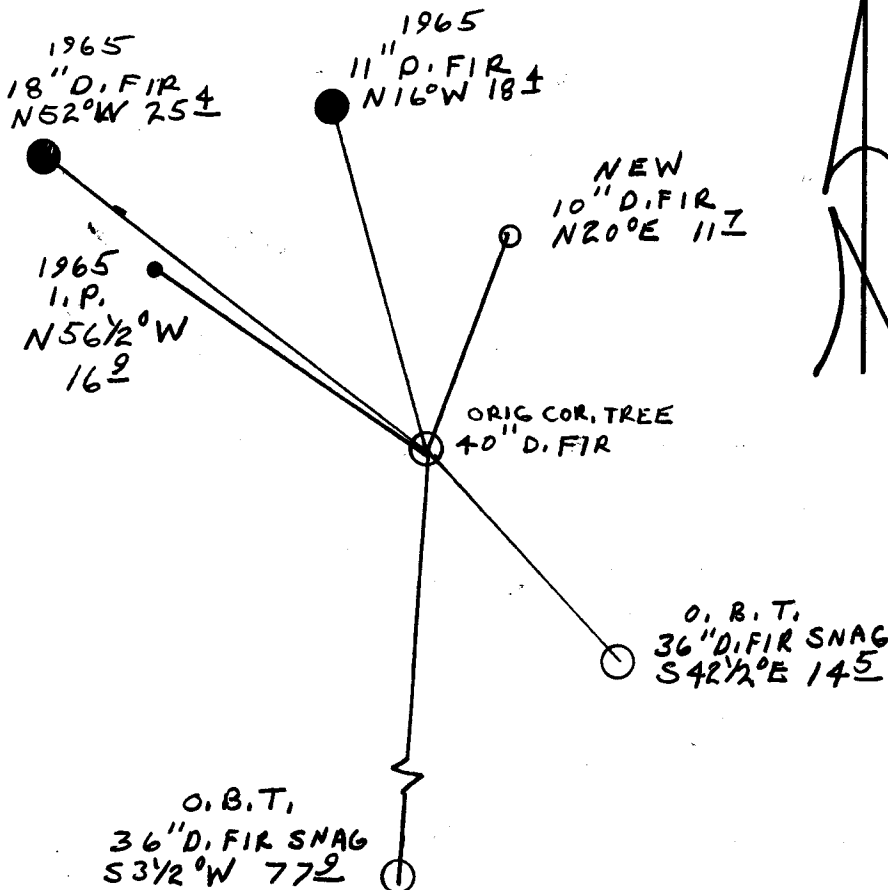

Location & Comments

ORIGINAL CORNER POSITION MAY OF BEEN ALONG WEST EDGE OF CORNER TREE, I WAS UNABLE TO MAKE A CONCLUSIVE DETERMINATION FROM EVIDENCE FOUND. I TIED CORNER ACCESSORIES TO CENTER OF CORNER TREE.

Comp. Declin. 17 3/4° E
 Agency DCSO
 Party Chief RANDALL W SMITH
 Notekeeper *[Signature]*
 Witnesses STEPHEN J FLAVSE

Address

Surveyor's Seal

REGISTERED PROFESSIONAL LAND SURVEYOR

Randall W Smith
EXPIRES 12-31-94

OREGON
JULY 25, 1990
RANDALL W. SMITH
2489