

GOVERNMENT CORNER RESTORATION FORM

Date: 6-7-95 By: PC

This survey consists of:

Township 25S Range 3W Sec. 13 County DOUGLAS

Map: \_\_\_\_\_

State OR Date 3-30-95 No. \_\_\_\_\_

Narrative: \_\_\_\_\_

Corner Rpt: CS 64 | 58-8

Corner Designation

S13 | S18  
S24 |

DOUGLAS COUNTY SURVEYOR

- \_\_\_\_\_ Condition Report Only
- \_\_\_\_\_ Not Found
- Renewed
- \_\_\_\_\_ Unrecorded
- \_\_\_\_\_ Surveyed In
- \_\_\_\_\_ Referenced Out

MONUMENT DETAIL

Previous Renewals 1943 GLO, 1981 DCSO

Monument(s) Found: (Condition and Source)

2 1/2" DIA. GLO BRASS CAP ON A  
2" O.D. IRON PIPE PROTRUDES  
7" ABOVE GROUND (1943 GLO)

U.S. GENERAL LAND OFFICE

T 25S | T 25S  
 S 13 | R 2W  
 S 24 | S 18  
 R 3W

1943 SURVEY

Accessories Found:

24" NOW 34" DIA. 6' HIGH TIPPED OUT D. FIR STUMP WITH  
A FULLY HEALED SINGLE BLAZE, ESTIMATED ROOT WADE  
BEARS S 57 1/2° E, 17.8 FT (AGREES WITH REC) OBT

30" NOW 46" DIA 5' HIGH D. FIR STUMP WITH A FULLY  
HEALED SINGLE BLAZE, BEARS S 17 1/2° W, 17.5 FT  
(REC S 17 1/2° W, 15.8 FT, DIST COULD BE A FACE MEASUREMENT)  
OBT (STUMP IS SOLID IN GOOD SHAPE)

NO OTHER OBT'S OR 1943 REN BT ARE FOUND

13" NOW 14" DIA 6 FT HIGH HEMLOCK STAVE WITH SCRIBING  
VISIBLE ON AN UNHEALED OPEN BLAZE "T 25S R 2W S 18 CS"  
BEARS S 1° E, 36.8 FT (AGREES WITH REC) 1981 DCSO

10" NOW 12" DIA 2 FT HIGH HEMLOCK STAVE WITH SCRIBING  
VISIBLE ON AN UNHEALED OPEN BLAZE "S BT", BEARS N 87° W,  
18.0 FT (AGREES WITH REC) 1981 DCSO

1981 DCSO HEMLOCK BT BEARING N 45° W 62.0 FT  
IS NOW GONE.

RENEWAL

Monument Set (Procedure and Description)

Monument Detail

N/A


N/A

New Accessories

- 5" DIA. HEMLOCK DOUBLE BLAZED AND SCRIBED " X BT" BEARS S01/2°W, 66.7 FT.
- 4" DIA. D. FIR DOUBLE BLAZED AND SCRIBED " X BT" BEARS N36 1/2°W, 24.5 FT.
- 3" DIA. D. FIR DOUBLE BLAZED AND SCRIBED " X BT" BEARS S68°W, 22.1 FT.

Sketch of Monument, Accessories, and General Area

Location & Comments

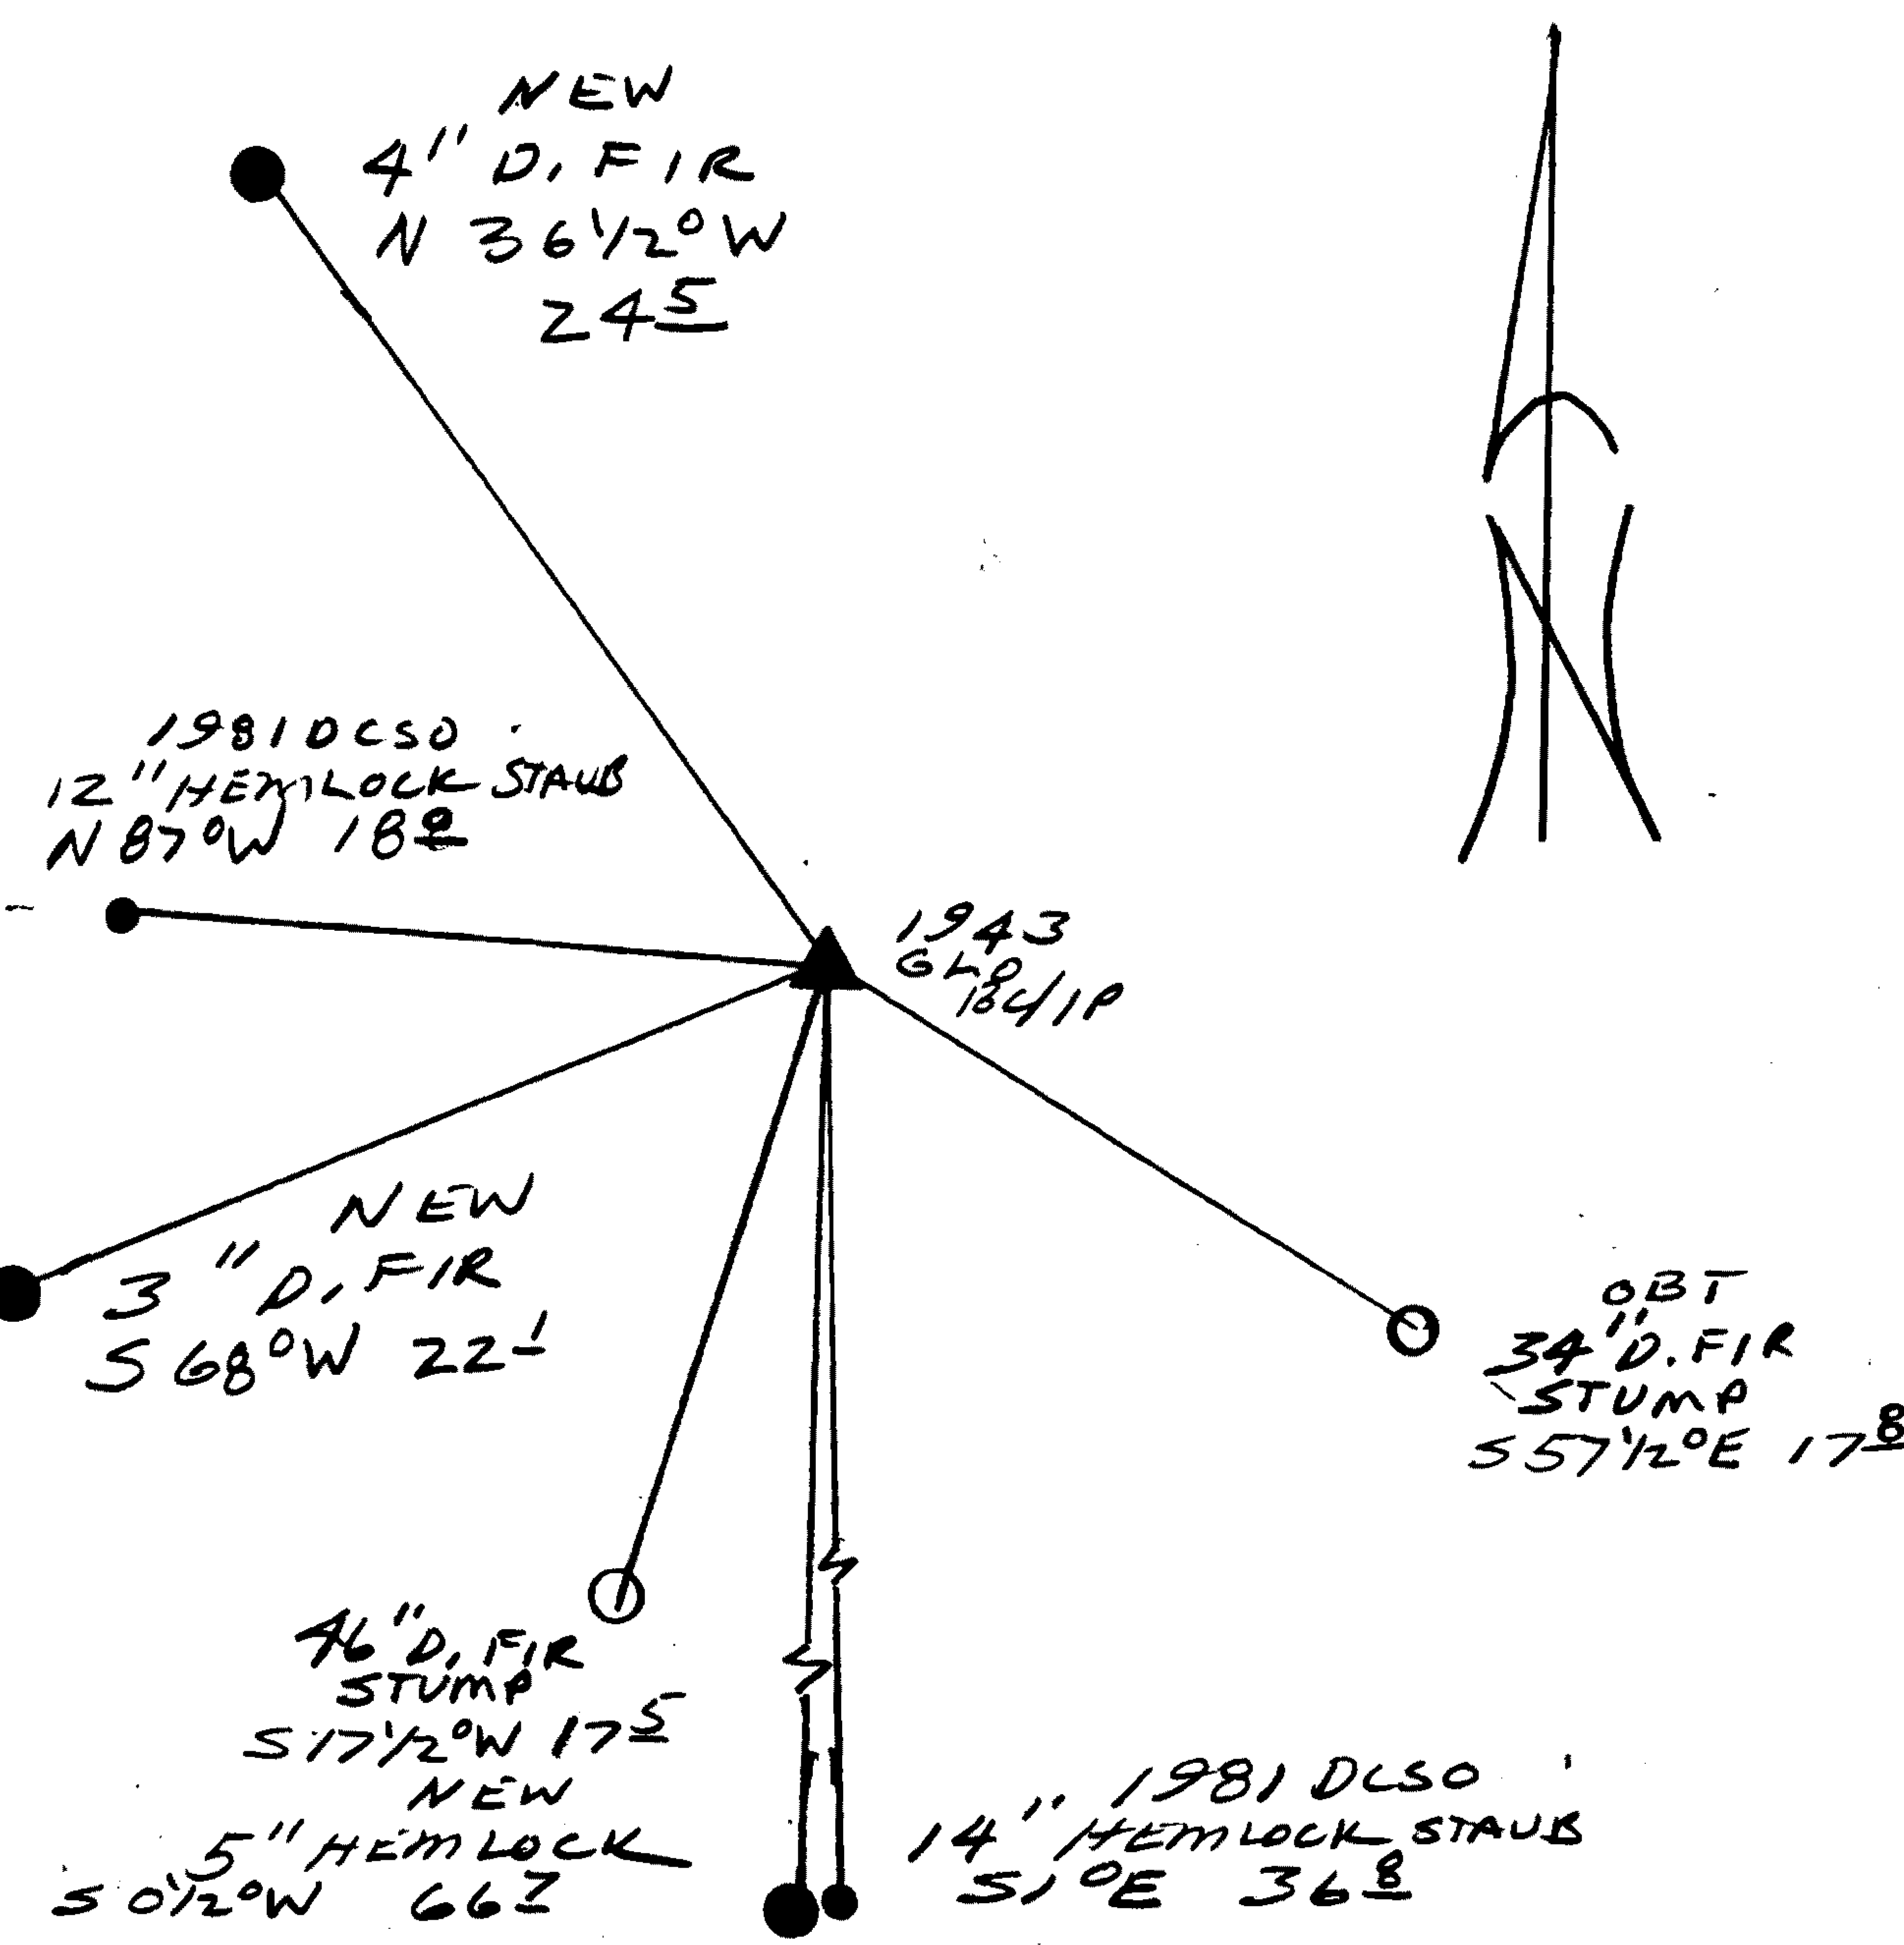

Comp. Declin. 17 3/4° E  
 Agency DLSO  
 Party Chief RANDALL W SMITH  
 Notekeeper Randall W Smith  
 Witnesses STEPHEN J FLAUSE

Address \_\_\_\_\_

Surveyor's Seal

REGISTERED  
PROFESSIONAL  
LAND SURVEYOR

*Randall W Smith*  
EXPIRES 6-31-96

OREGON  
JULY 25, 1990  
RANDALL W. SMITH  
2469