

Monument Set (Procedure and Description)

Monument Detail


N/A

N/A

New Accessories

SET A 5/8" BY 60" LONG IR ALONG NORTH EDGE OF BC/IP PROTRUDS 3 FT ABOVE GROUND. SET TO HELP IN LOCATION OF BC/IP

Sketch of Monument, Accessories, and General Area

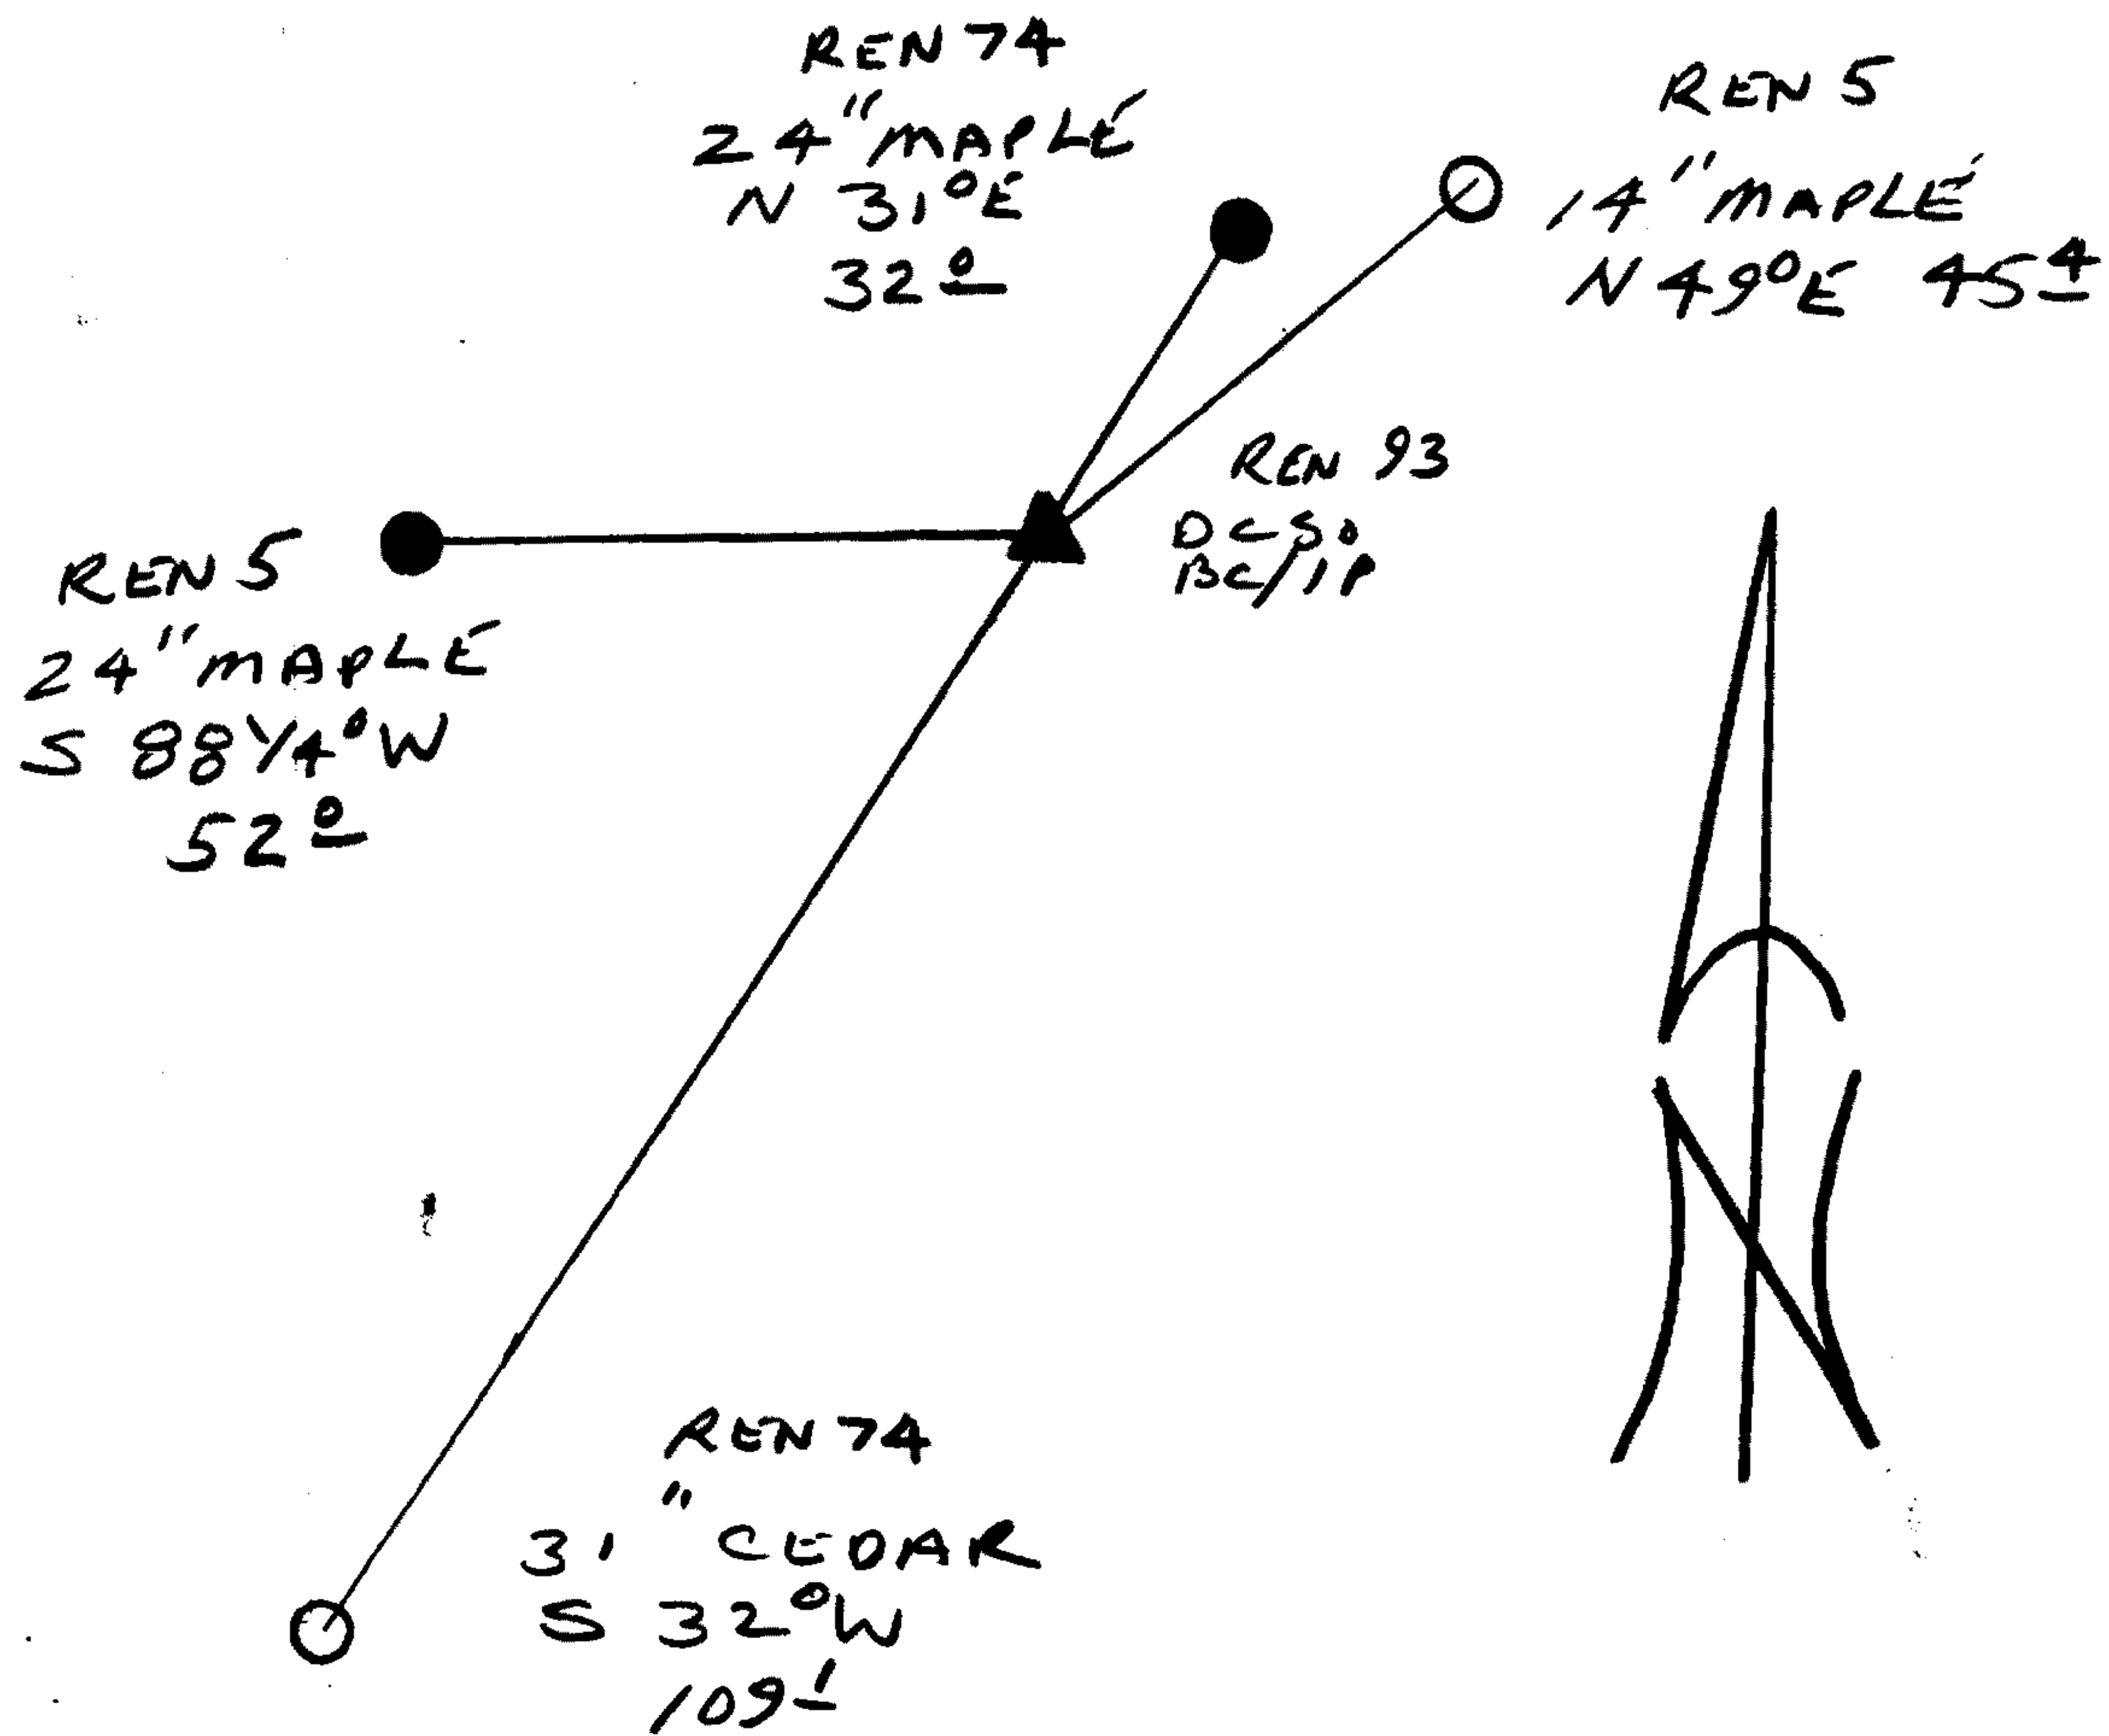

Location & Comments

Comp. Declin. 17 3/4° E
 Agency DCSO
 Party Chief RANDALL W SMITH
 Notekeeper Randall W Smith
 Witnesses STEPHEN J FLAUSE

Address

Surveyor's Seal

REGISTERED
PROFESSIONAL
LAND SURVEYOR

Randall W Smith
DATE 6-30-96

OREGON
JULY 25, 1990
RANDALL W. SMITH
2469