

GOVERNMENT CORNER RESTORATION FORM

Date: 9/20/95 By: AC

Township 25S Range 2W Sec. 18

County DOUGLAS

This survey consists of:

State OR

Date 3-30-95

No. _____

Map: _____

Narrative: _____

Corner Rpt: CS 64/58

Corner Designation

S24 | S18C
| S19C

DOUGLAS COUNTY

- Condition Report Only
- Not Found
- Renewed
- Unrecorded
- Surveyed In
- Referenced Out

Previous Renewals 1943 GLO

Monument(s) Found: (Condition and Source)

2 1/2" DIA GLO BRASS CAP ON A 2" O.D. IRON PIPE PROTRUDING 12" ABOVE GROUND. (1943 GLO)

U.S. GENERAL LAND OFFICE

T25S | T25S
R3W | S18C
S24 | S19C
R2W

1943 SURVEY

Accessories Found:

5" NOW 12" DIA 25 FT HIGH CEDAR SNAG WITH A PARTIALLY HEALED ROTTED SINGLE BLAZE, SCRIBING VISIBLE " T25S R2W S18" AND A FULLY HEALED DOUBLE BLAZE ON SOUTH TRUNK, BEARS N 66 1/2° E, 18.4 FT (AGREES WITH 1943 REC) OBT

60" NOW 64" DIA 2 FT HIGH ROTTED D. FIR STUMP WITH EVIDENCE OF A LOWER BLAZE, NO SCRIBING FOUND. BEARS S 70° E, 35.6 FT (AGREES WITH 1943 REC) OBT

RENEWAL

Monument Set (Procedure and Description)

Monument Detail

N/A


N/A

New Accessories

- 7" DIA. HEMLOCK DOUBLE BLAZED AND SCRIBED "CCT 25S R2W S18 CS BT" BEARS N 15 1/2° E, 12.2 FT
- 11" DIA. HEMLOCK DOUBLE BLAZED AND SCRIBED "CCT 25S R2W S19 CS BT" BEARS S 68° E, 14.0 FT
- 4" DIA. HEMLOCK DOUBLE BLAZED AND SCRIBED "X BT" BEARS N 61° E, 4.0 FT
- 8" DIA. D. FIR DOUBLE BLAZED AND SCRIBED "CCT 25S R2W S19 CS BT" BEARS S 12 1/2° E 18.1 FT

Sketch of Monument, Accessories, and General Area

Location & Comments

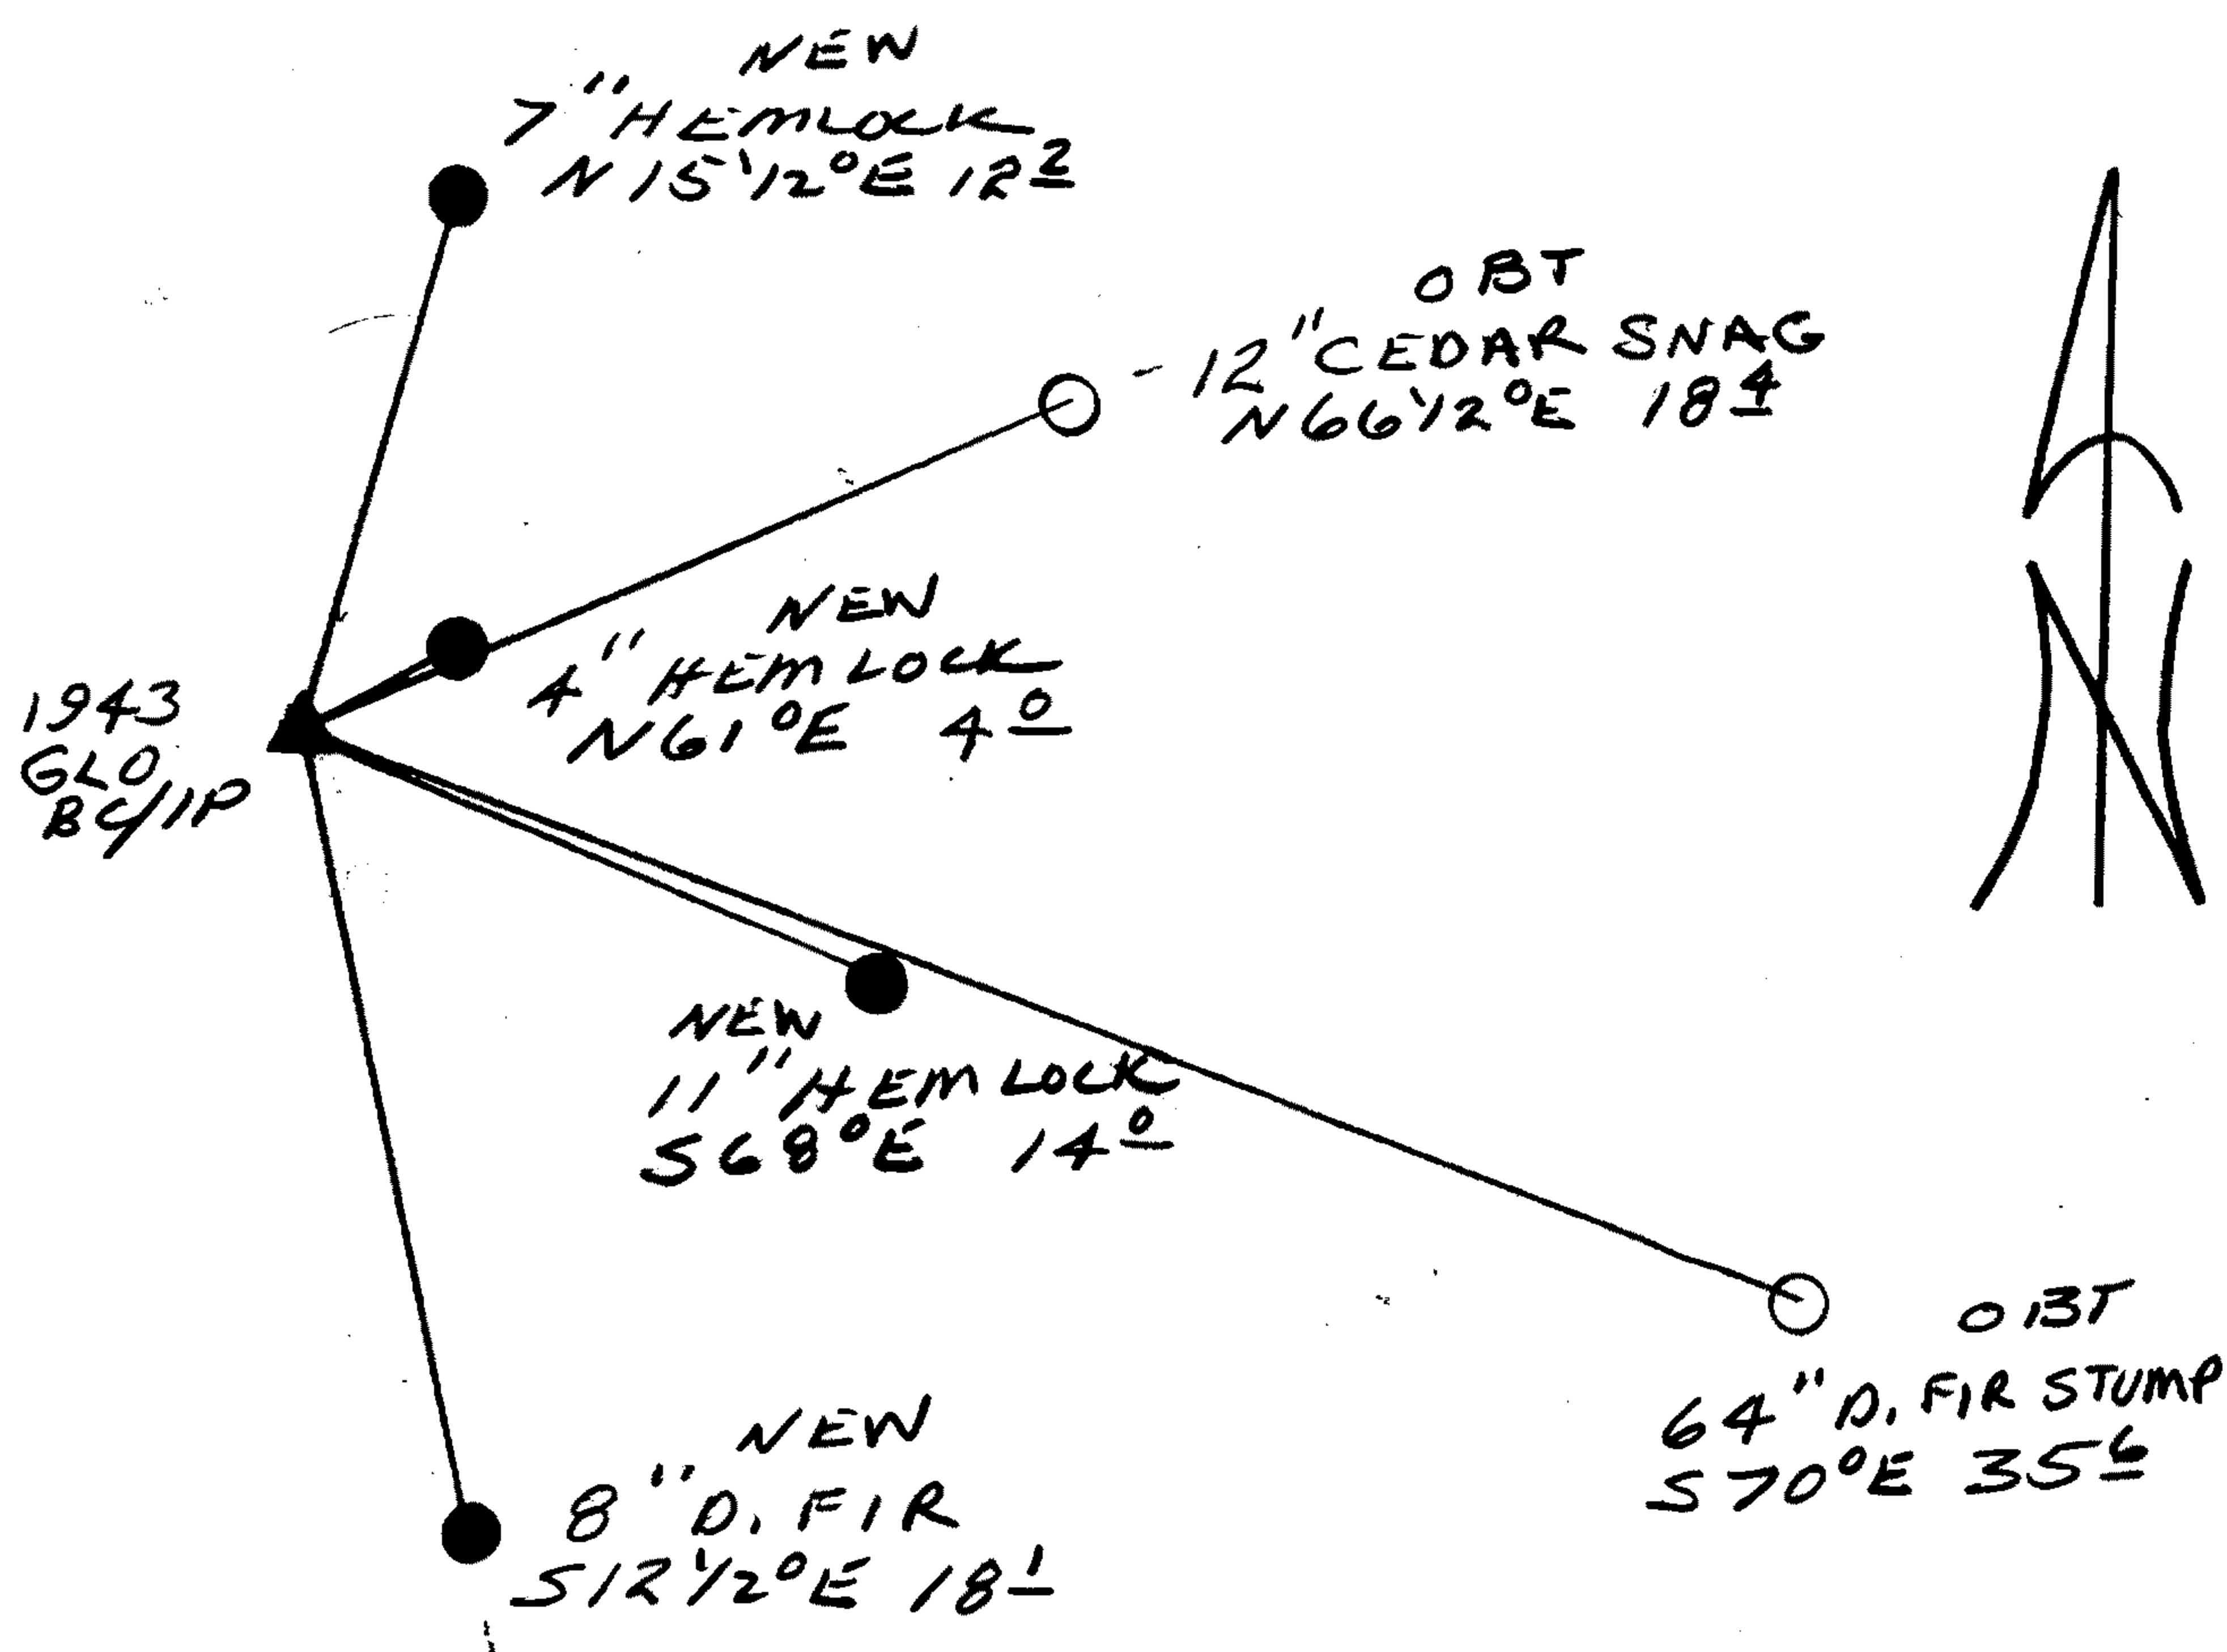

Comp. Declin. 17 3/4° E
 Agency DCSO
 Party Chief RANDALL W SMITH
 Notekeeper Randall W Smith
 Witnesses STEPHEN J FLAUSE

Address

Surveyor's Seal

REGISTERED
PROFESSIONAL
LAND SURVEYOR

Randall W Smith
EXPIRES 6-31-96

OREGON
JULY 25, 1990
RANDALL W. SMITH
2469