

RENEWAL

Monument Detail

Monument Set (Procedure and Description)


BC/IP IS RETURNED TO PLUMB POSITION PROTRUDES 3" ABOVE GROUND. MARKS ON TOP OF BC ARE ORIENTATED EAST.

N/A

New Accessories

9" DIA CHINQUAPIN DOUBLE BLAZED AND SCRIBED "T25SR2WS14CSBT" BEARS N 80° E, 33.1 FT
BOAT SPIKE THROUGH BT TAG, TOP STAMPED "DLSO BOI 1995", IN TOP CENTER 36" DIA 2 FT HIGH PINE STUMP BOAT SPIKE BEARS S 47 1/2° W, 62.4 FT

Sketch of Monument, Acessories, and General Area

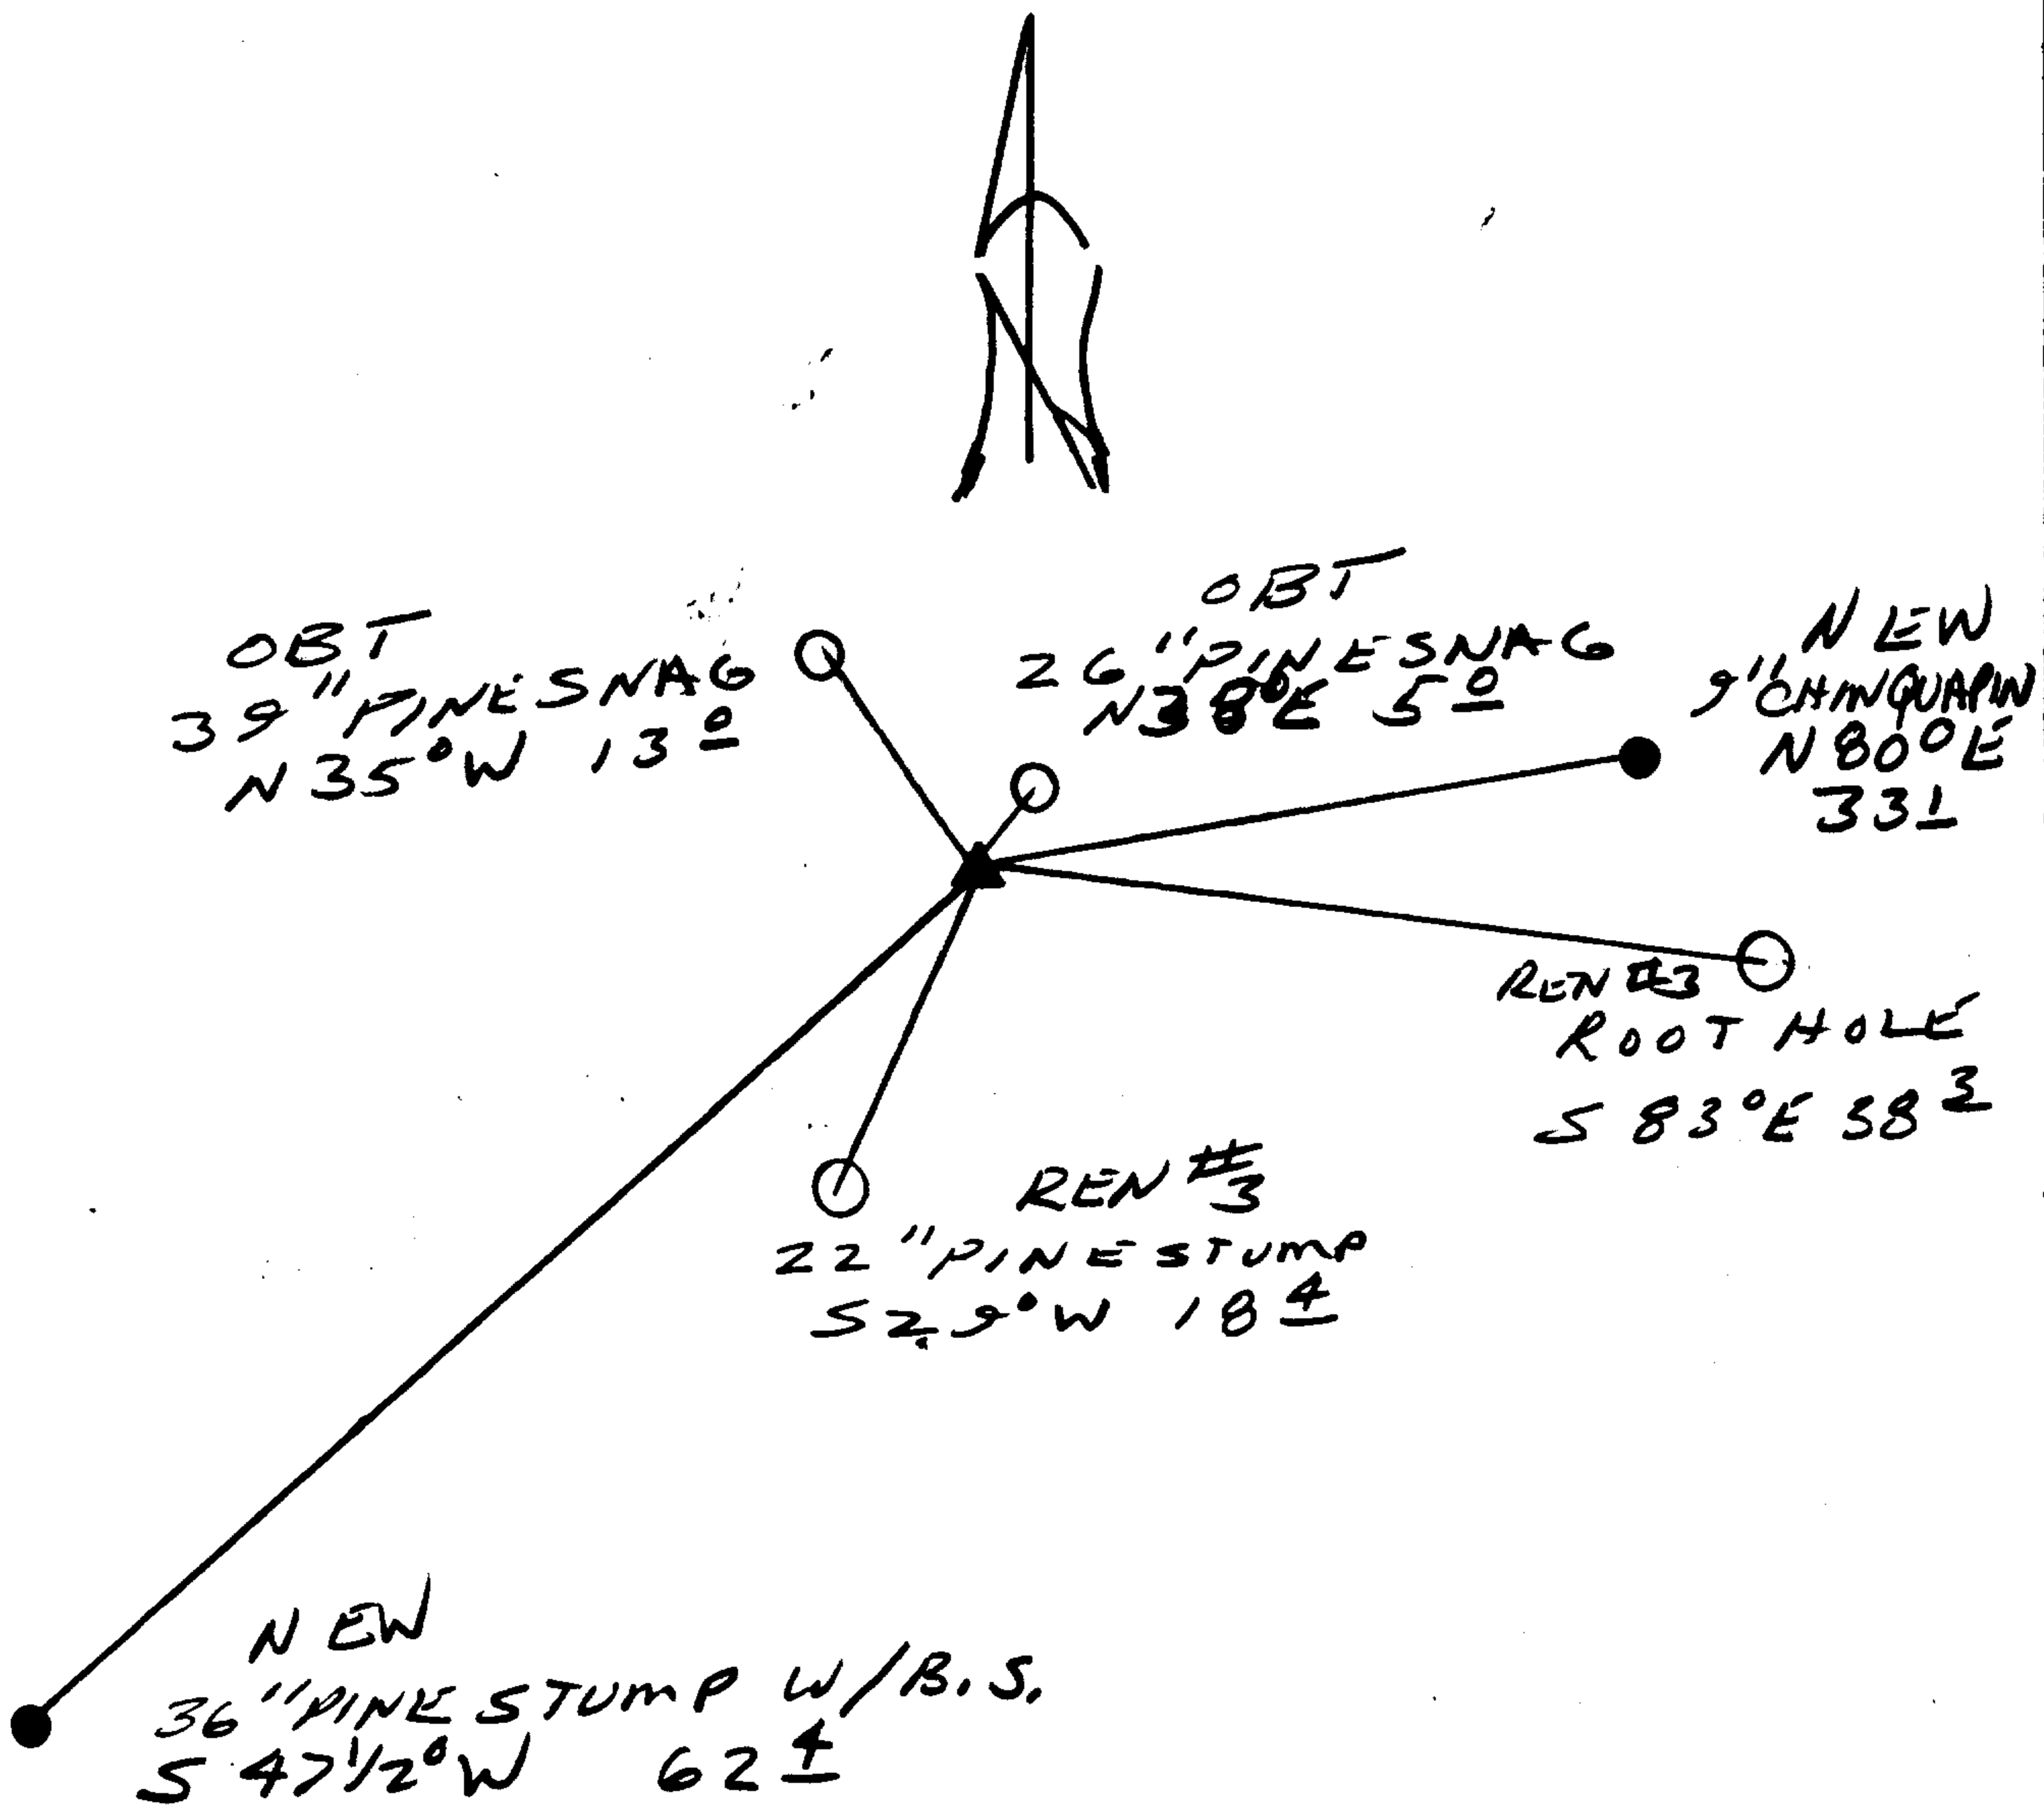

Location & Comments

OBT SNAGS AND REN #3 STUMP ARE IN GOOD SHAPE AREA IS LOGGED ONLY ONE SCRIBABLE TREE IN AREA.

Comp. Declin. 17 3/4° E
Agency DLSO
Party Chief RANDALL W SMITH
Notekeeper
Witnesses STEPHEN J FLAUSSE

Address

Surveyor's Seal
REGISTERED PROFESSIONAL LAND SURVEYOR
Randall W Smith
EXPIRES 6-31-96
OREGON
JULY 25, 1990
RANDALL W. SMITH
2469