



RENEWAL

Monument Set (Procedure and Description)

Monument Detail


BC/IP RETURNED TO PLUMB POSITION.

N/A

New Accessories

- 26" DIA B. OAK DOUBLE BLAZED AND SCRIBED "Y4S 29 CS BT" BEARS N 10° W, 48.4 FT
- 6" DIA. MADRONE BARK SCRIBED "Y4S 32 CS BT" BEARS S 49° E, 14.4 FT (BRG + DIST TAKEN TO ROOT CROWN)
- 21" DIA. D. FIR DOUBLE BLAZED AND SCRIBED "Y4S 29 CS BT" BEARS N 73° W, 183 FT
- 24" DIA. B. OAK DOUBLE BLAZED AND SCRIBED "Y4S 32 CS BT" BEARS S 55° E, 90.9 FT

Sketch of Monument, Accessories, and General Area

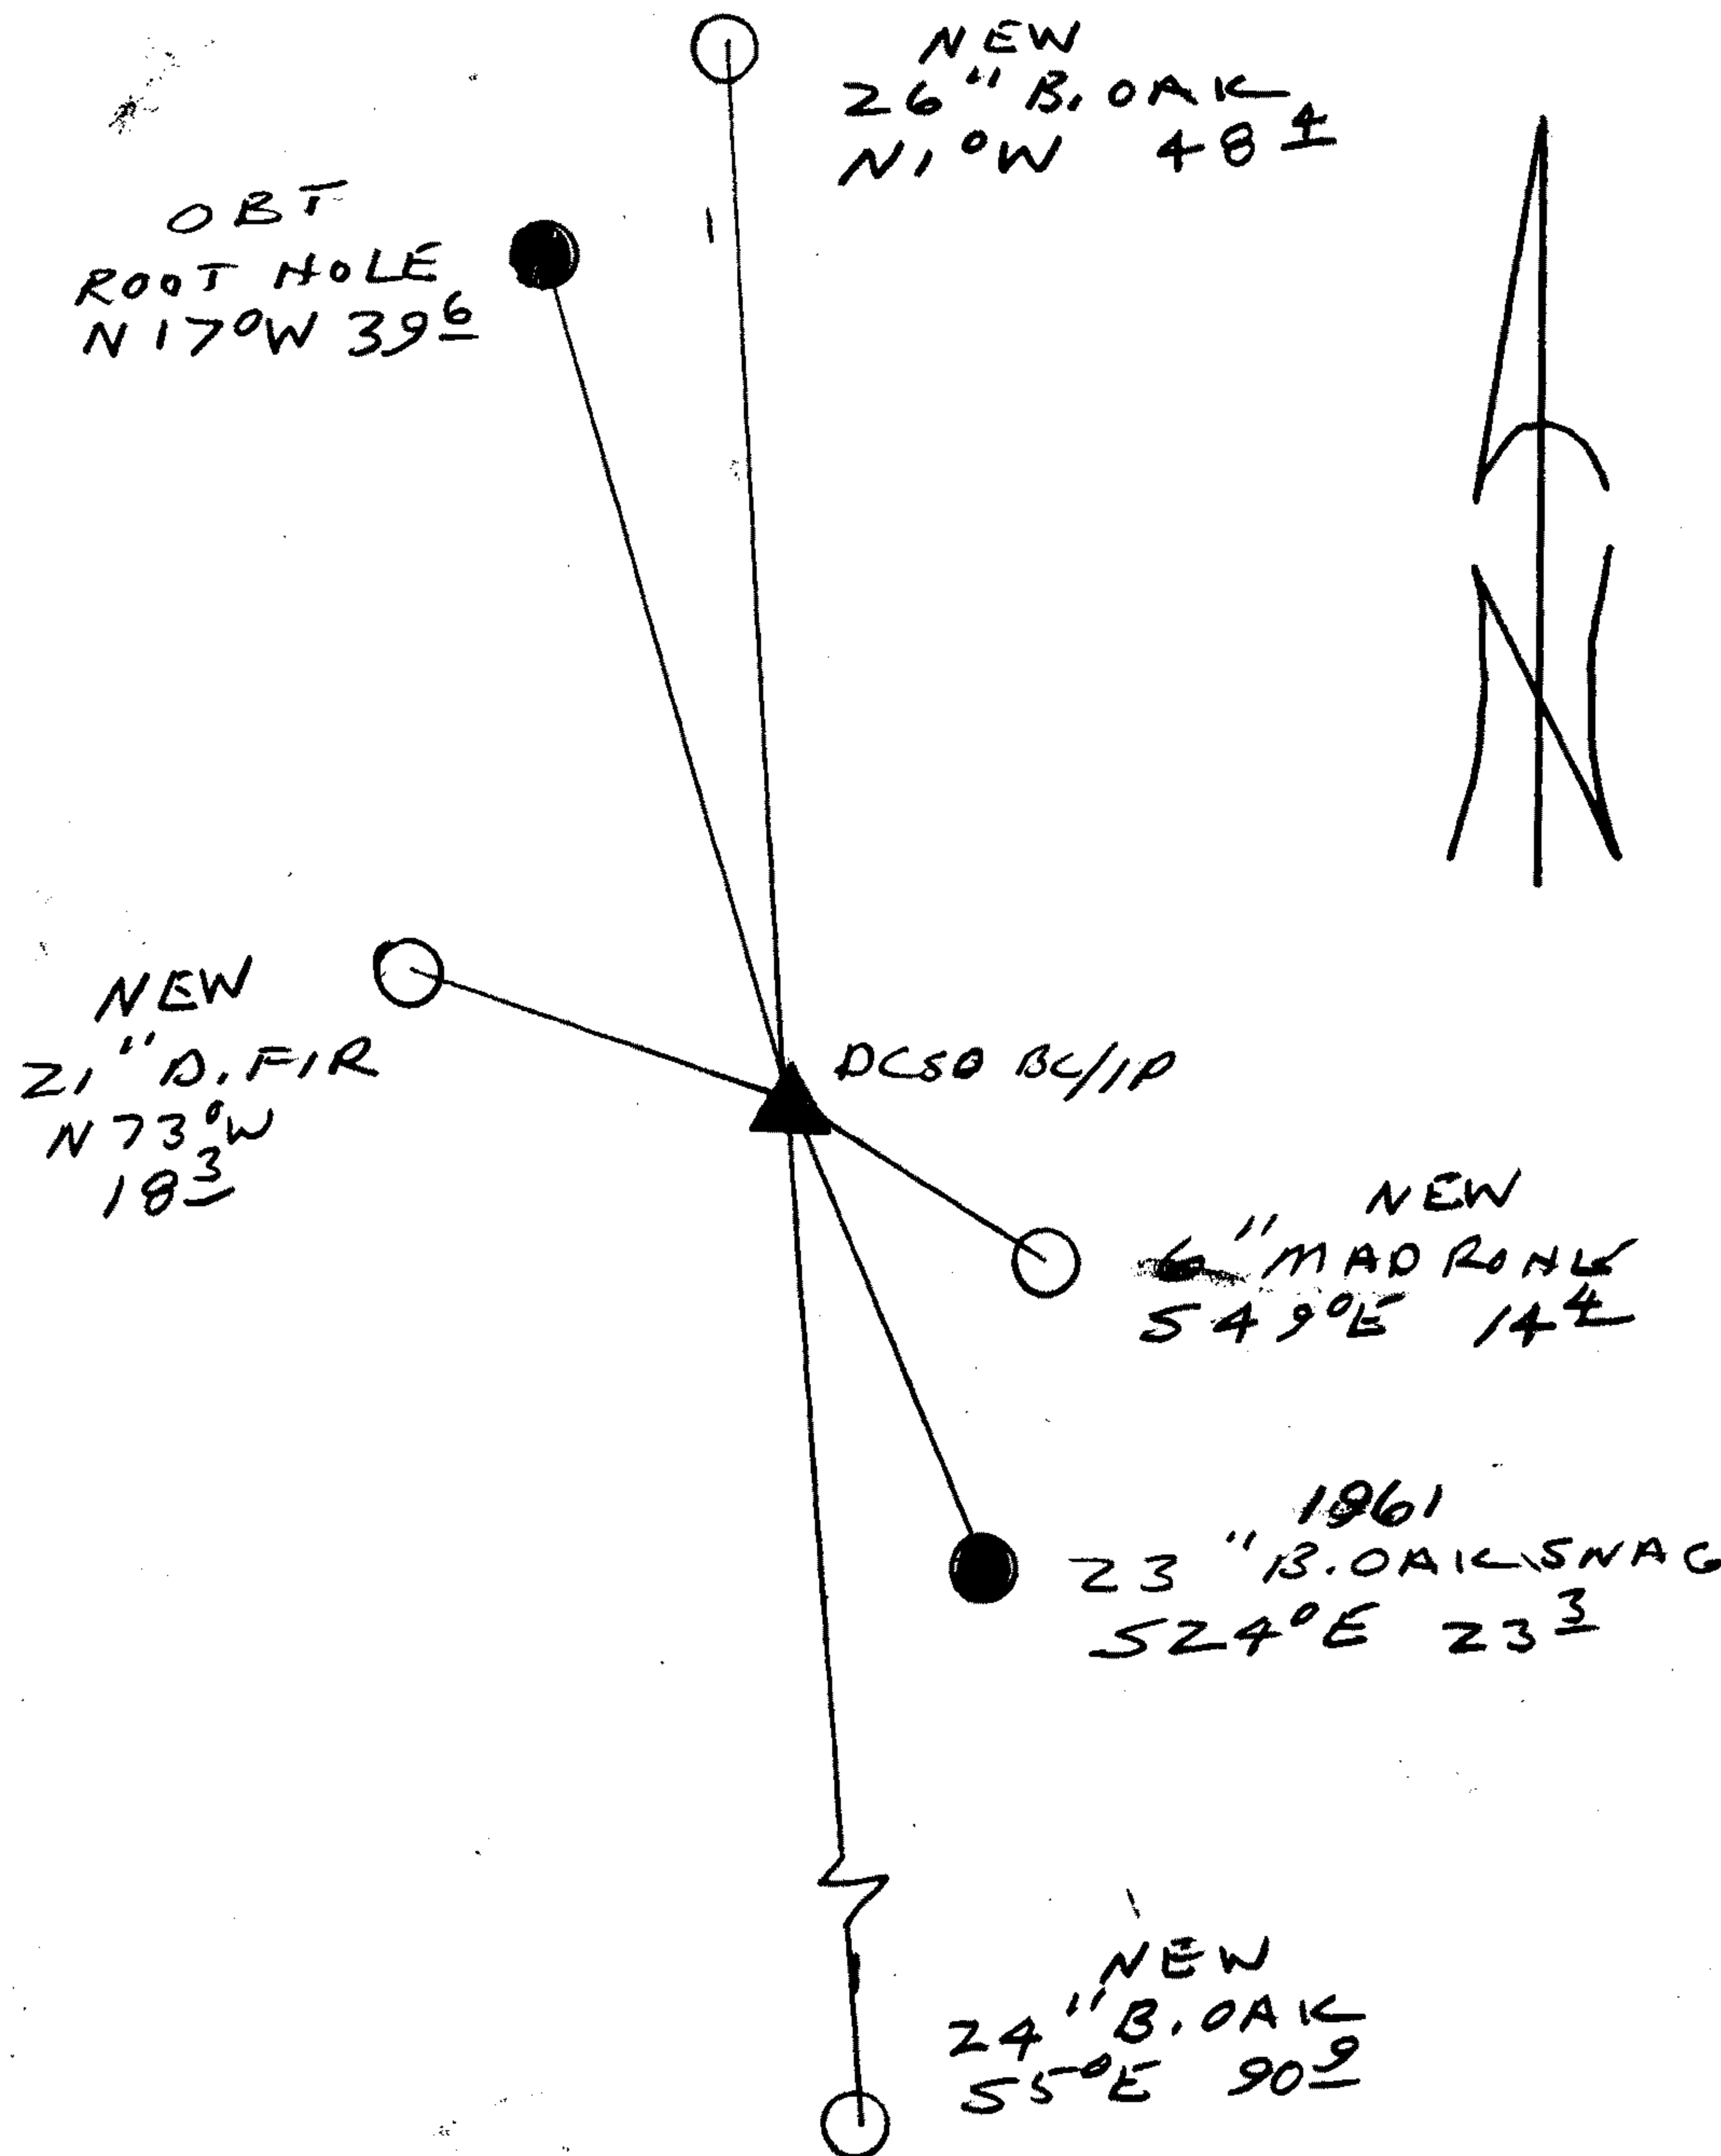

Location & Comments

Comp. Declin. 17 3/4° E  
 Agency DCSO  
 Party Chief RANDALL W SMITH  
 Notekeeper Randall W Smith  
 Witnesses STEPHEN J FLAISE

Address

Surveyor's Seal

REGISTERED PROFESSIONAL LAND SURVEYOR

*Randall W Smith*  
EXPIRES 6-31-96

OREGON  
JULY 25, 1990  
RANDALL W. SMITH  
2469