

GOVERNMENT CORNER RESTORATION FORM

Date: 9/27/95 By: PSC

This survey consists of: \_\_\_\_\_

Township 25S Range 2W Sec. 19 County DOUGLAS Map: \_\_\_\_\_

State OR Date 4-2-95 No. \_\_\_\_\_

North of: \_\_\_\_\_

Corner Ref: 64/63<sub>3</sub>

Corner Designation

1/4 S19

DOUGLAS COUNTY

SURVEYOR

Condition Report Only

Not Found

Renewed

Unrecorded

Surveyed In

Referenced Out

MONUMENT DETAIL

Previous Renewals 1943 GLO, 1966 DCSG

Monument(s) Found: (Condition and Source)

2 1/2" DIA GLO BRASS CAP ON A  
1" O.D. IRON PIPE, PROTRUDES  
11" ABOVE GROUND. (1943 GLO)

U.S. GENERAL LAND OFFICE

1/4 S19

1943  
SURVEY

Accessories Found:

32" NOW 36" DIA 2 FT HIGH D.FIR STUMP WITH A FULLY  
HEALED BLAZE, BEARS N22°E, 36.3 FT (AGREES WITH REC)  
1943 GLO

30" NOW 33" DIA. D.FIR WITH A FULLY HEALED SINGLE BLAZE,  
BEARS S23°E, 27.7 FT (REC SIZE, 27.7 FT)  
1943 GLO

6" NOW 11" DIA. HEMLOCK WITH A FULLY HEALED DOUBLE  
BLAZE BEARS N88°E, 39.1 FT (REC N89°E, 39.1 FT)  
1966 DCSG

1966 DCSG SE BT NOW GONE.

RENEWAL

Monument Set (Procedure and Description)

Monument Detail

N/A


N/A

New Accessories

10" HEMLOCK SINGLE BLAZED AND SCRIBED "1/4 S 19 CS BT"  
ON A LOW BLAZE (NOTE UPPER TRUNK IS SCARED) BEARS  
N 47° E, 4.7 FT

4" DIA D. FIR DOUBLE BLAZED AND SCRIBED "X BT" BEARS  
S 76° E, 18.3 FT.

Sketch of Monument, Accessories, and General Area

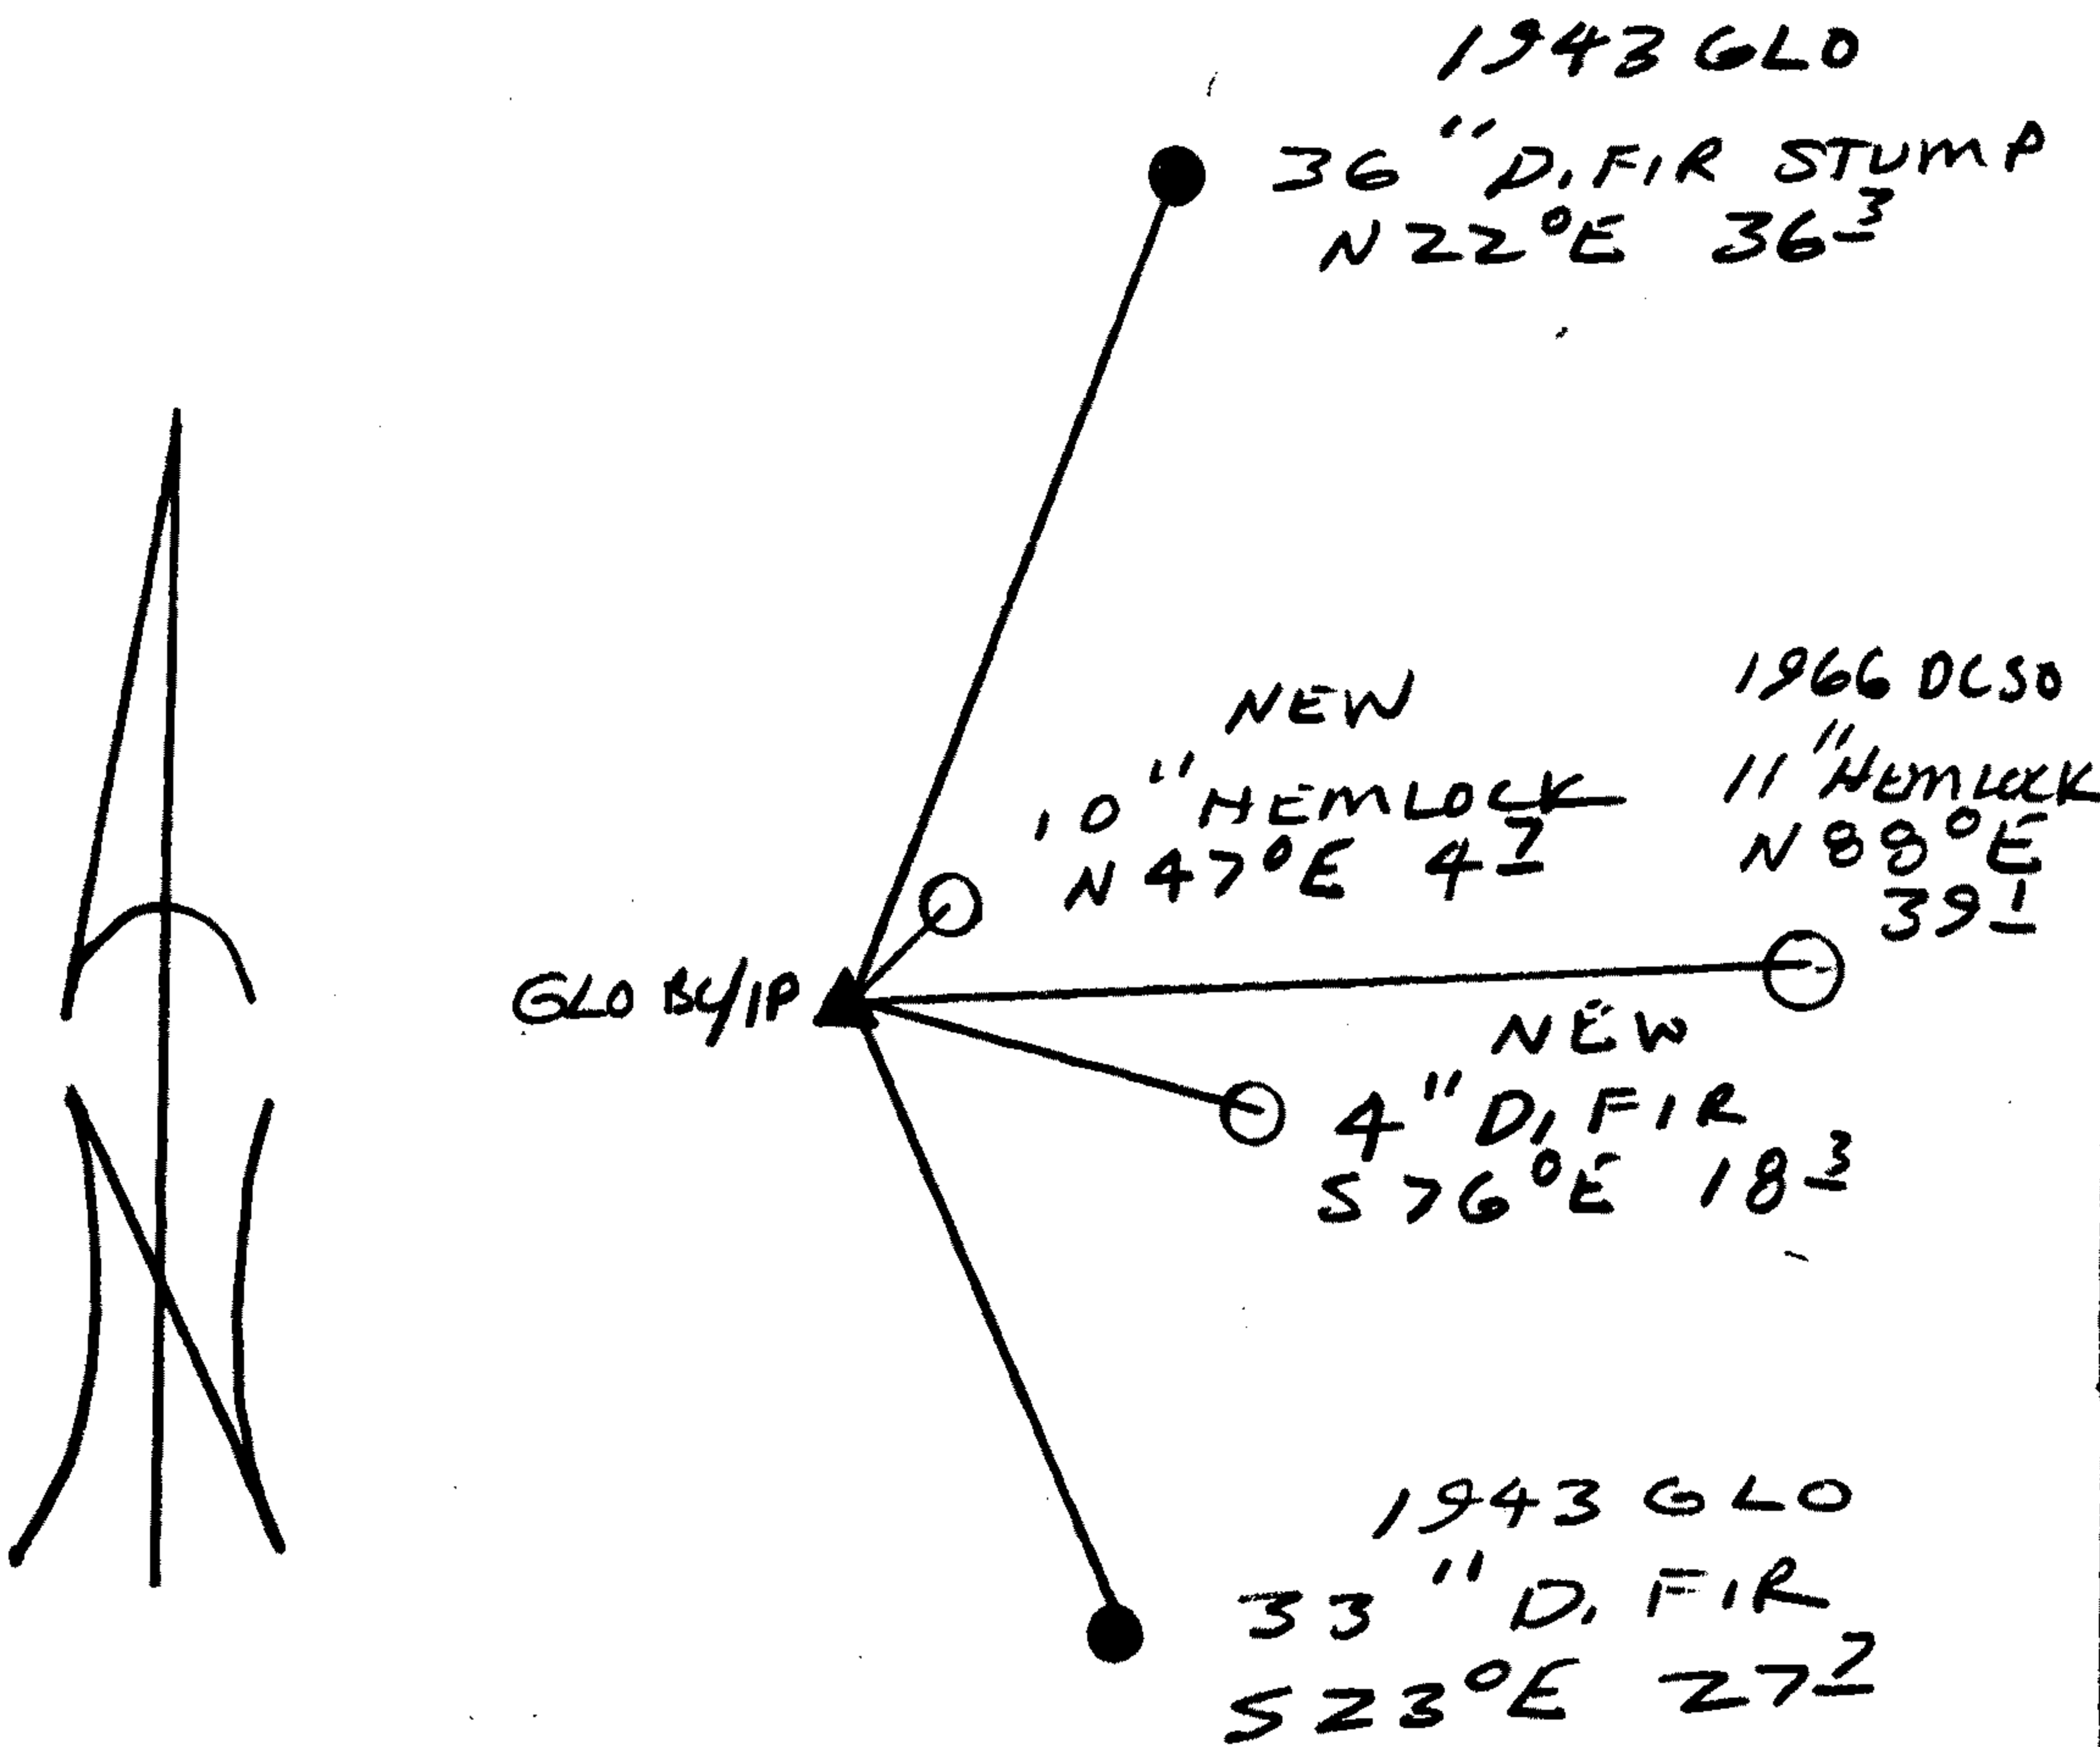

Location & Comments

6' x 4' x 4' BOULDER 1 FT  
WEST OF BC/IP

Comp. Declin. 17 3/4° E  
Agency DCSO  
Party Chief RANDALL W. SMITH  
Notekeeper Randall W. Smith  
Witnesses STEPHEN J. FRAUSE

Address

Surveyor's Seal

REGISTERED  
PROFESSIONAL  
LAND SURVEYOR

*Randall W. Smith*  
EXPIRES 6-31-96

OREGON  
JULY 25, 1990  
RANDALL W. SMITH  
2469