

GOVERNMENT CORNER RESTORATION FORM

Date: 9/28/95 By: PC
This survey consists of:
Map: _____
Narrative: _____
Corner Rpt: 64/63-4

Township 25S Range ZW Sec. 16 County DOUGLAS
State OR Date 4-4-95 No. _____

Corner Designation

1/4 S16
1/4 S21

DOUGLAS COUNTY SURVEYOR

- Condition Report Only
- Not Found
- Renewed
- Unrecorded
- Surveyed In
- Referenced Out

Previous Renewals REN # 8, # 41, 1962 BLM

Monument(s) Found: (Condition and Source)

2 1/2" DCSO BRASS CAP ON A 1 1/2" QD. IRON PIPE PROTRUDES 7" ABOVE GROUND (REN # 8)

NOTE:
BRASS CAP IS ORIENTATED NORTHEAST AND IS SURROUNDED BY A 2 1/2 FT DIA. MOUND OF STONE.
FOUND ORIG. STONE LAYING ON SIDE MEASURES 20" X 14" X 8" WITH MARKS " 1/4" FOUND. BEARS N 41° W 1.2 FT FROM BL/P. BRG AND DIST TAKEN TO CENTER OF STONE.

COUNTY SURVEYORS
T 25S
1/4 S16 / S21
R 2W BLM
OFFICE 1962

Accessories Found:

16" NOW 20" DIA 2 1/2 FT HIGH ROTTEN D. FIR STUMP WITH SCRIBING VISIBLE " S 21" BEARS S 39° E 17.1 FT (AGREES WITH REN # 8). ORIG. BE IS S 39° E, 19.1 FT 10 BT

24" NOW 33" DIA CEDAR WITH AN UNHEALED BLAZE NO SCRIBING VISIBLE WE RESCRIBE ~~ON THE~~ PREVIOUSLY UNBLAZED PORTION OF TRUNK

DOUBLE BLAZE AND RESCRIBE " 1/4 STICKS BT" BEARS S 34 1/2° W, 223.5 FT (AGREES WITH REN # 8) REN # 8

22" NOW 35" DIA CEDAR WITH A FULLY HEALED DOUBLE BLAZE BEARS N 57° E, 64 FT (REN # 41 REC. N 57° E, 65.0 FT) REN # 41

EVIDENCE OF ORIG. NE BT NOW GONE

RENEWAL

Monument Set (Procedure and Description)

Monument Detail

N/A

N/A


New Accessories

10" DIA. D. FIR DOUBLE BLAZED AND SCRIBED "1/4 521 CS BT"
BEARS S 41° W, 26.8 FT

15" DIA. D. FIR DOUBLE BLAZED AND SCRIBED "1/4 516 CS BT"
BEARS N 29° E, 28.6 FT

Sketch of Monument, Accessories, and General Area

Location & Comments

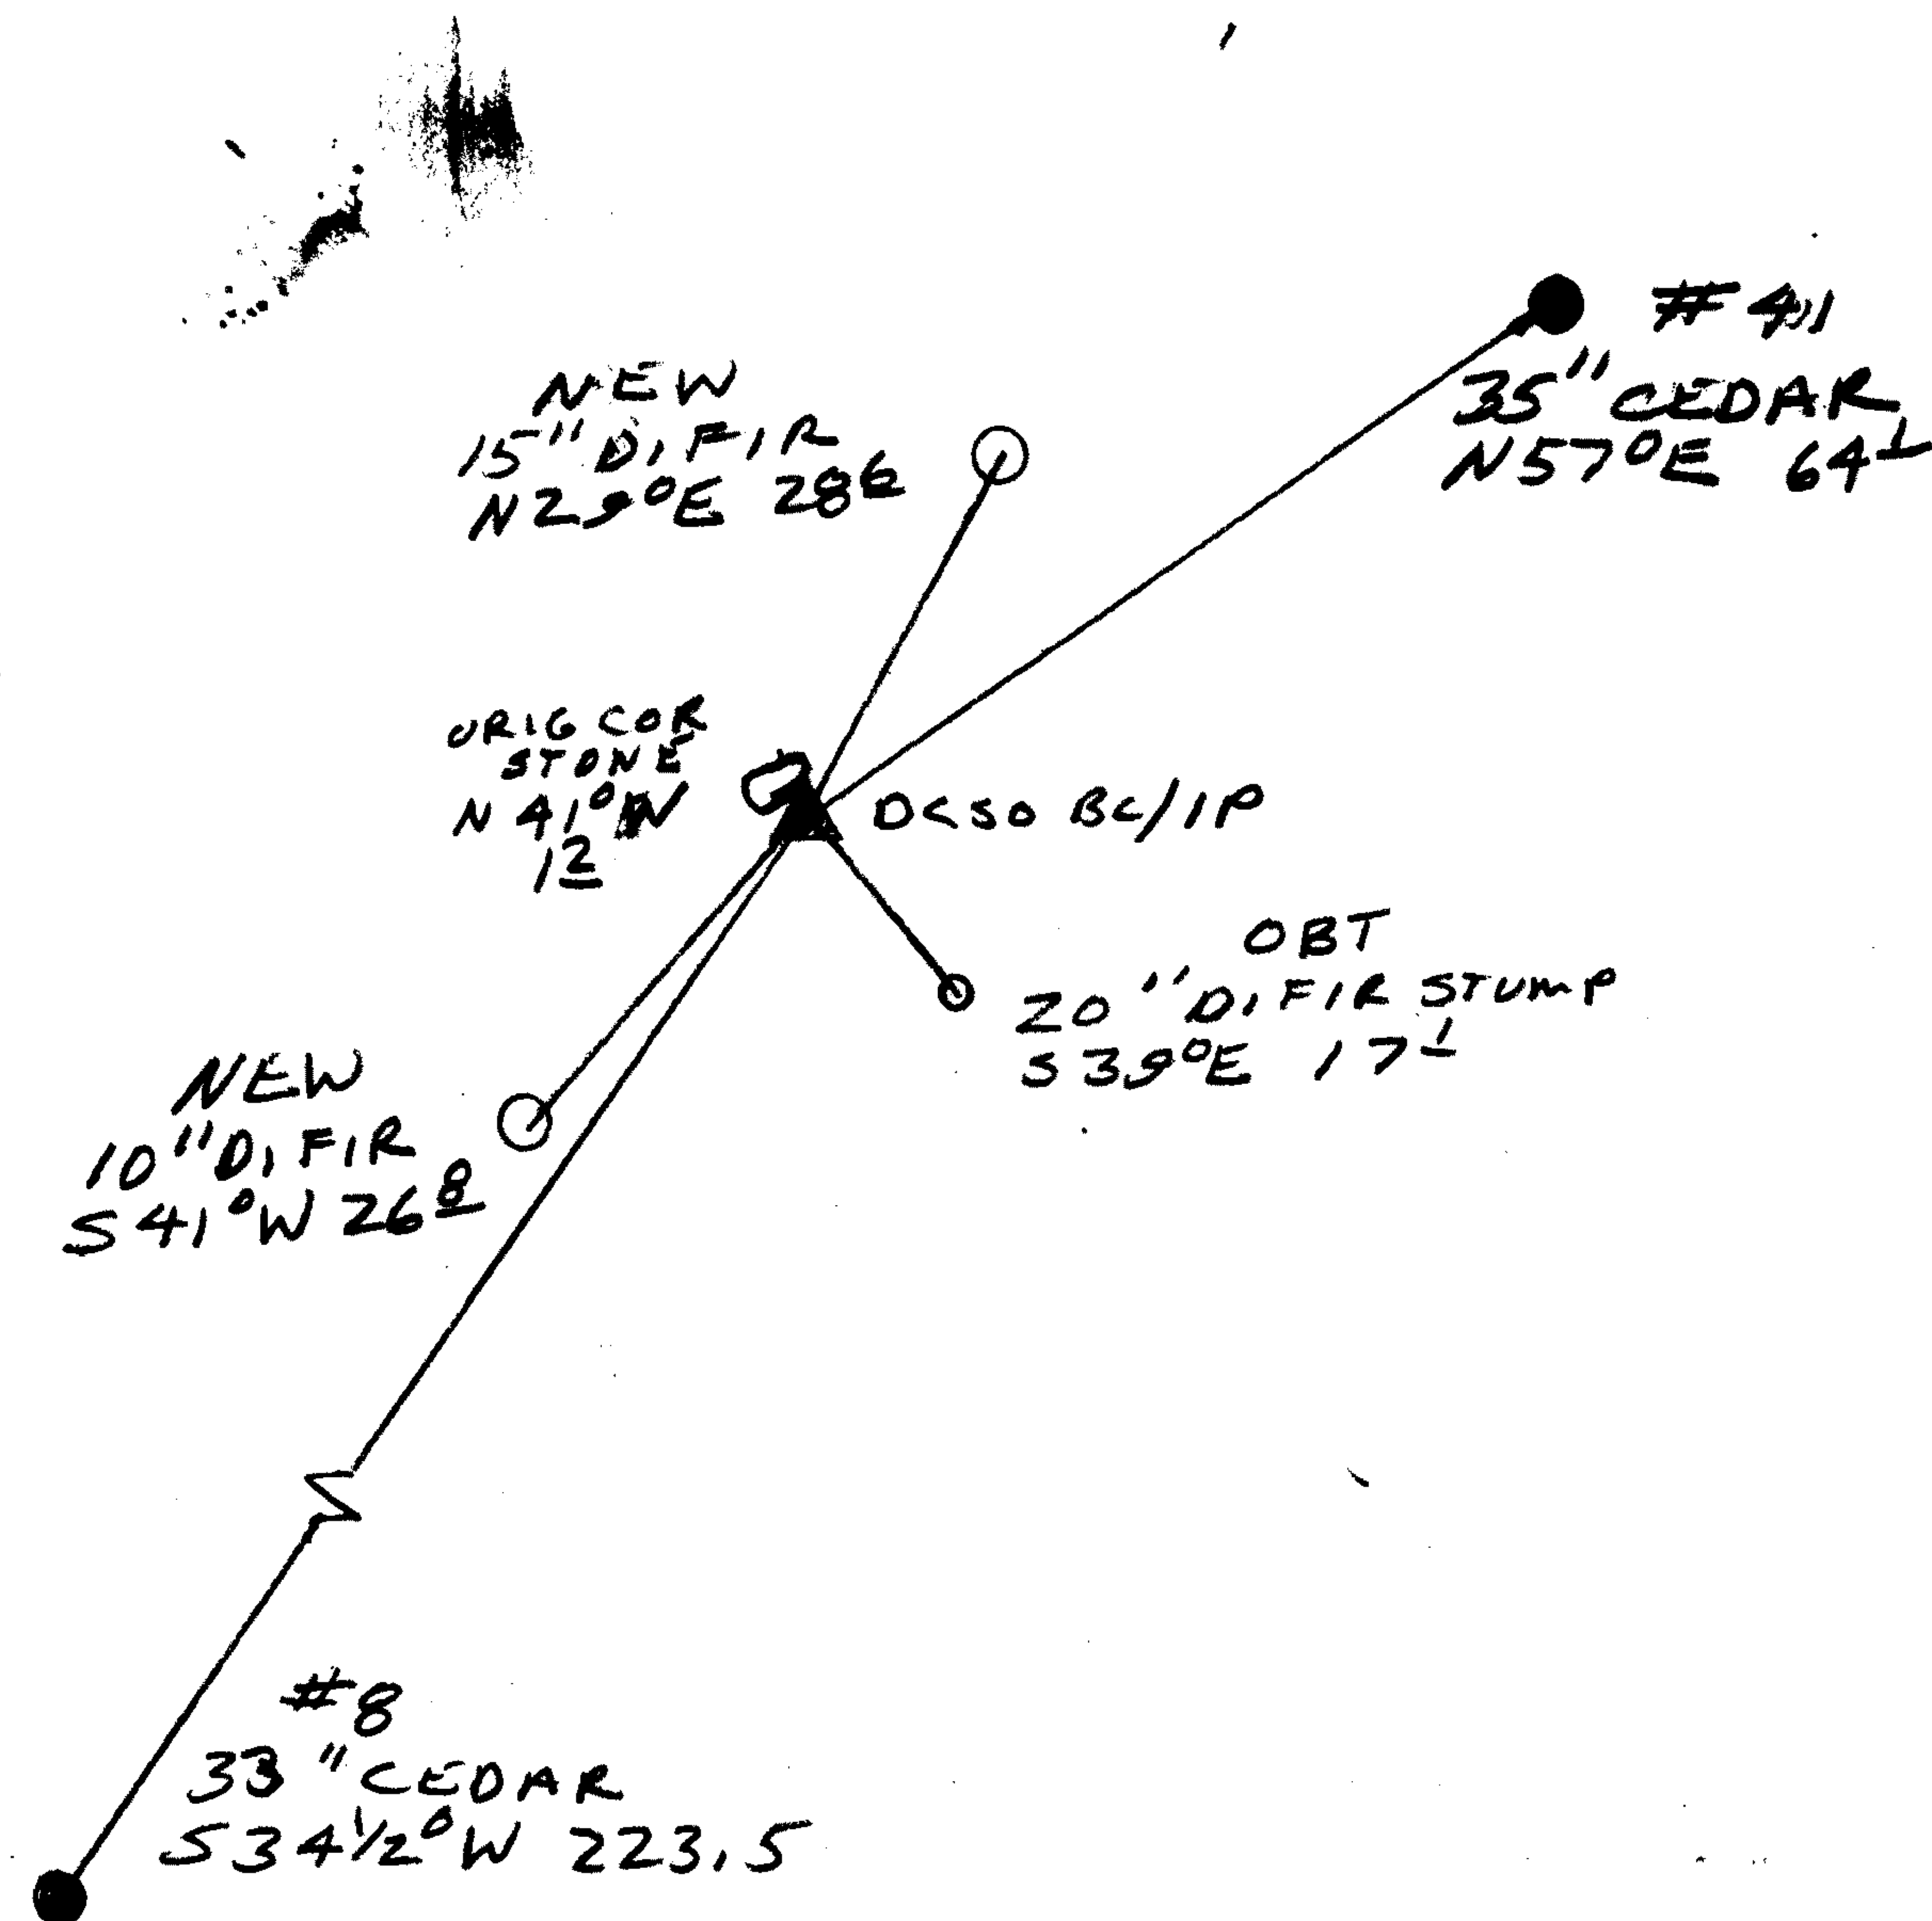

Comp. Declin. 17 3/4° E
 Agency DCSO
 Party Chief RANDALL W. SMITH
 Notekeeper Randall W. Smith
 Witnesses STEPHEN J. FLAUSK

Address

Surveyor's Seal

REGISTERED PROFESSIONAL LAND SURVEYOR
 Randall W. Smith
 EXPIRES 6-31-96
 OREGON
 JULY 25, 1990
 RANDALL W. SMITH
 2469