

RENEWAL

Monument Set (Procedure and Description)

Monument Detail

NONE

N/A


New Accessories

DOUBLE TRUNKED W. OAK DOUBLE BLAZED AND SCRIBED "Y4S16CSBT" ON 13" DIA. WEST TRUNK, BEARS N63°E, 43.5 FT TO ROOT CROWN OF WEST TRUNK.

7" DIA. W. OAK DOUBLE BLAZED AND SCRIBED "Y4S21CSBT" BEARS S86¼°W, 89.3 FT.

Sketch of Monument, Accessories, and General Area

Location & Comments

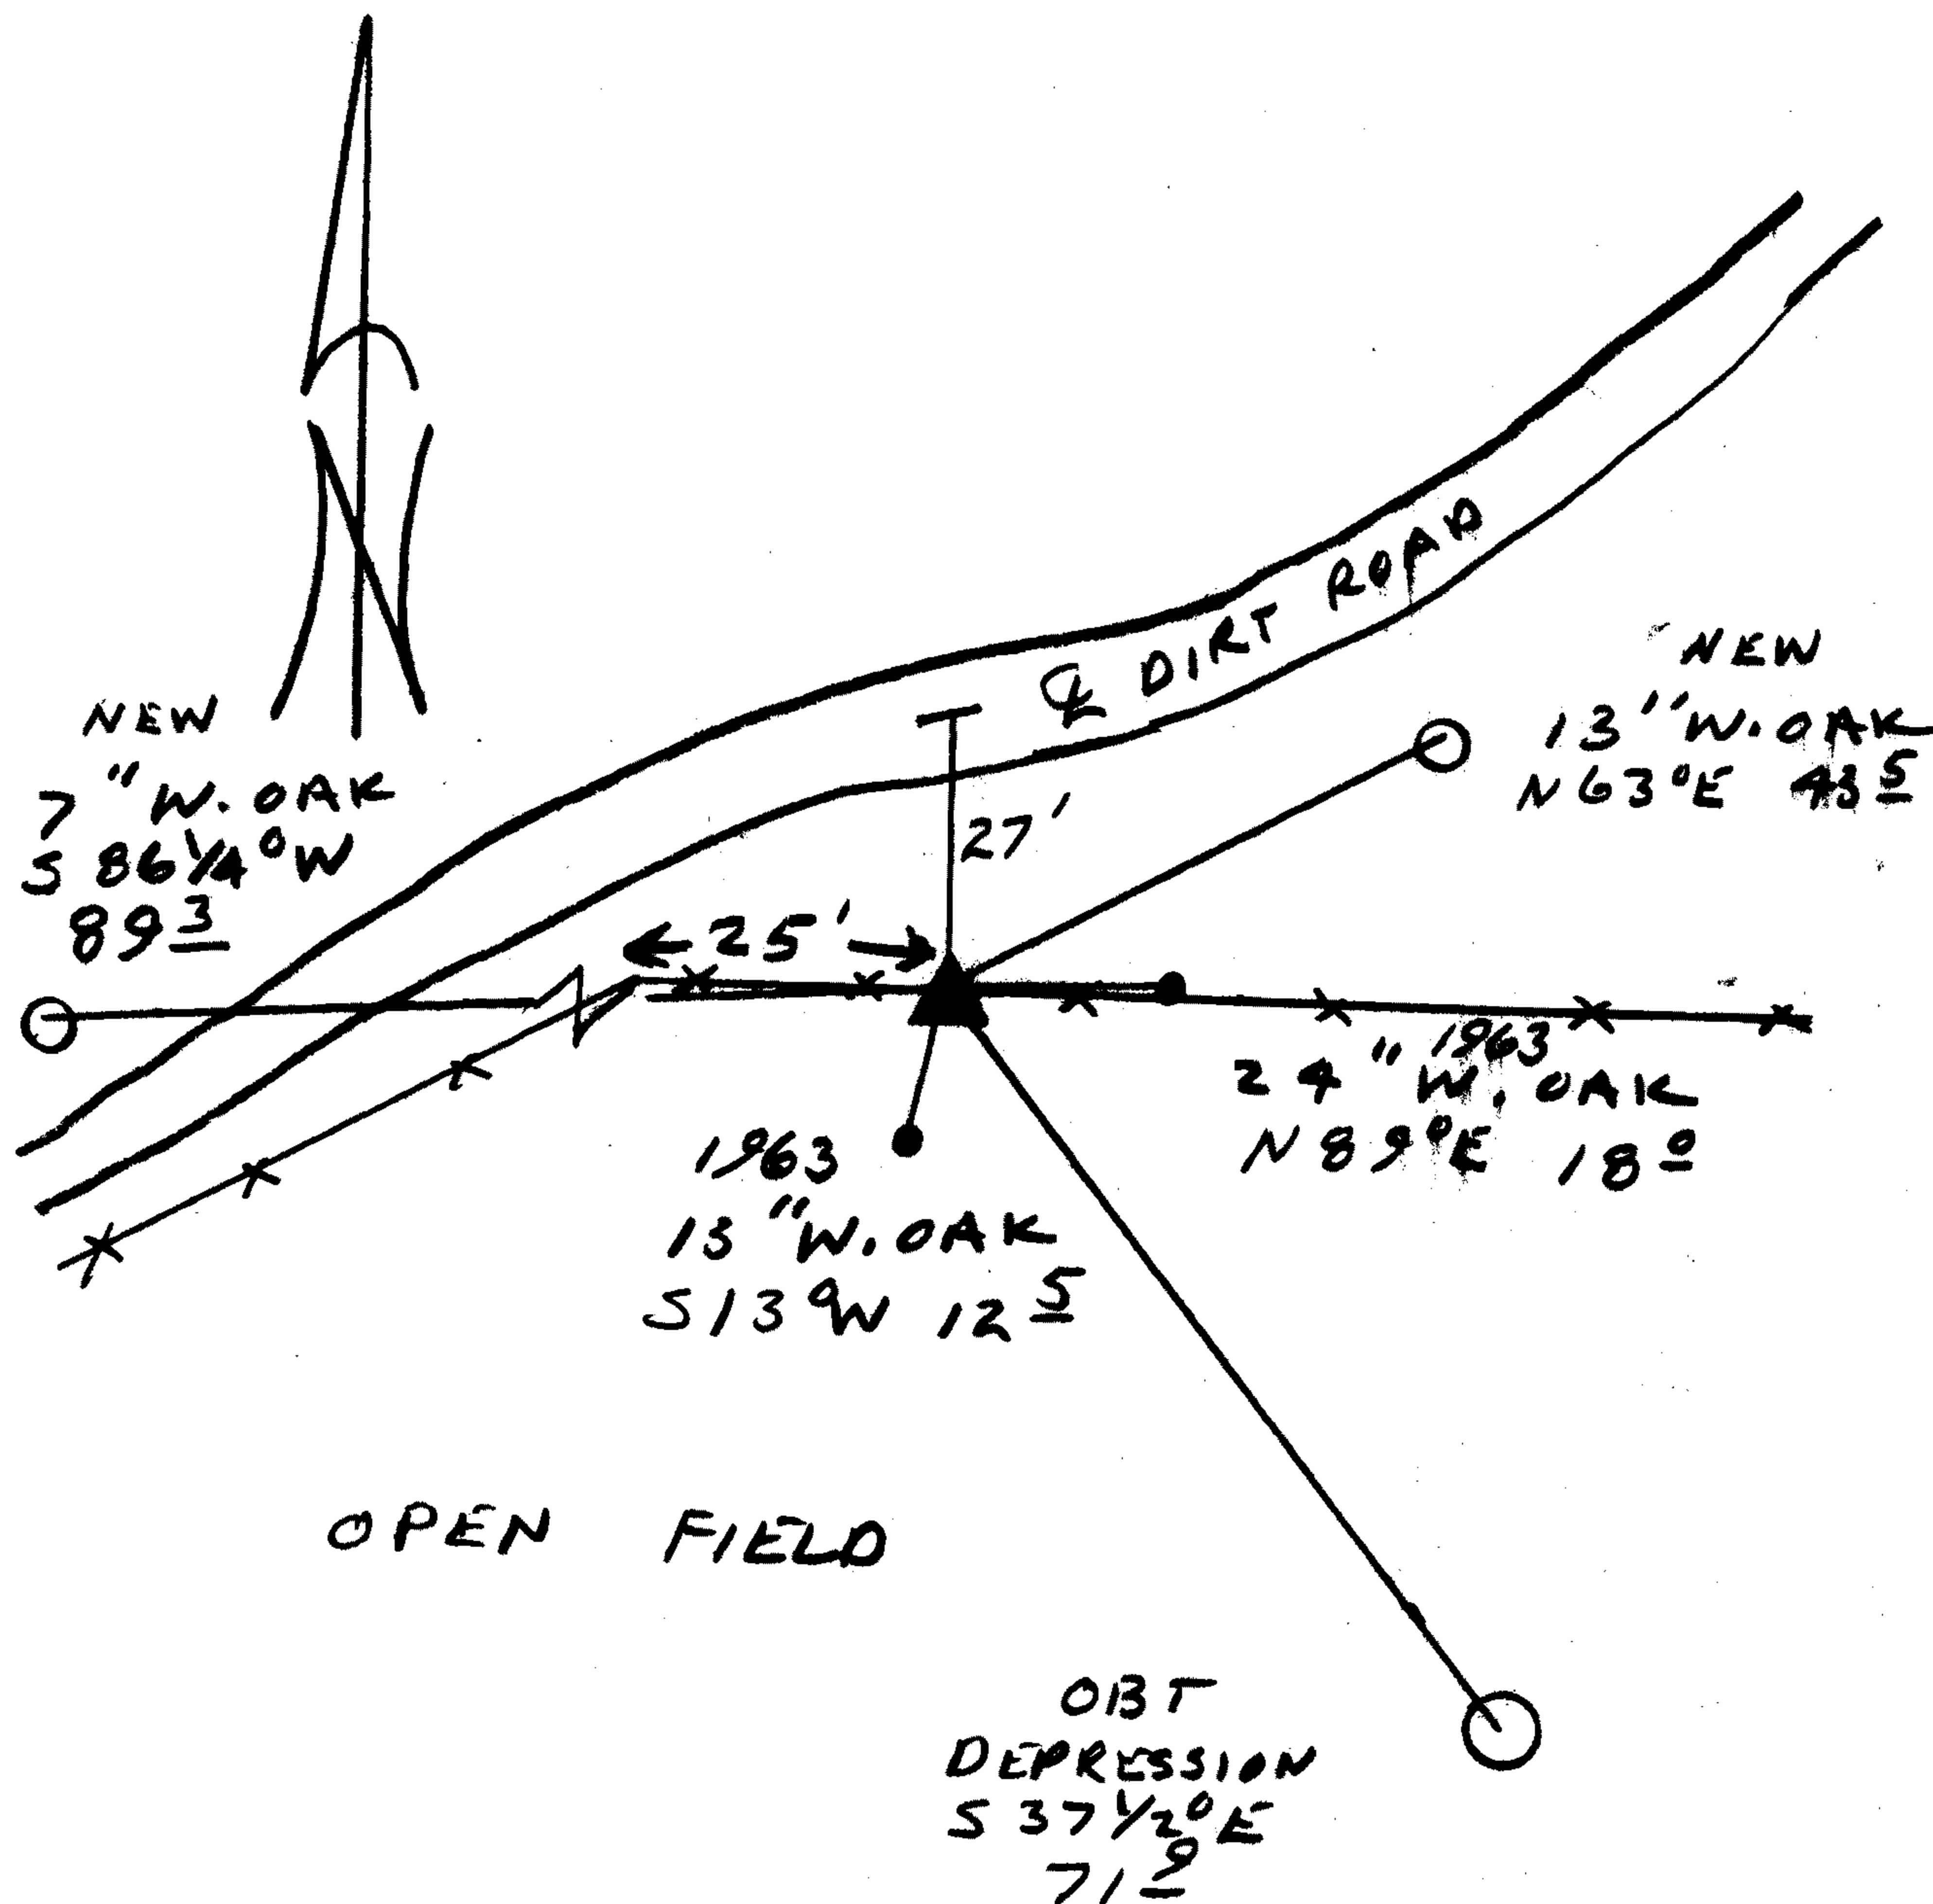

Comp. Declin. 17¾°E
 Agency DCSO
 Party Chief RANDALL W SMITH
 Notekeeper Randall W Smith
 Witnesses STEPHEN J FLAUS

Address

Surveyor's Seal

REGISTERED
 PROFESSIONAL
 LAND SURVEYOR

Randall W Smith
 EXPIRES 6-30-96

OREGON
 JULY 25, 1990
 RANDALL W. SMITH
 2469