

RENEWAL

Monument Set (Procedure and Description)

2 3/8" DIA. DC30 BRASS CAP ON A
 1 3/8" O.D. BY 32" LONG IRON PIPE
 IS SET AT RECORD BEARING
 AND DISTANCE FROM REMAINING
 OBT. BE/IP PROTRUDES 6" ABOVE
 GROUND

Monument Detail

DOUGLAS COUNTY SURVEYORS

T 225


1/4 $\frac{57}{318}$ $\frac{R}{5W}$

1995
 OFFICE

New Accessories

- 8" DIA. MAPLE IN A CLUSTER OF MAPLES IS DOUBLE BLAZED AND SCRIBED "Y4S7CS BT" ON SOUTH WEST TRUNK OF MIDDLE FOUR TRUNKED GROUP, BEARS N 74 1/4° E, 101.7 FT TO CENTER OF SCRIBED TRUNK.
- 9" DIA. D. FIR DOUBLE BLAZED AND SCRIBED "Y4S7CS BT" BEARS N 7 1/2° W, 56° FT
- 3" DIA. D. FIR DOUBLE BLAZED AND SCRIBED "X BT" BEARS S 14° W, 59.7 FT
- 9" DIA. D. FIR DOUBLE BLAZED AND SCRIBED "Y4S18CS BT" BEARS S 53 1/2° E, 70.2 FT

Sketch of Monument, Accessories, and General Area

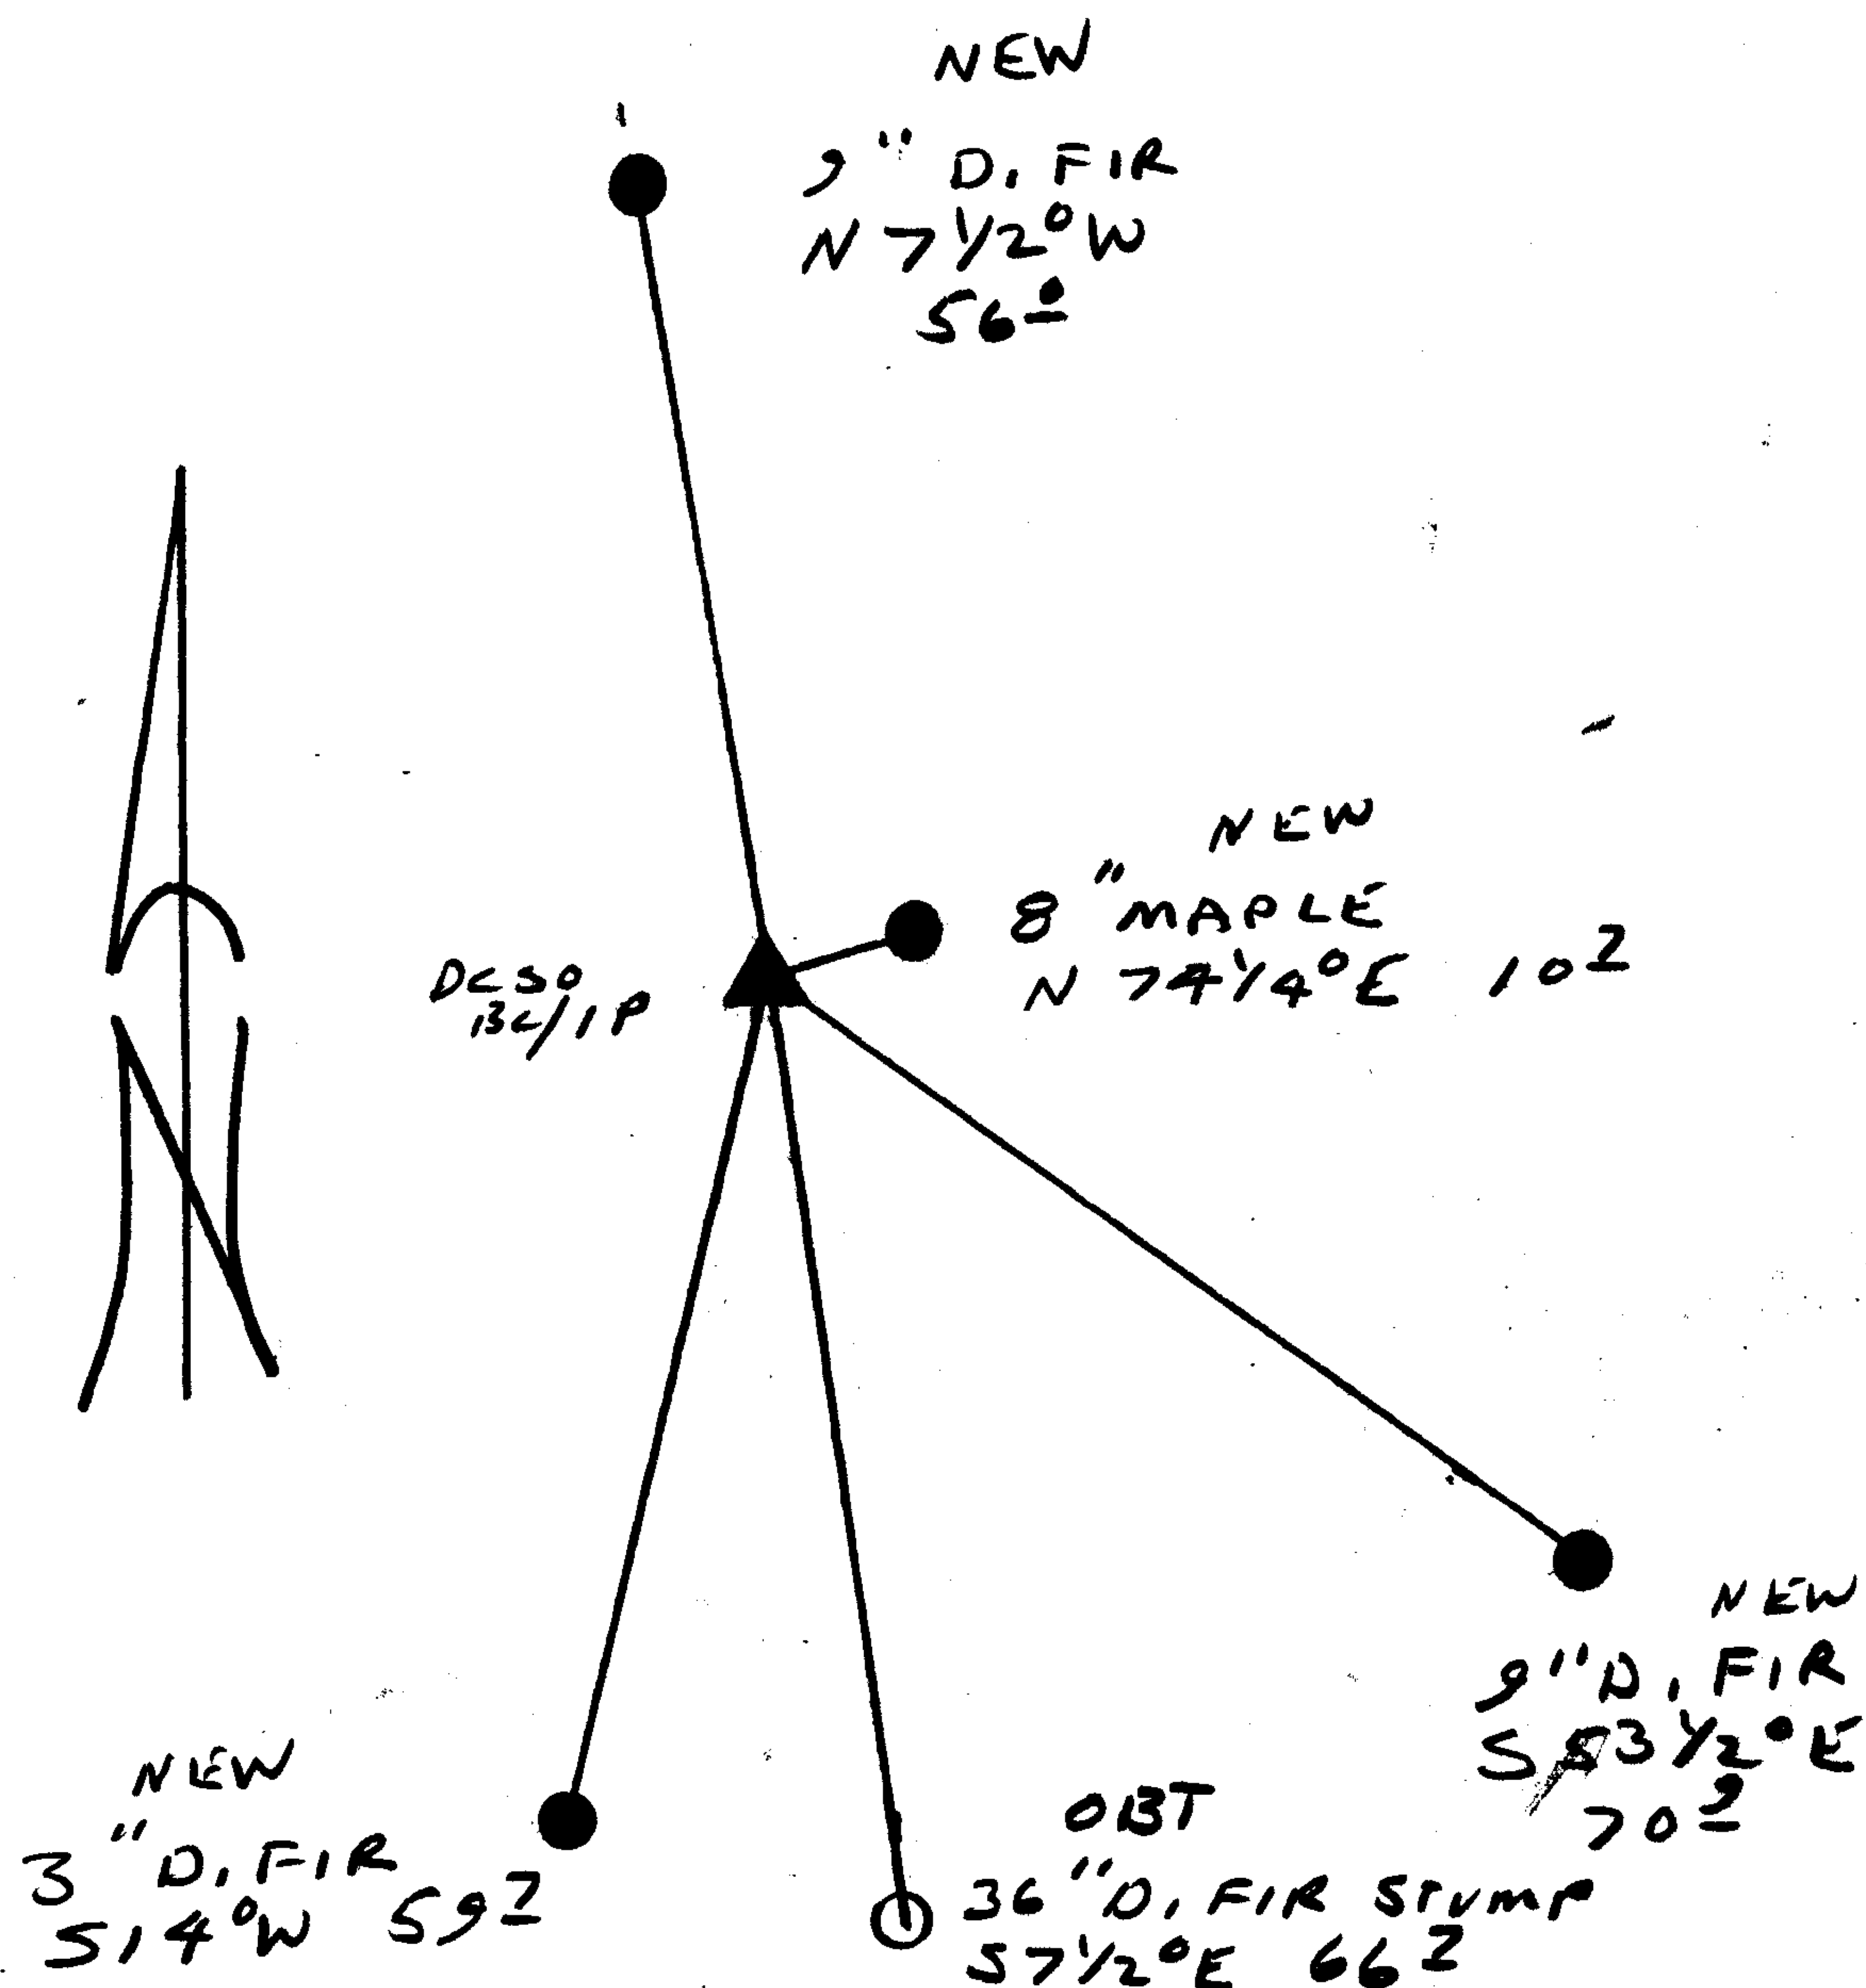

Location & Comments

HARVEY CHRISTENSEN RLS #2603
 FOUND ORIG. BT RECENTLY
 AND INFORMED DC30
 OF IT'S LOCATION

CORNER LIES ON STEEP
 EASTERLY SLOPE

Comp. Declin. 17 3/4° E
 Agency DC30
 Party Chief RANDALL W SMITH
 Notekeeper Randall W Smith
 Witnesses STEPHEN J FLAUSK

Address